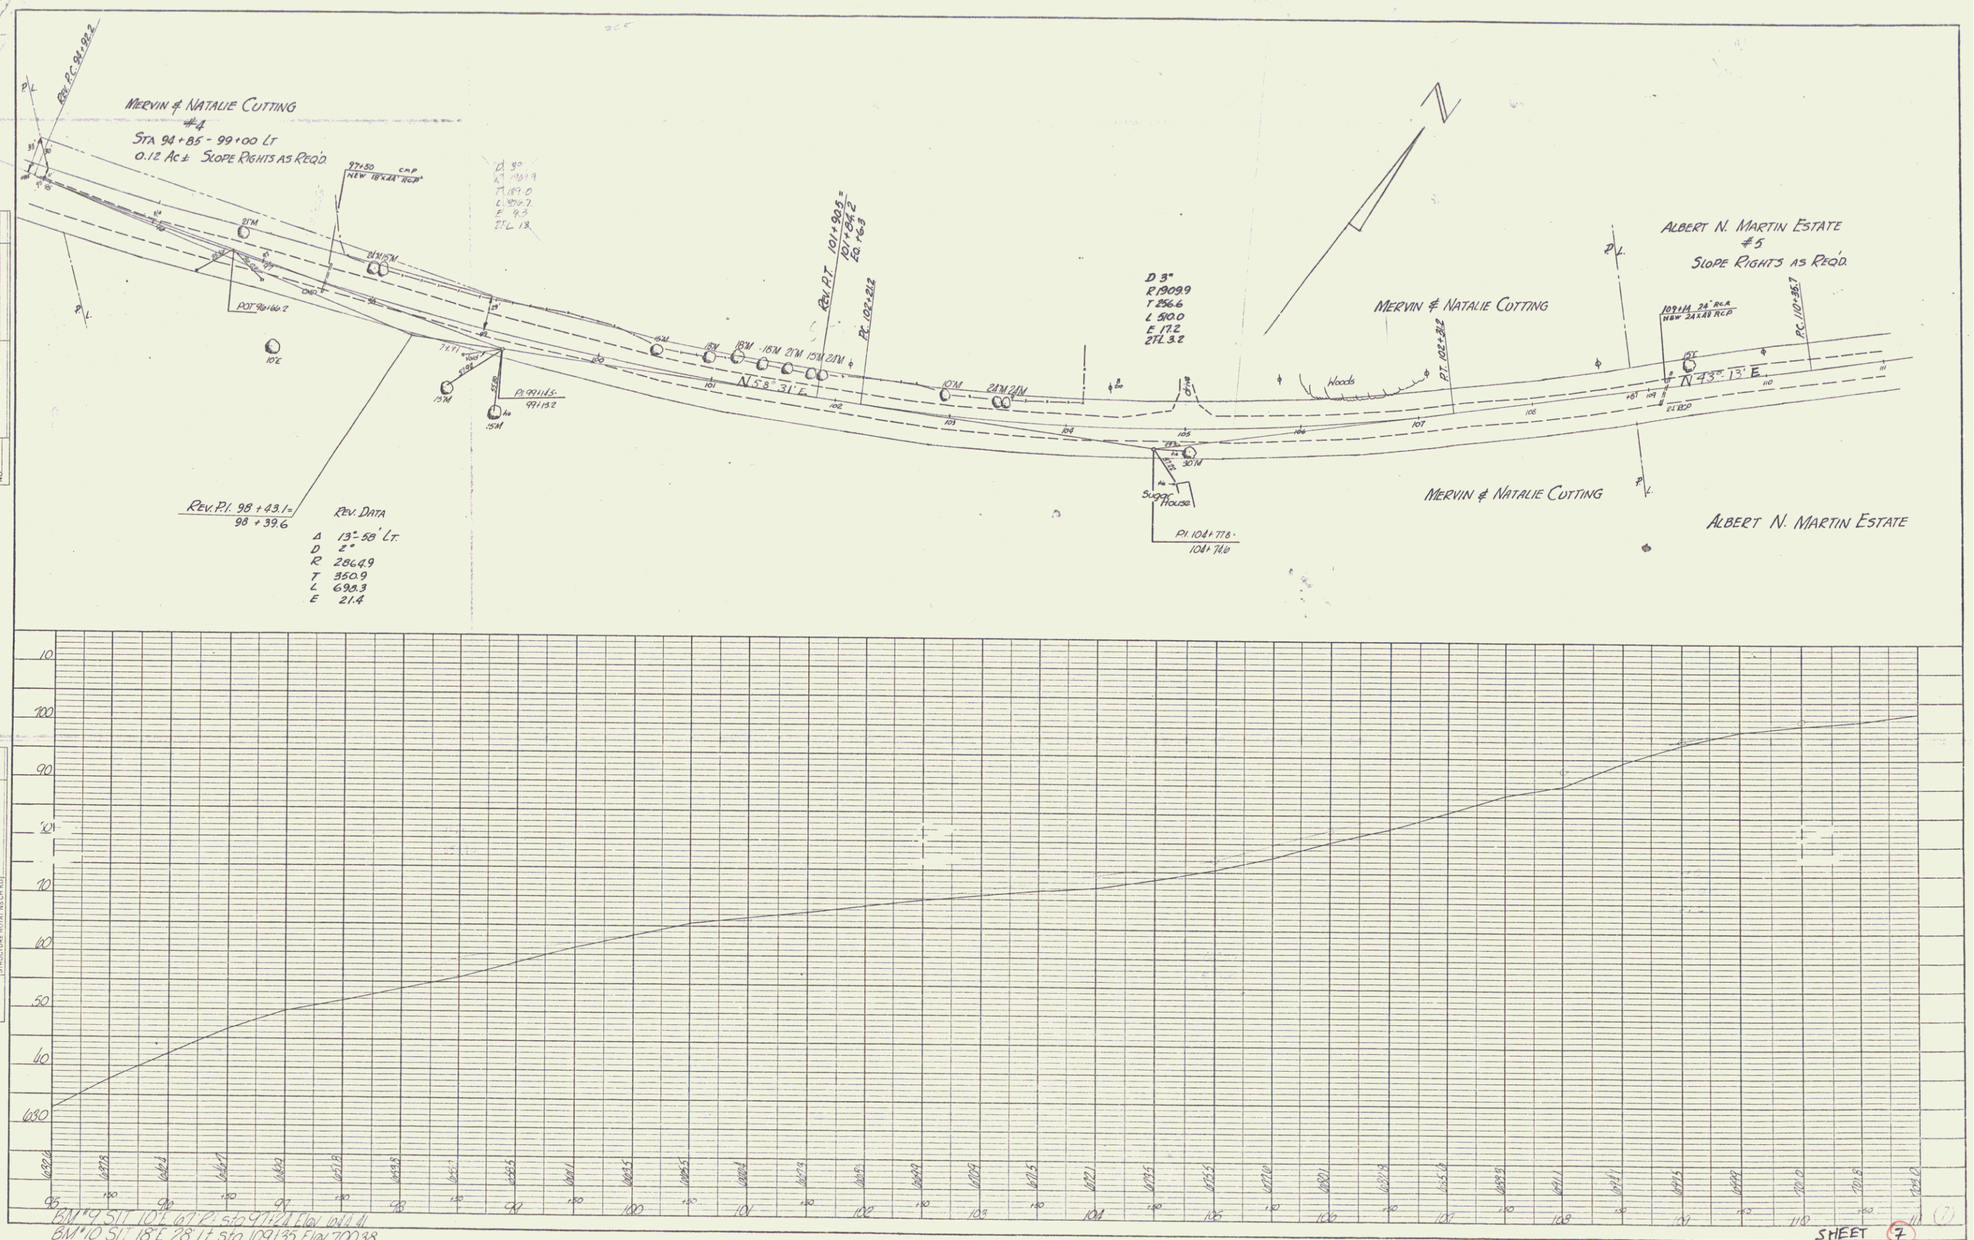

BM #9 SIT 101' 6" 12' sta 97+24 Elev 694.4
BM #10 SIT 18' E 28' Lt sta 109+35 Elev 700.38

PLAN — SURVEYED: PLOTTED: ALIGNMENT CHECKED: PT. OF WAY CHECKED: BY: Cameron Camargo DATE: Apr 55 Mar 55 NOTE BOOK: NO.

PROFILE — SURVEYED: PLOTTED: GRADE CHECKED: STRUCTURE NOTATIONS CHKD: BY: DATE: NOTE BOOK: NO.

PLATE 1 - PLAN - PROFILE G.P.R.& R.E. STANDARD
KEUFFEL & ESSER CO., NEW YORK
K & E Co. No. 345-1

SHEET 7

WATERVILLE 7