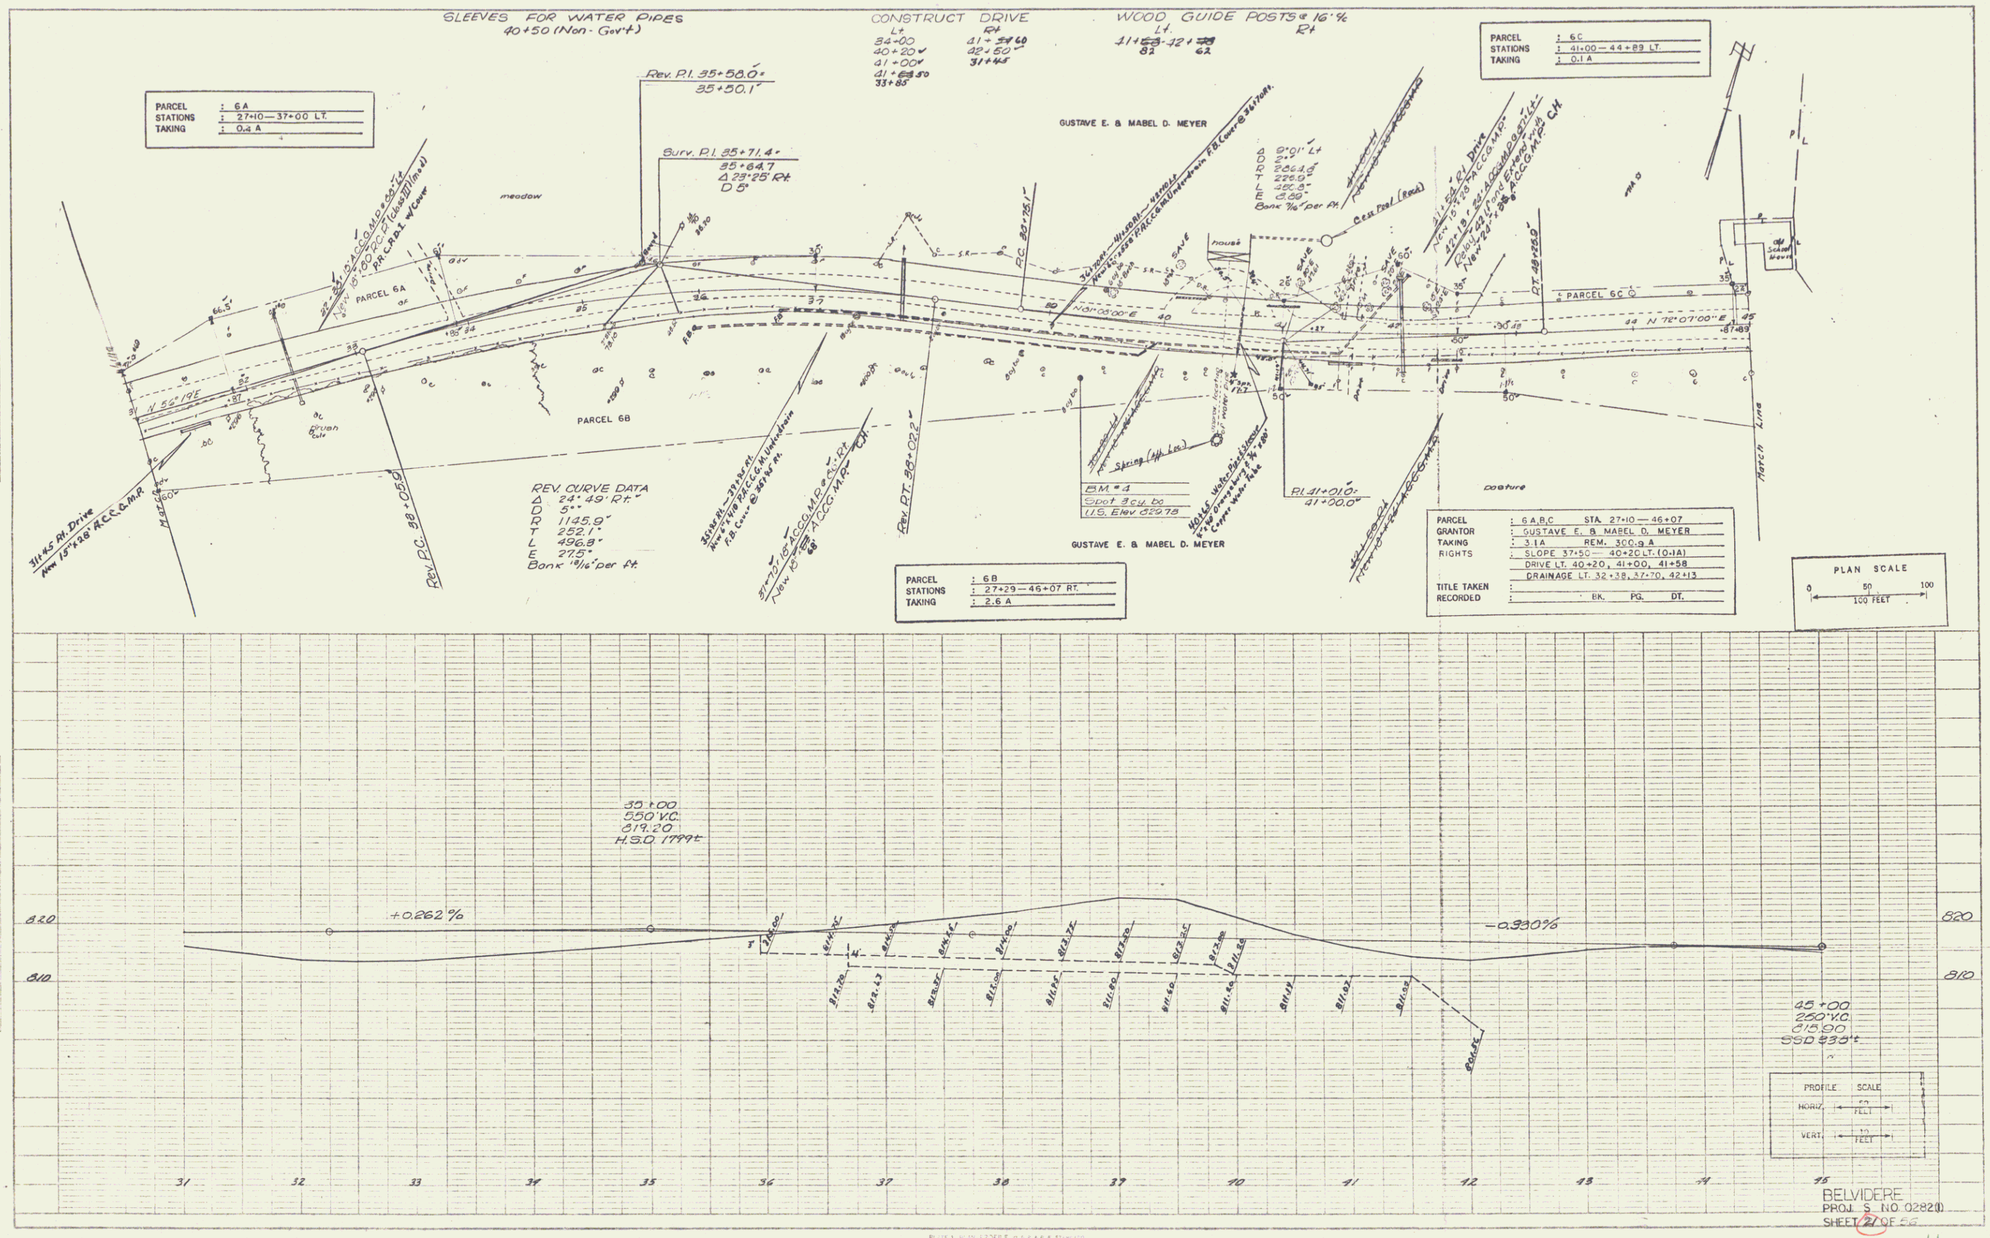
SLEEVES FOR WATER PIPES
40+50 (Non-Gov't)
CONSTRUCT DRIVE
WOOD GUIDE POSTS @ 16'%
PARCEL : 6A
STATIONS : 27+10—37+00 LT.
TAKING : 0.4 A
PARCEL : 6C
STATIONS : 41+00—44+89 LT.
TAKING : 0.1 A
Rev. P.I. 35+58.0
35+50.1
Bury. P.I. 35+71.4
35+64.7
Δ 23°25' Rt
D 5°
GUSTAVE E. & MABEL D. MEYER
meadow
PARCEL 6A
PARCEL 6B
PARCEL 6C
N 52°19'E
N 70°00'00"E
N 72°07'00"E
Rev. P.C. 38+05.0
Rev. P.T. 39+02.2
P.I. 41+01.0
41+00.0
BM #4
Spot 3 cu. bo
U.S. Elev 62.78
REV. CURVE DATA
Δ 24° 49' Rt.
D 5°
R 1145.9'
T 252.1'
L 496.8'
E 27.5'
Bank 1 1/4" per ft.
PARCEL : 6B
STATIONS : 27+29—46+07 RT.
TAKING : 2.6 A
PARCEL : 6A,B,C STA. 27+10—46+07
GRANTOR : GUSTAVE E. & MABEL D. MEYER
TAKING : 3.1A REM. 300.9 A
RIGHTS : SLOPE 37+50—40+20 LT. (0.1A)
DRIVE LT. 40+20, 41+00, 41+58
DRAINAGE LT. 32+38, 37+70, 42+13
TITLE TAKEN :
RECORDED : BK. PG. DT.
PLAN SCALE
0 50 100
100 FEET
March Line
PROFILE
H.S.O. 1799+
+0.262%
-0.330%
820
810
45+00
250' V.C.
PROFILE SCALE
HORIZ. 50 FEET
VERT. 10 FEET
31 32 33 34 35 36 37 38 39 40 41 42 43 44 45
BELVIDERE
PROJ. S NO. 02820
SHEET 21 OF 55
4