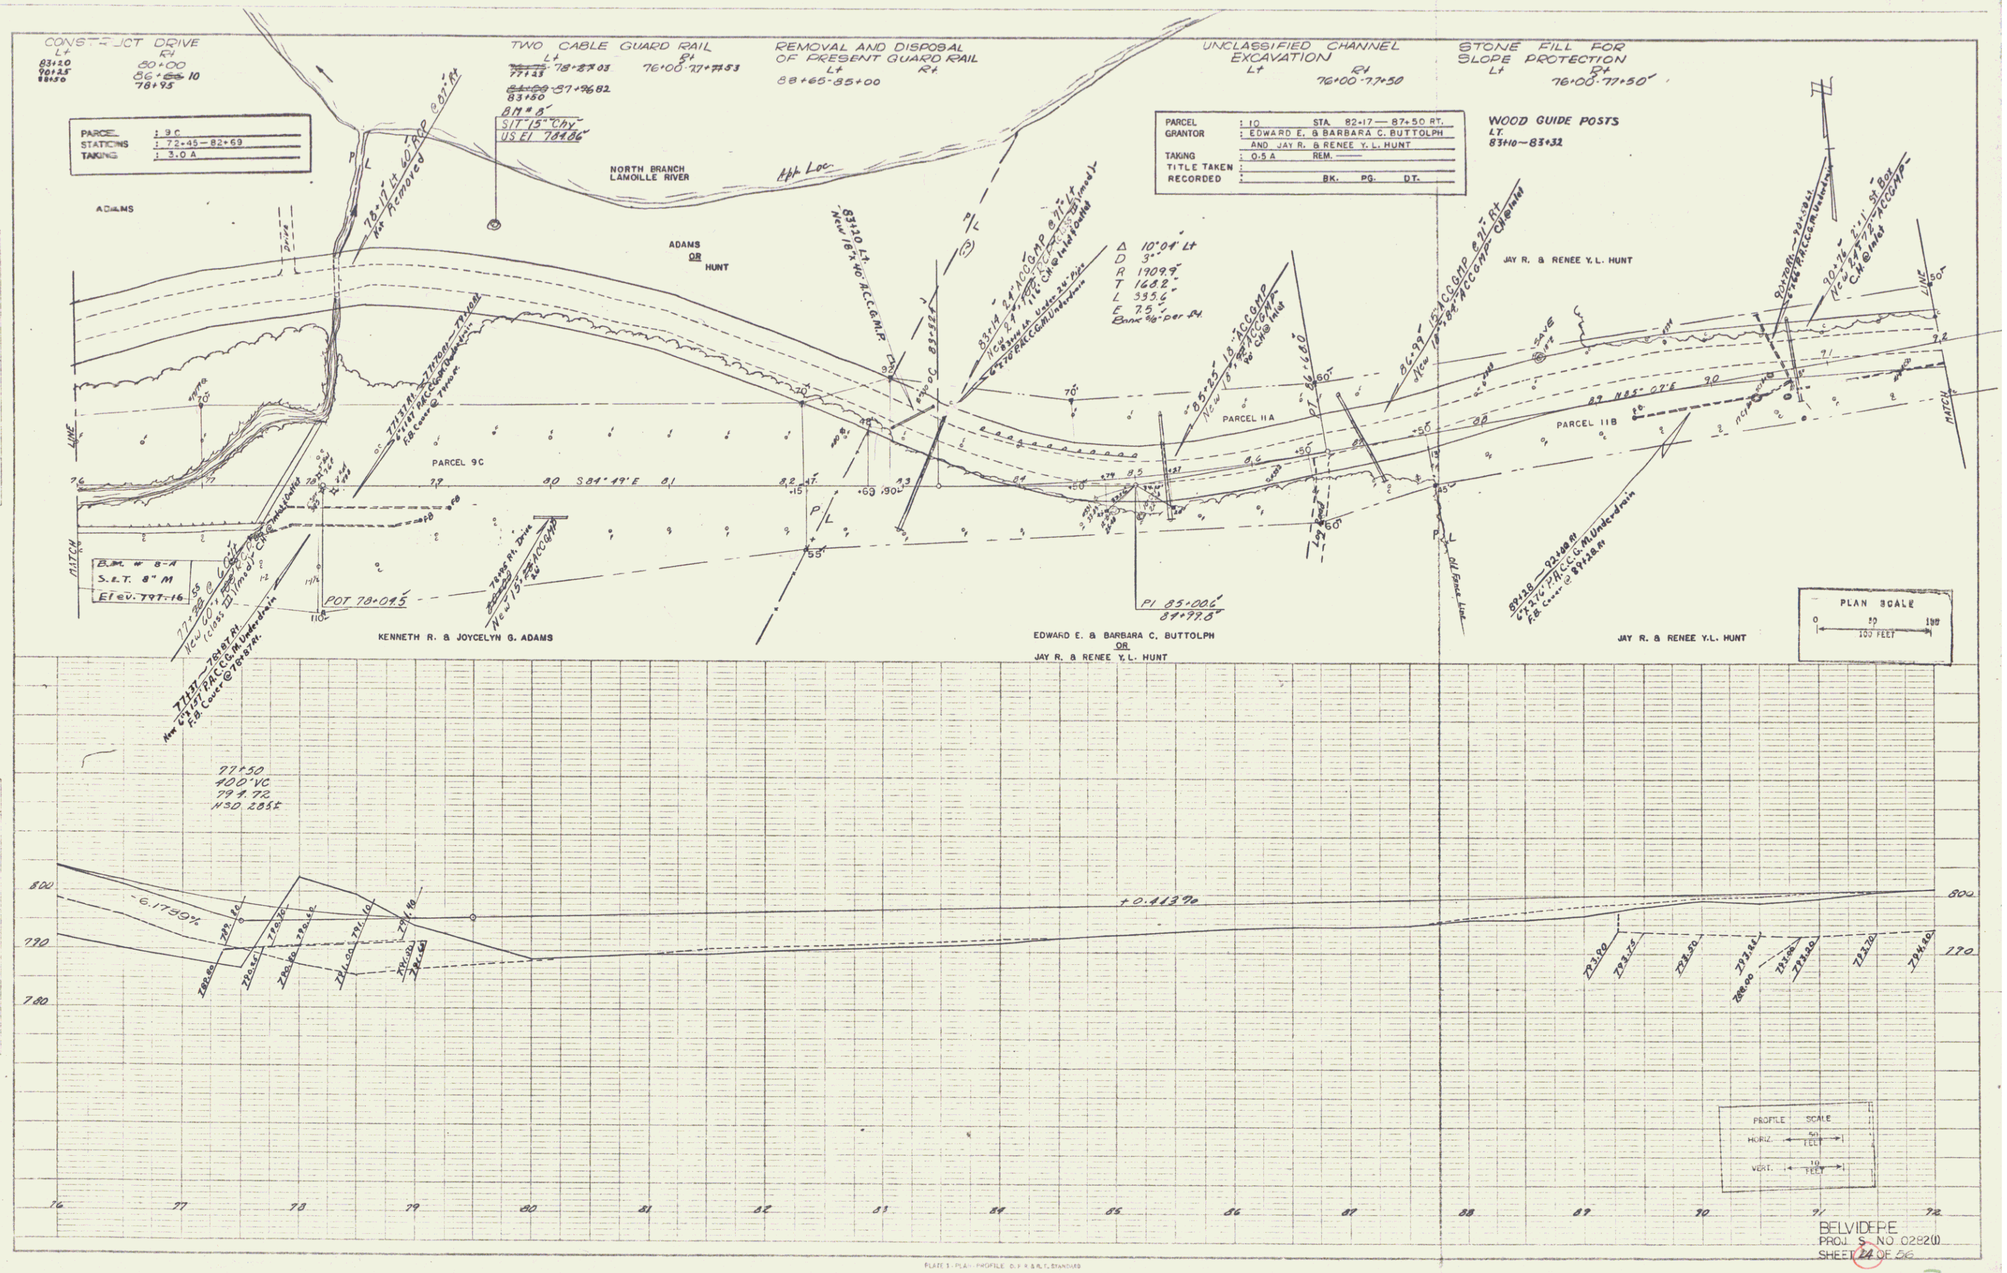
CONSTRUCT DRIVE
TWO CABLE GUARD RAIL
REMOVAL AND DISPOSAL OF PRESENT GUARD RAIL
UNCLASSIFIED CHANNEL EXCAVATION
STONE FILL FOR SLOPE PROTECTION
WOOD GUIDE POSTS
PARCEL : 9C
STATIONS : 72+45—82+69
TAKING : 3.0 A
PARCEL : 10 STA. 82+17 — 87+50 RT.
GRANTOR : EDWARD E. & BARBARA C. BUTTOLPH AND JAY R. & RENEE Y. L. HUNT
TAKING : 0.5 A REM. ——
TITLE TAKEN :
RECORDED : BK. PG. DT.
NORTH BRANCH LAMOILLE RIVER
ADAMS
ADAMS OR HUNT
JAY R. & RENEE Y. L. HUNT
PARCEL 9C
PARCEL 11A
PARCEL 11B
KENNETH R. & JOYCELYN G. ADAMS
EDWARD E. & BARBARA C. BUTTOLPH OR JAY R. & RENEE Y. L. HUNT
JAY R. & RENEE Y.L. HUNT
PLAN SCALE
PROFILE SCALE
BELVIDERE
PROJ. S NO. 0282(1)
SHEET 24 OF 26