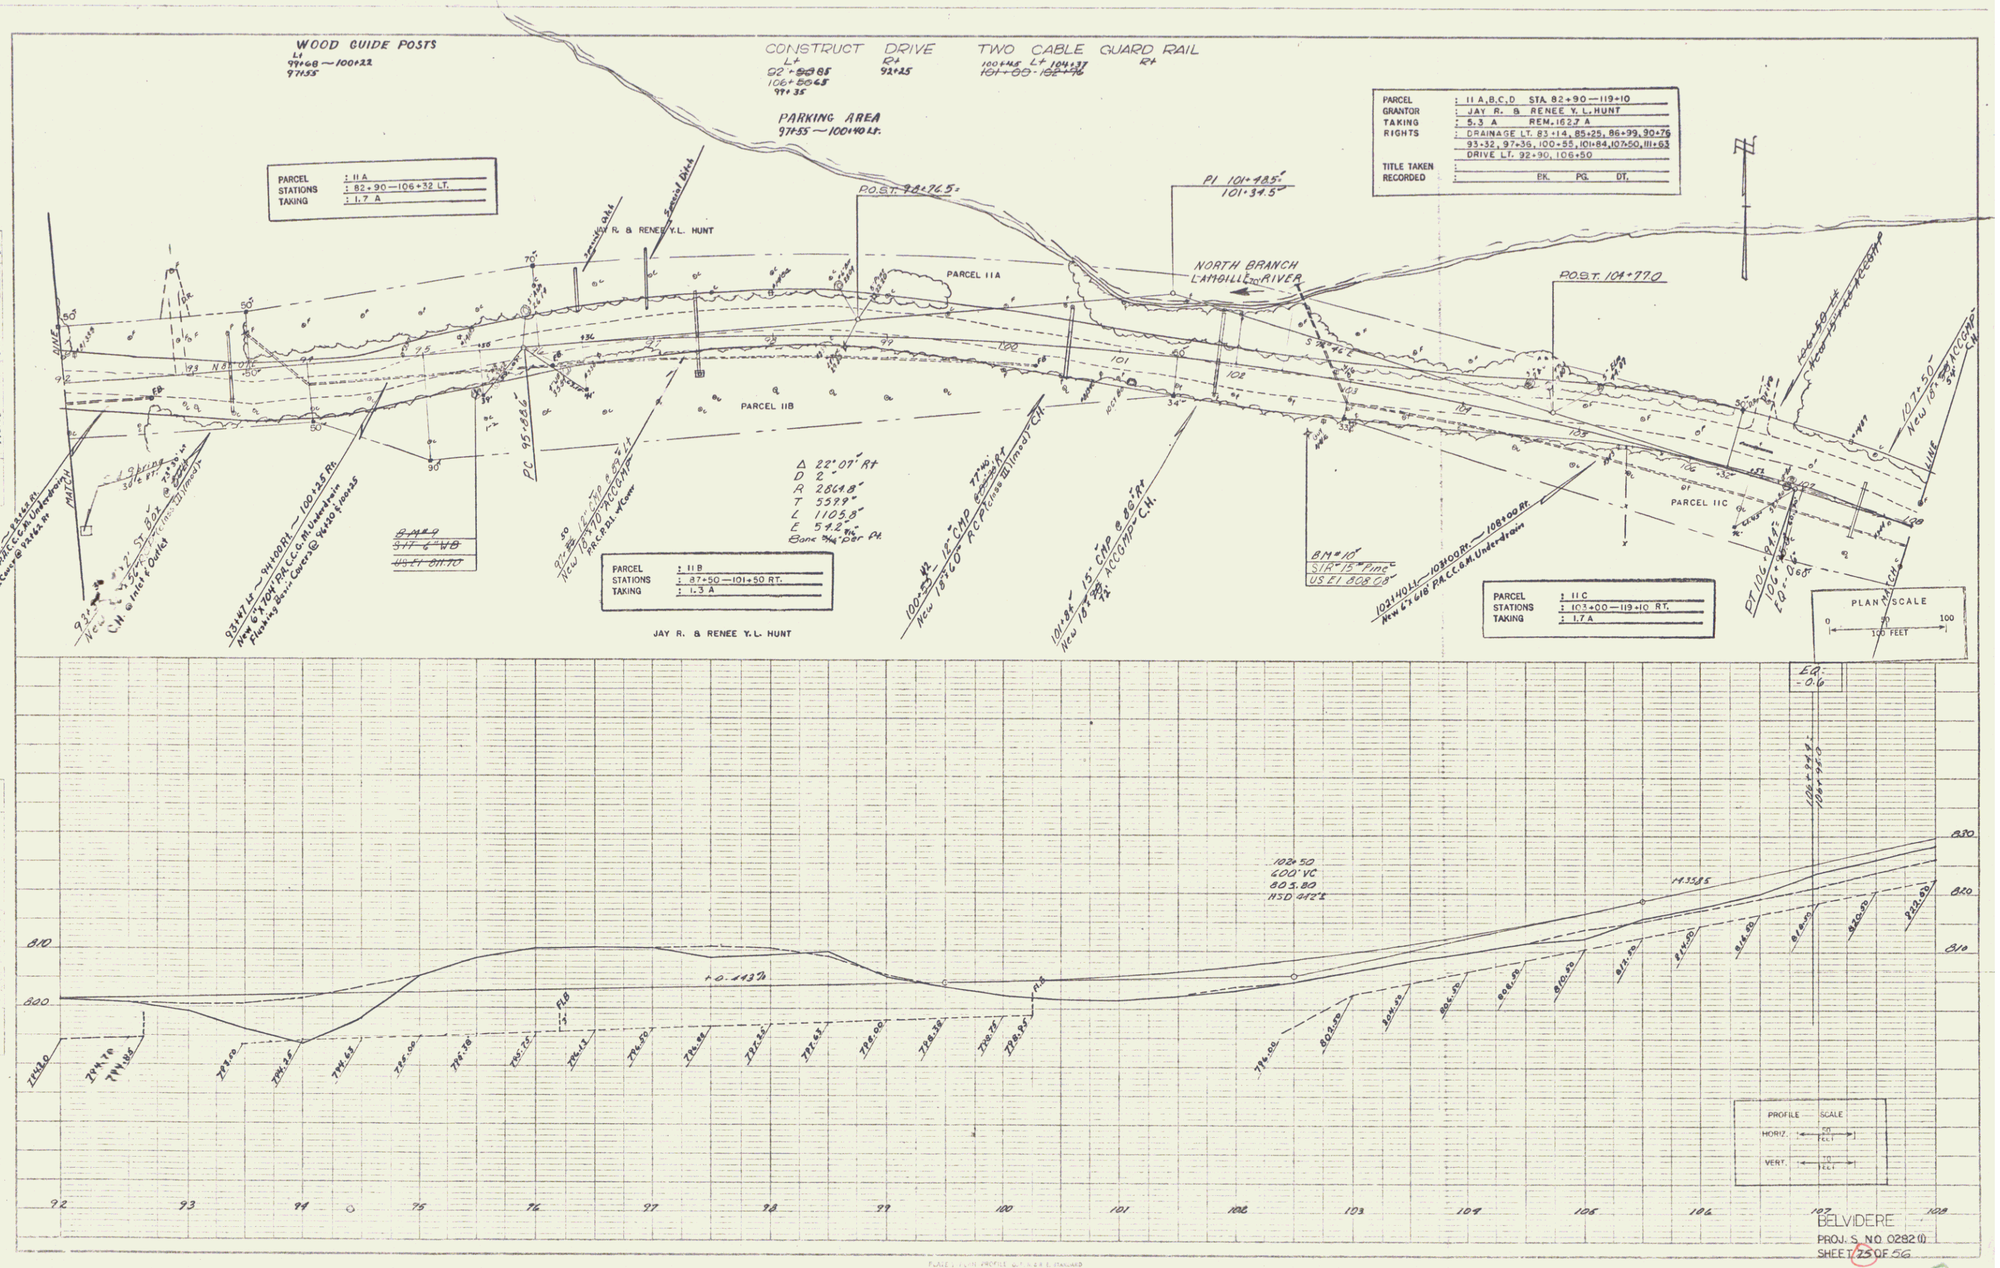
WOOD GUIDE POSTS
CONSTRUCT DRIVE
TWO CABLE GUARD RAIL
PARKING AREA
PARCEL : 11 A,B,C,D STA. 82+90 — 119+10
GRANTOR : JAY R. & RENEE Y. L. HUNT
TAKING : 5.3 A REM. 162.7 A
RIGHTS : DRAINAGE LT. 83+14, 85+25, 86+99, 90+76, 93+32, 97+36, 100+55, 101+84, 107+50, 111+63
DRIVE LT. 92+90, 106+50
TITLE TAKEN
RECORDED
BK. PG. DT.
PARCEL : 11 A
STATIONS : 82+90 — 106+32 LT.
TAKING : 1.7 A
PARCEL : 11 B
STATIONS : 87+50 — 101+50 RT.
TAKING : 1.3 A
PARCEL : 11 C
STATIONS : 103+00 — 119+10 RT.
TAKING : 1.7 A
PARCEL 11A
PARCEL 11B
PARCEL 11C
NORTH BRANCH L'AMOILLE RIVER
JAY R. & RENEE Y. L. HUNT
PI 101+48.5
101+34.5
P.O.S.T. 104+77.0
PC 95+86.6
Δ 22°07' Rt
D 2°
R 2864.8'
T 559.9'
L 1105.8'
E 57.2'
Bore 94.0' Rt
PLAN SCALE
0 50 100
100 FEET
PROFILE SCALE
HORIZ. 20 FEET
VERT. 20 FEET
EQ: -0.6
BELVIDERE
PROJ. S. NO. 0282(1)
SHEET 25 OF 56