FED. ROAD DIV. NO.	STATE	FED. AID PROJ. NO.	FISCAL YEAR	SHEET NO.	TOTAL SHEETS
5	VT.	SAE 458	1932	4	16

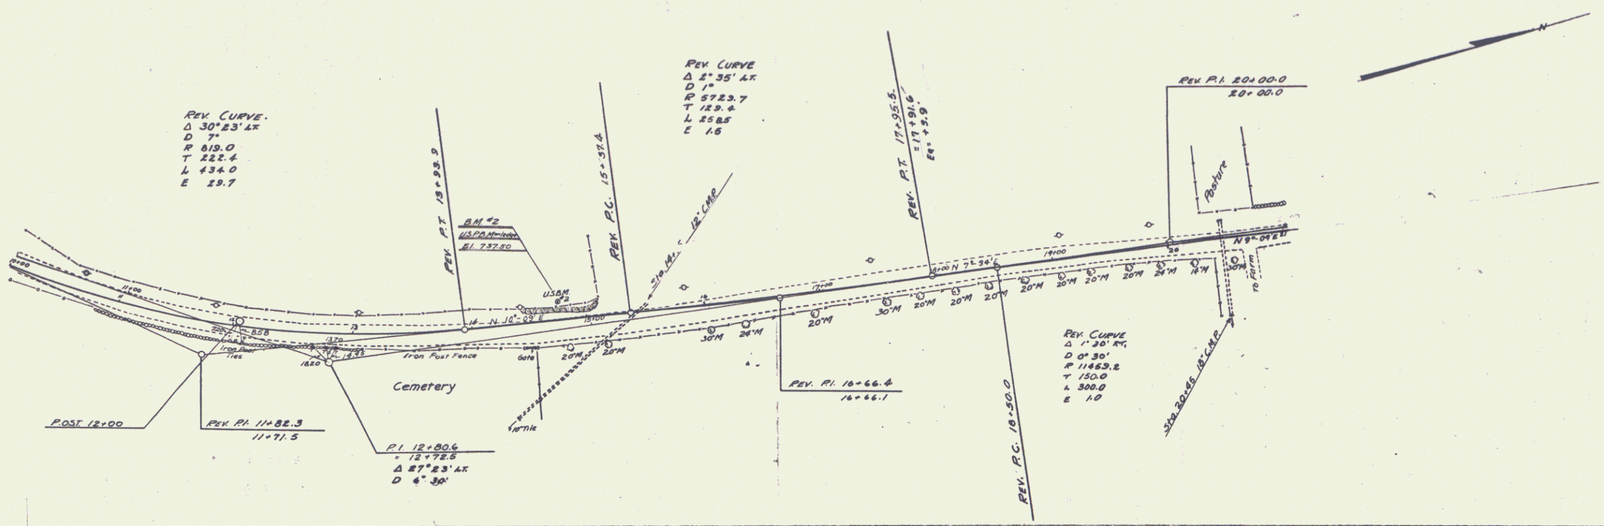

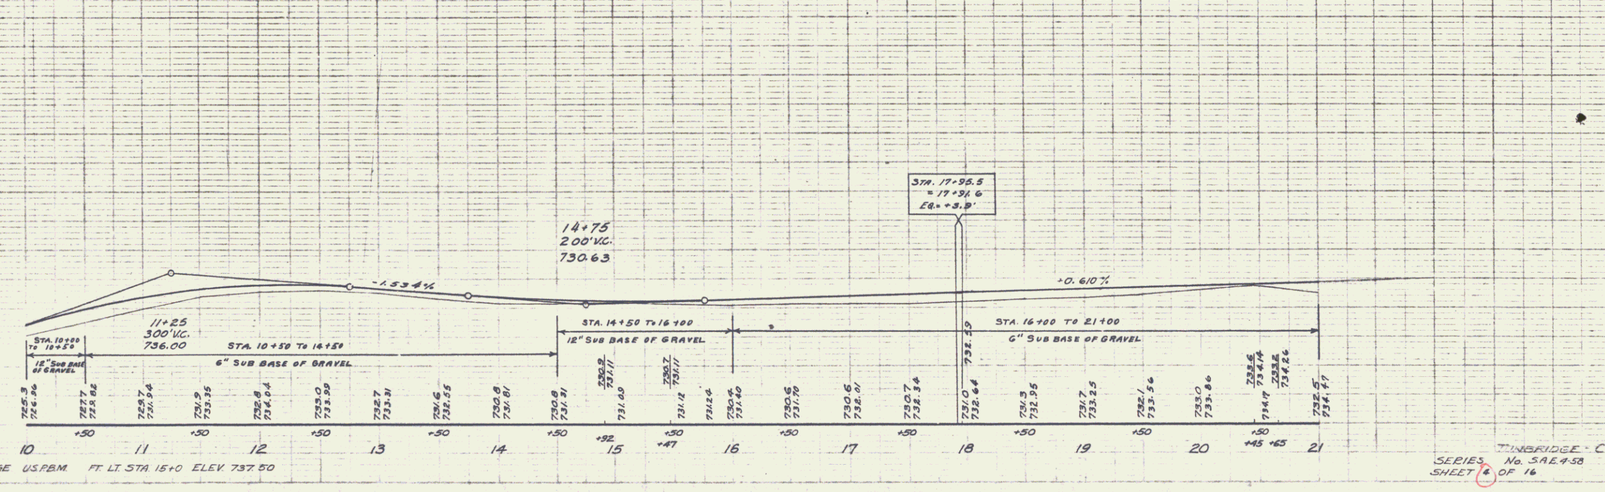

B.M. #2 BRONZE PLATE ON LEDGE U.S.P.B.M. FT. LT. STA. 15+0 ELEV. 737.50

TINGRIDGE - CHELSEA
SERIES No. SAE 458
SHEET 4 OF 16

2