141-L 1935 3 11

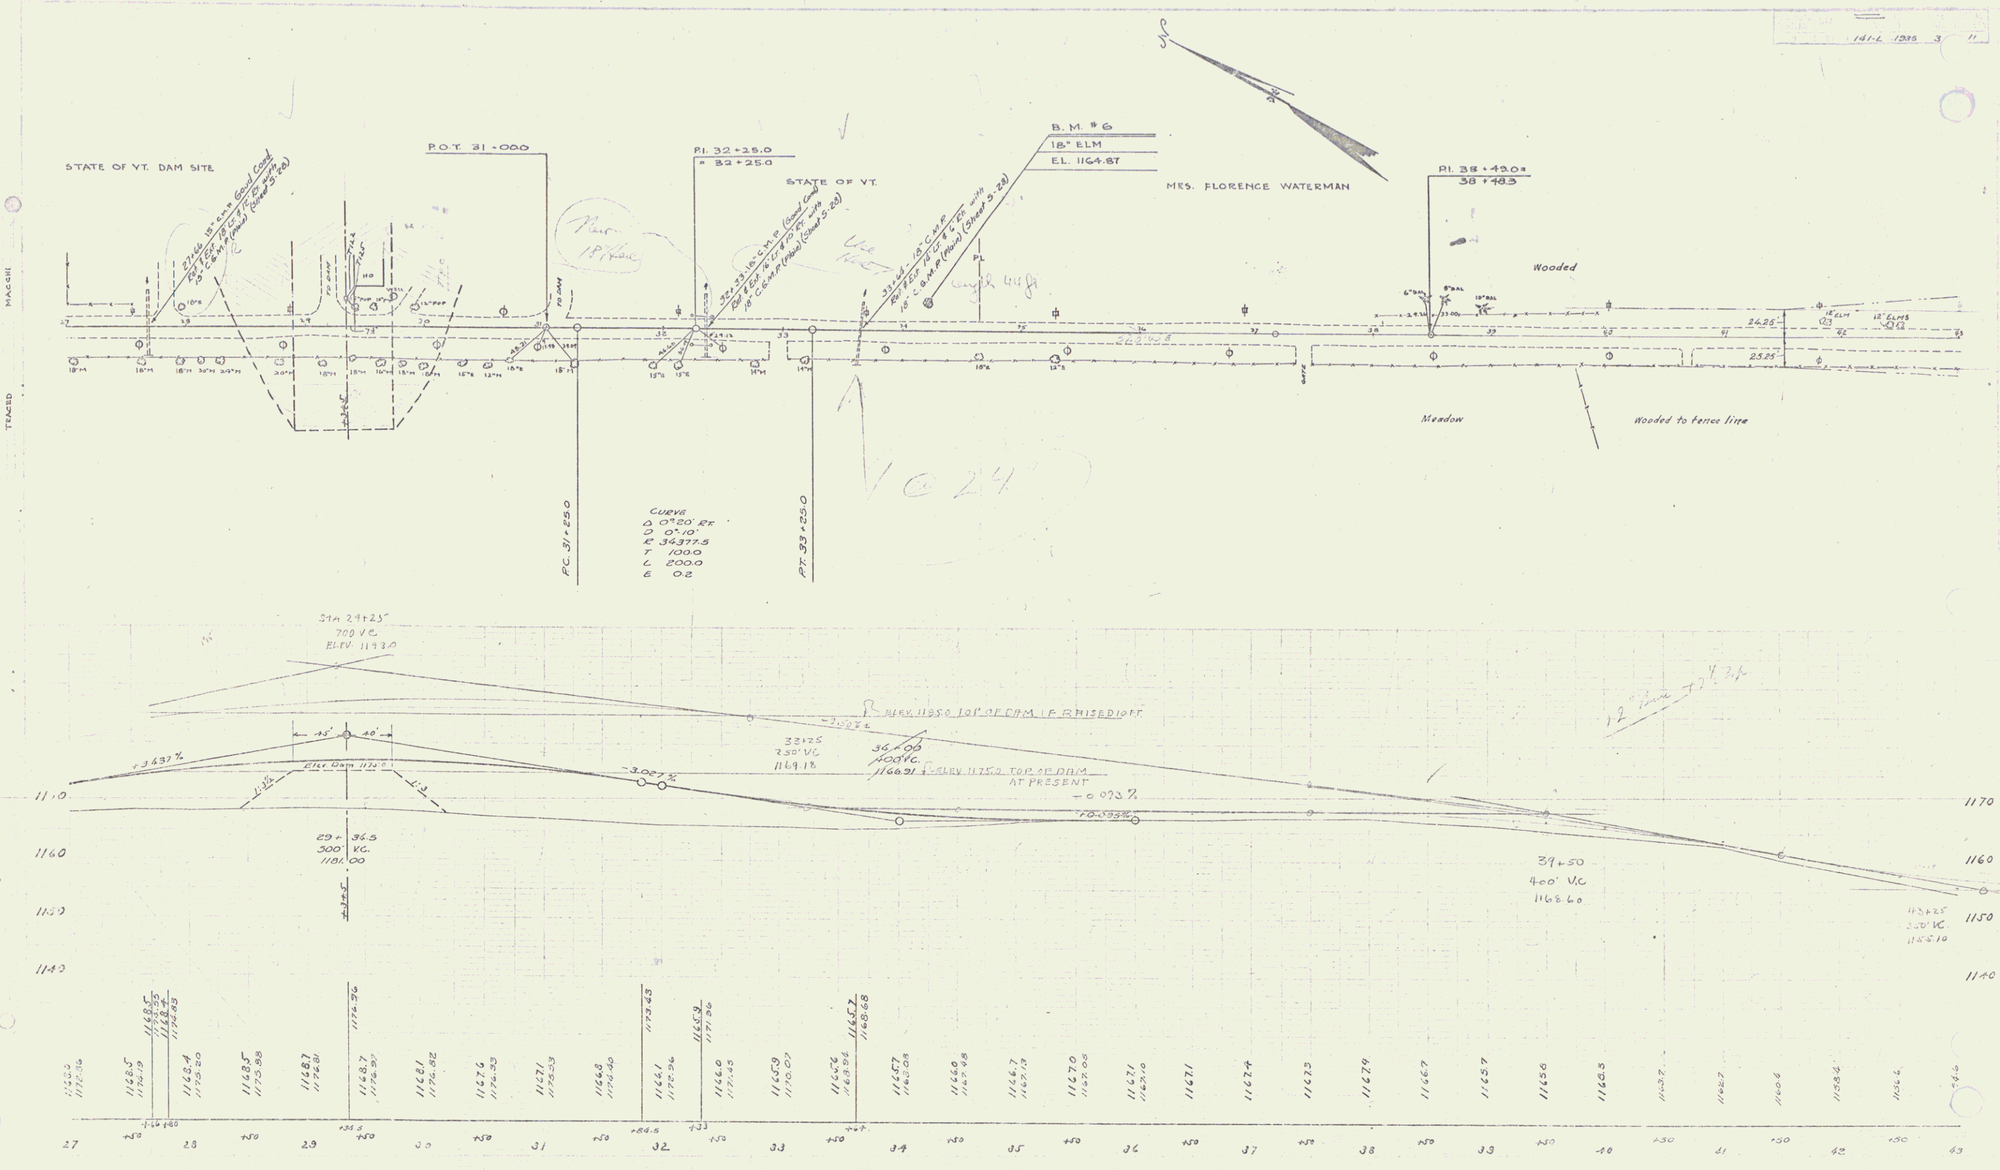

STAT. PROJ. 141-L
SHEET 3 OF 11

4