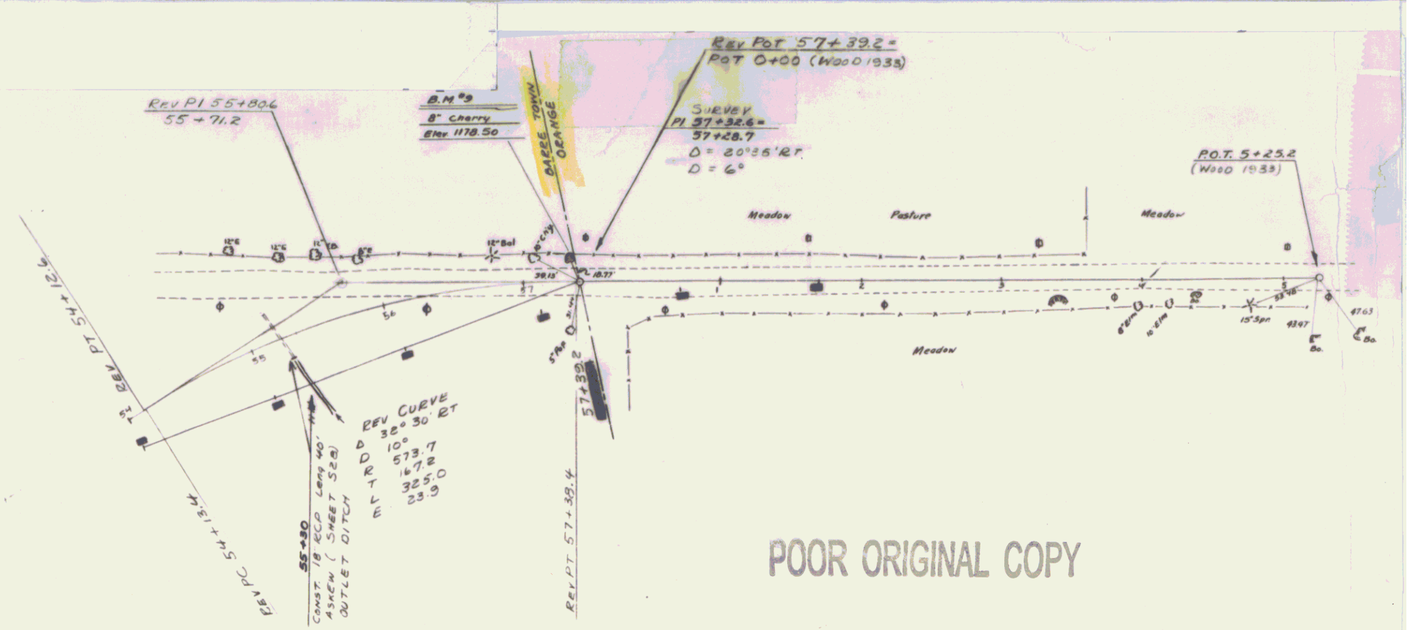

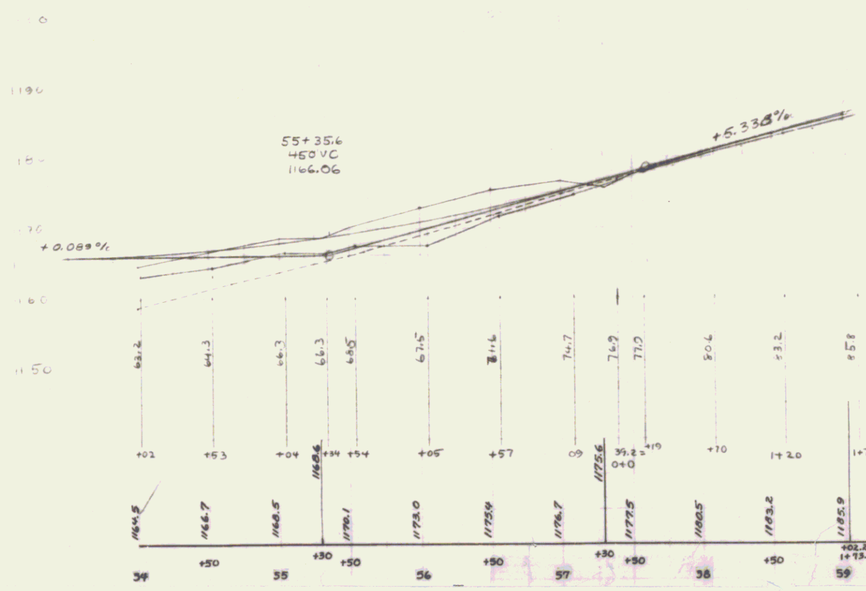

POOR ORIGINAL COPY

RIGHT-OF-WAY DIVISION
TOWN FILE
PERPETUAL
Town of
(To Be Returned To R.O.W. Division)

SHEET 4A

6