


Tunbridge 39

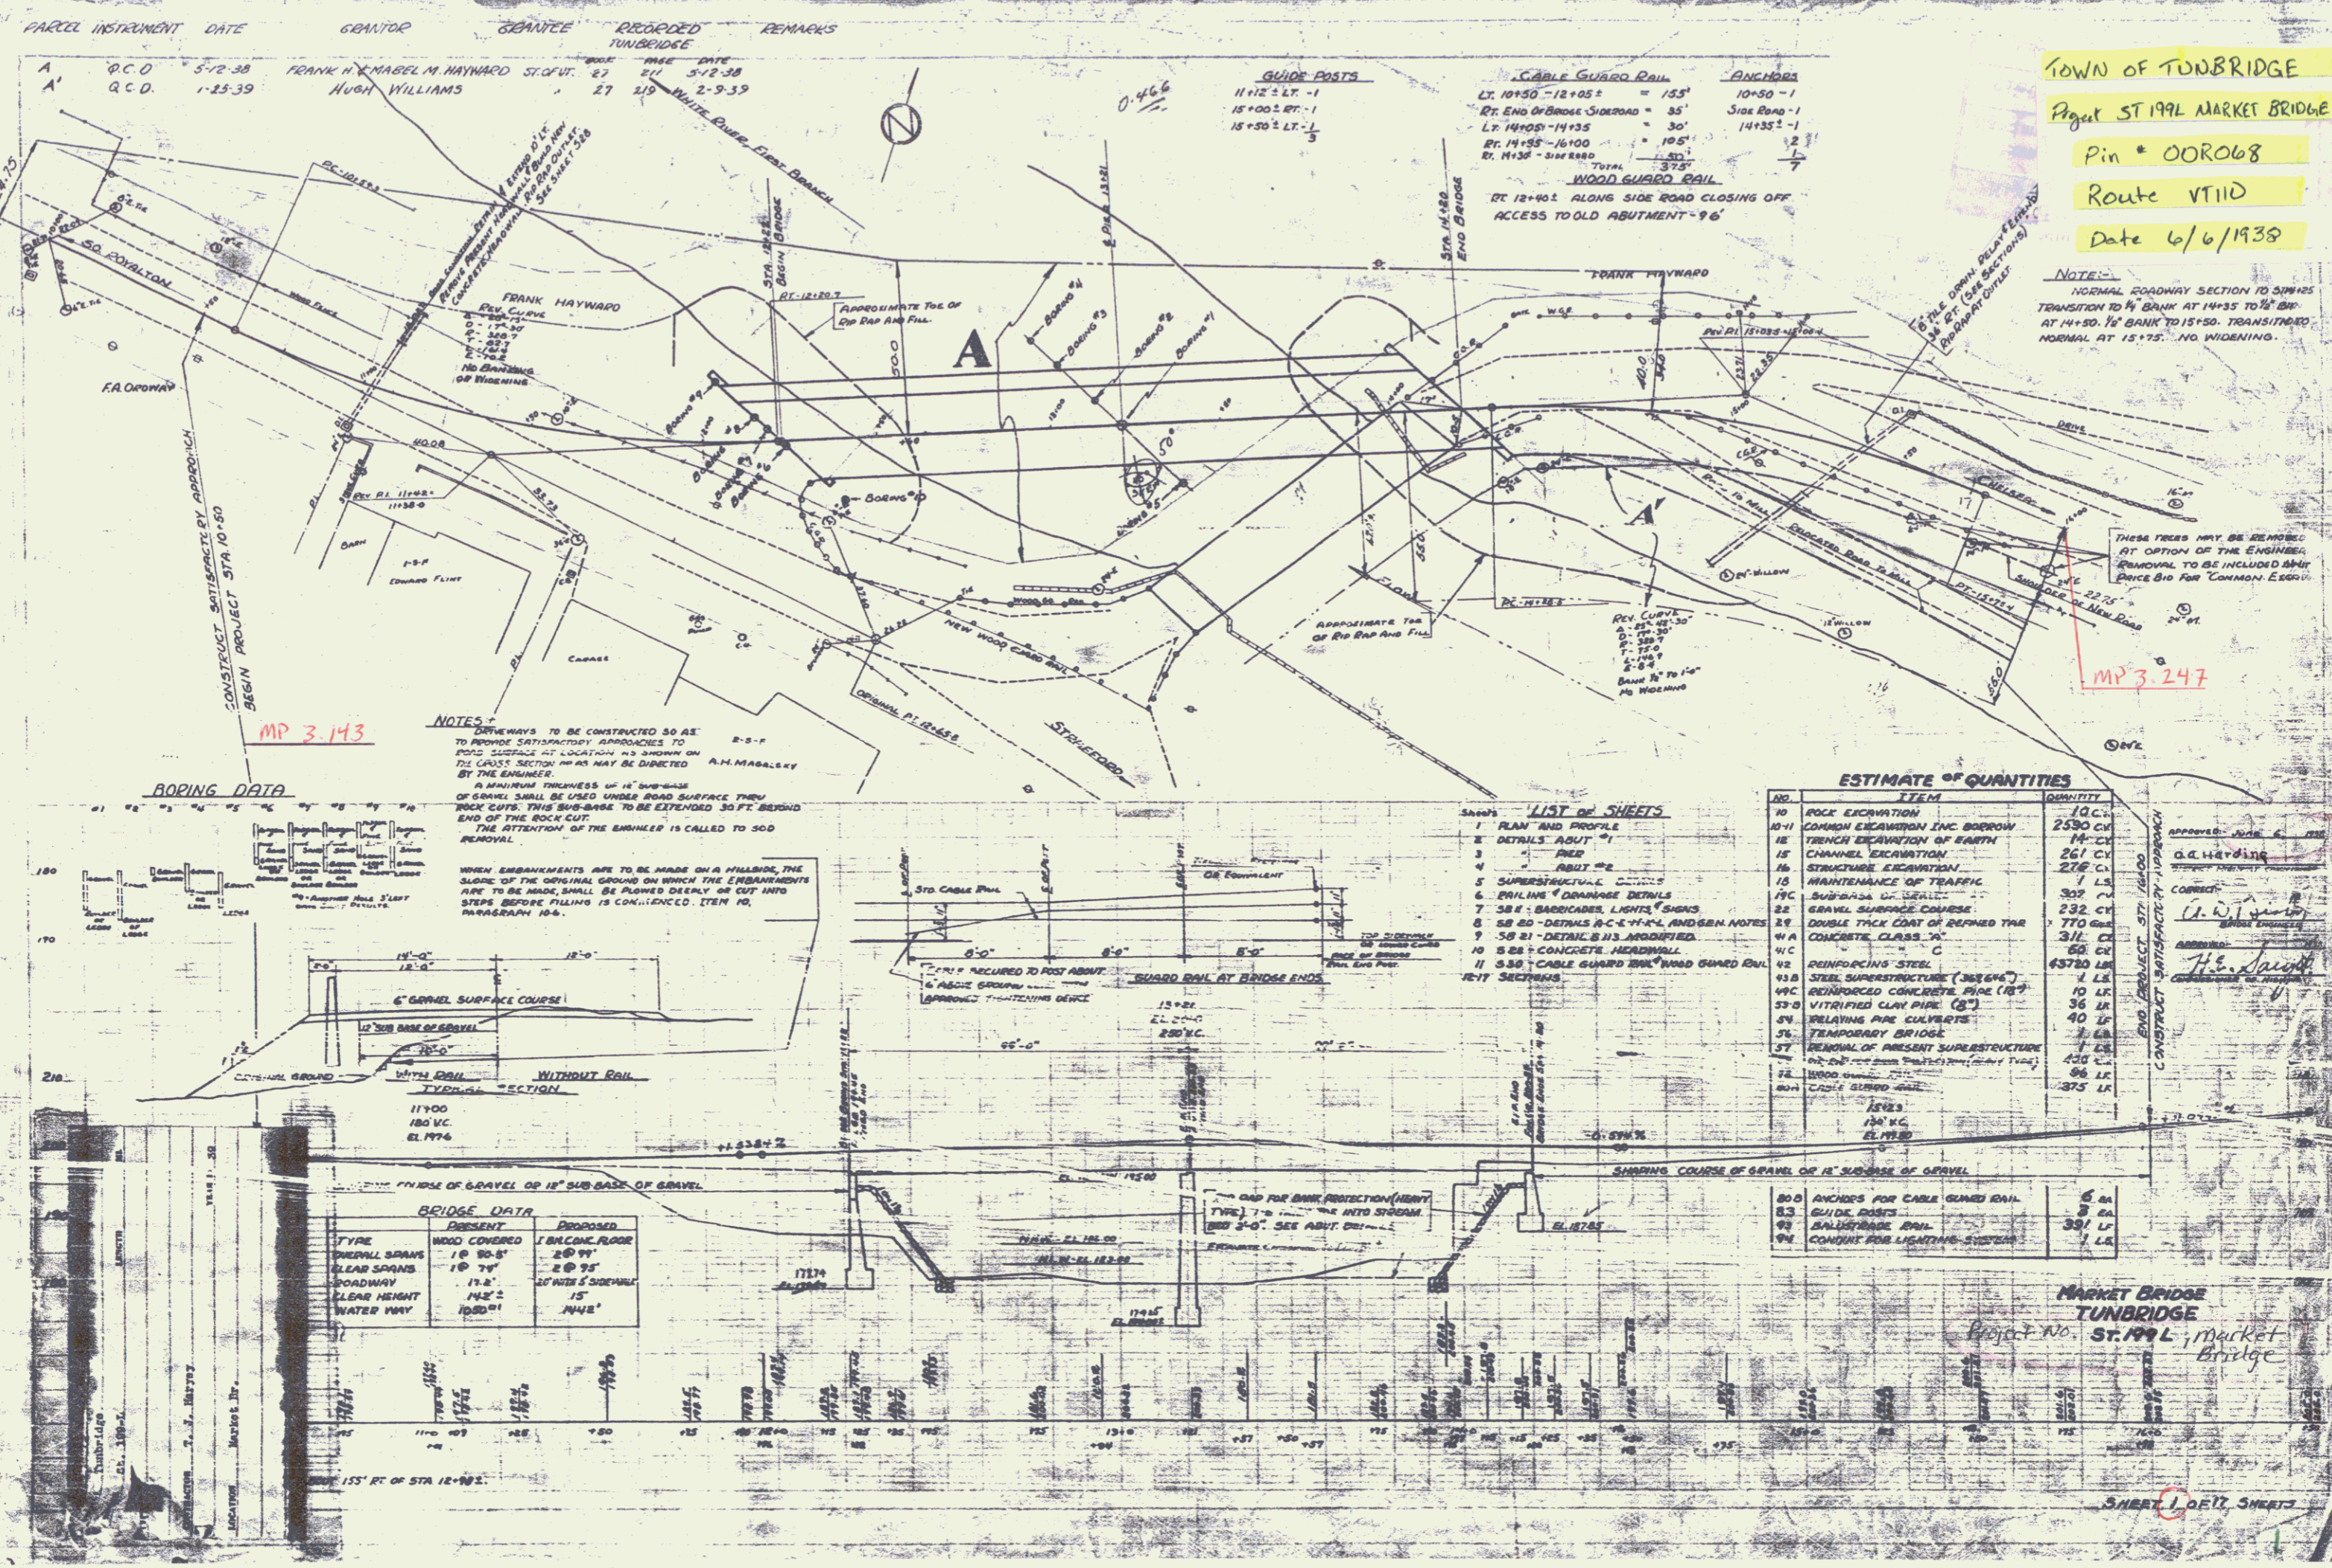


PARCEL INSTRUMENT	DATE	GRANTOR	GRANTEE	RECORDED	REMARKS
P.C.D.	5-12-38	FRANK H. & MABEL M. HAYWARD	ST. 199L	27	5-12-38
Q.C.D.	1-25-39	HUGH WILLIAMS	TUNBRIDGE	27	2-9-39

TOWN OF TUNBRIDGE
 Project ST 199L MARKET BRIDGE
 Pin * 00R068
 Route VT110
 Date 6/6/1938

MP 3.143

MP 3.247

ROPING DATA

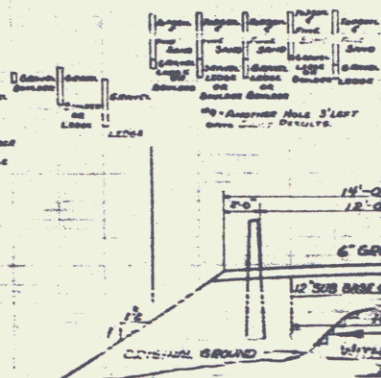

NOTES
 APPROACHES TO BE CONSTRUCTED SO AS TO PROVIDE SATISFACTORY APPROACHES TO ROAD SURFACE AT LOCATION AS SHOWN ON THIS PLAN. SECTION 100 MAY BE DIRECTED BY THE ENGINEER.
 A MINIMUM THICKNESS OF 18" SUBGRADE OF GRAVEL SHALL BE USED UNDER ROAD SURFACE THROUGH ROCK CUTS. THIS SUB-BASE TO BE EXTENDED 30 FT BEYOND END OF THE ROCK CUT.
 THE ATTENTION OF THE ENGINEER IS CALLED TO SOIL REMOVAL.
 WHEN EMBANKMENTS ARE TO BE MADE ON A HILLSIDE, THE SLOPE OF THE ORIGINAL GROUND ON WHICH THE EMBANKMENTS ARE TO BE MADE SHALL BE PLANNED CAREFULLY OR CUT INTO STEPS BEFORE FILLING IS COMMENCED. ITEM NO. PARAGRAPH 10-6.

LIST OF SHEETS

- 1 PLAN AND PROFILE

ESTIMATE OF QUANTITIES

NO.	ITEM	QUANTITY
10	ROCK EXCAVATION	10 C.Y.

BRIDGE DATA

TYPE	PRESENT	PROPOSED

MARKET BRIDGE
 TUNBRIDGE
 Project No. ST 199L Market Bridge

