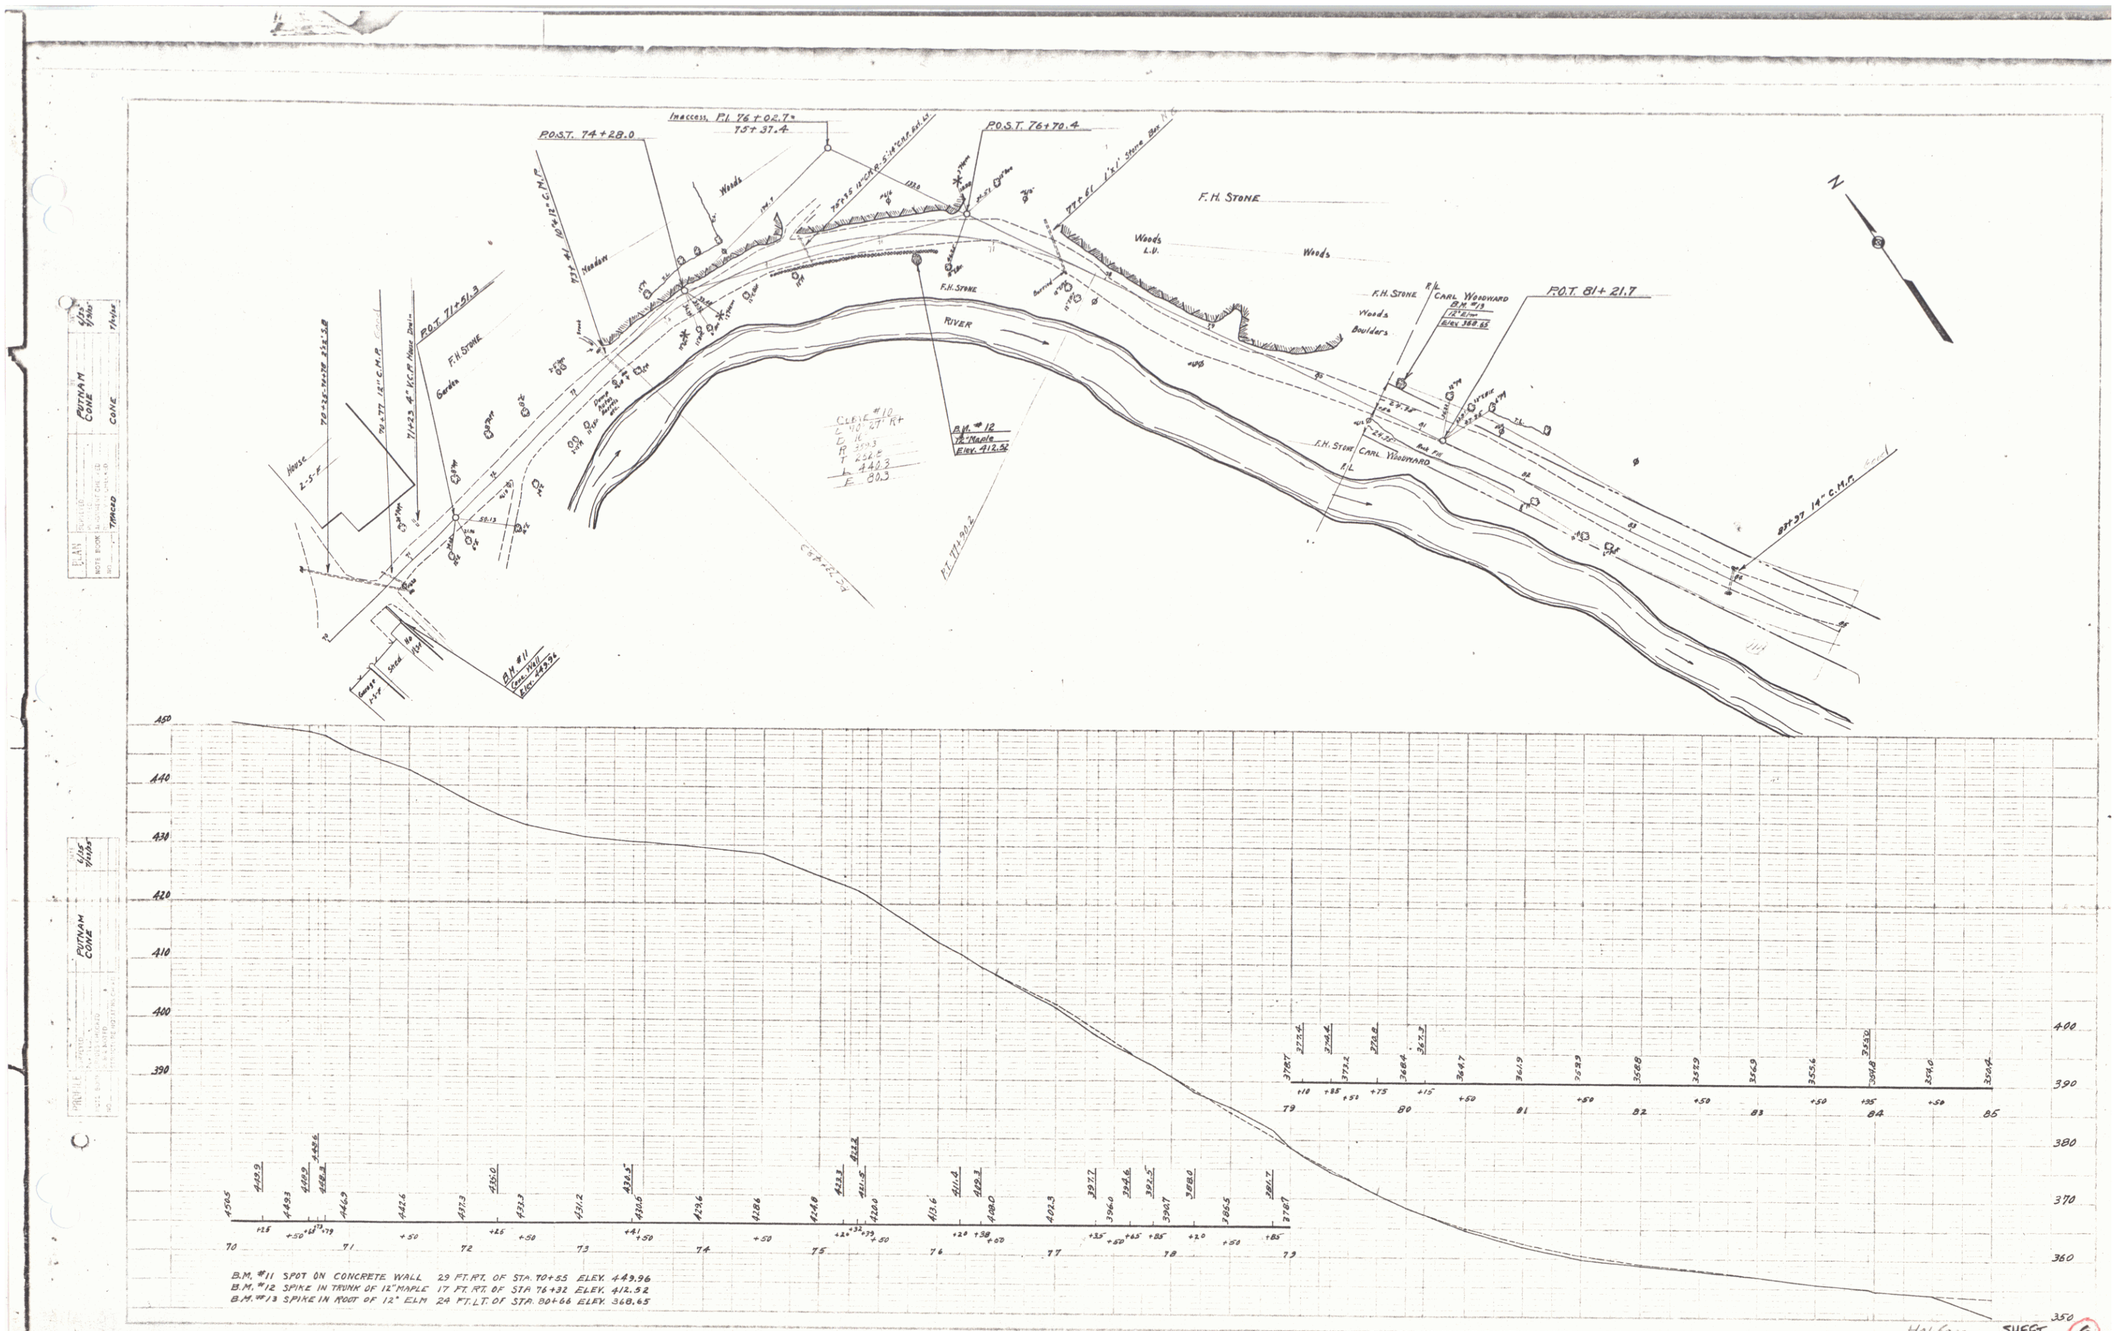

Halifax SHEET 6

6