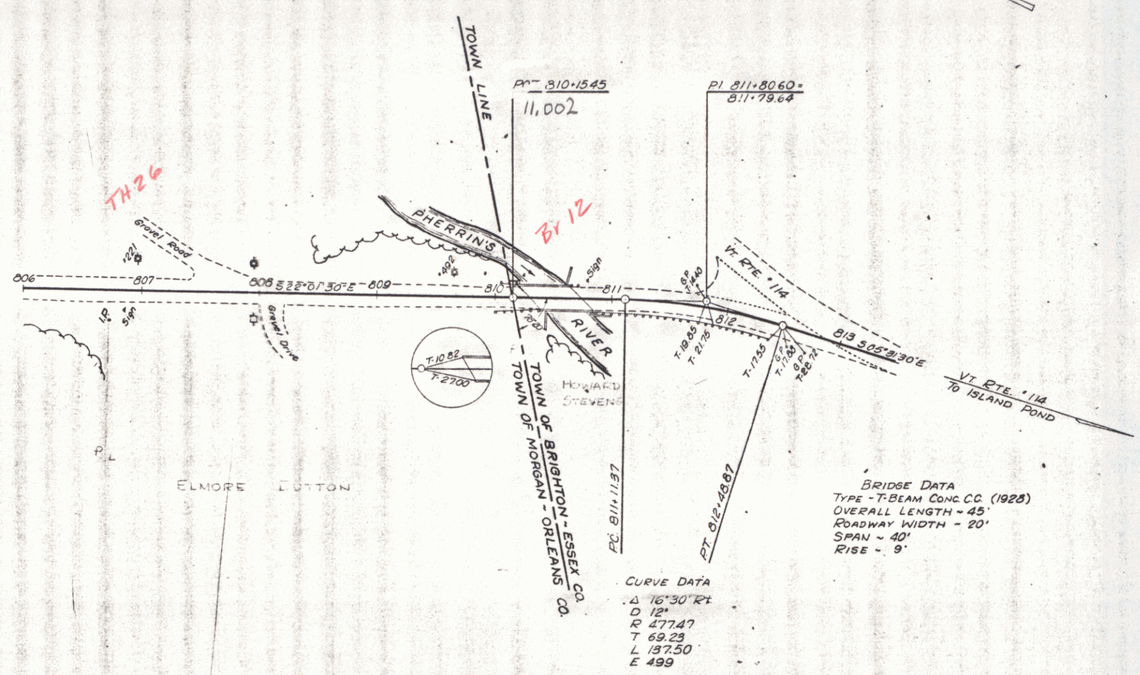

SURVEYED BY FANTONI DATE DEC 1966
DRAWN BY BANKS DATE FEB 1967
TRACED BY BANKS DATE FEB 1967

MORGAN
VT ROUTE #111

SCALE 50 100 FEET
SHEET 21 OF 27

243