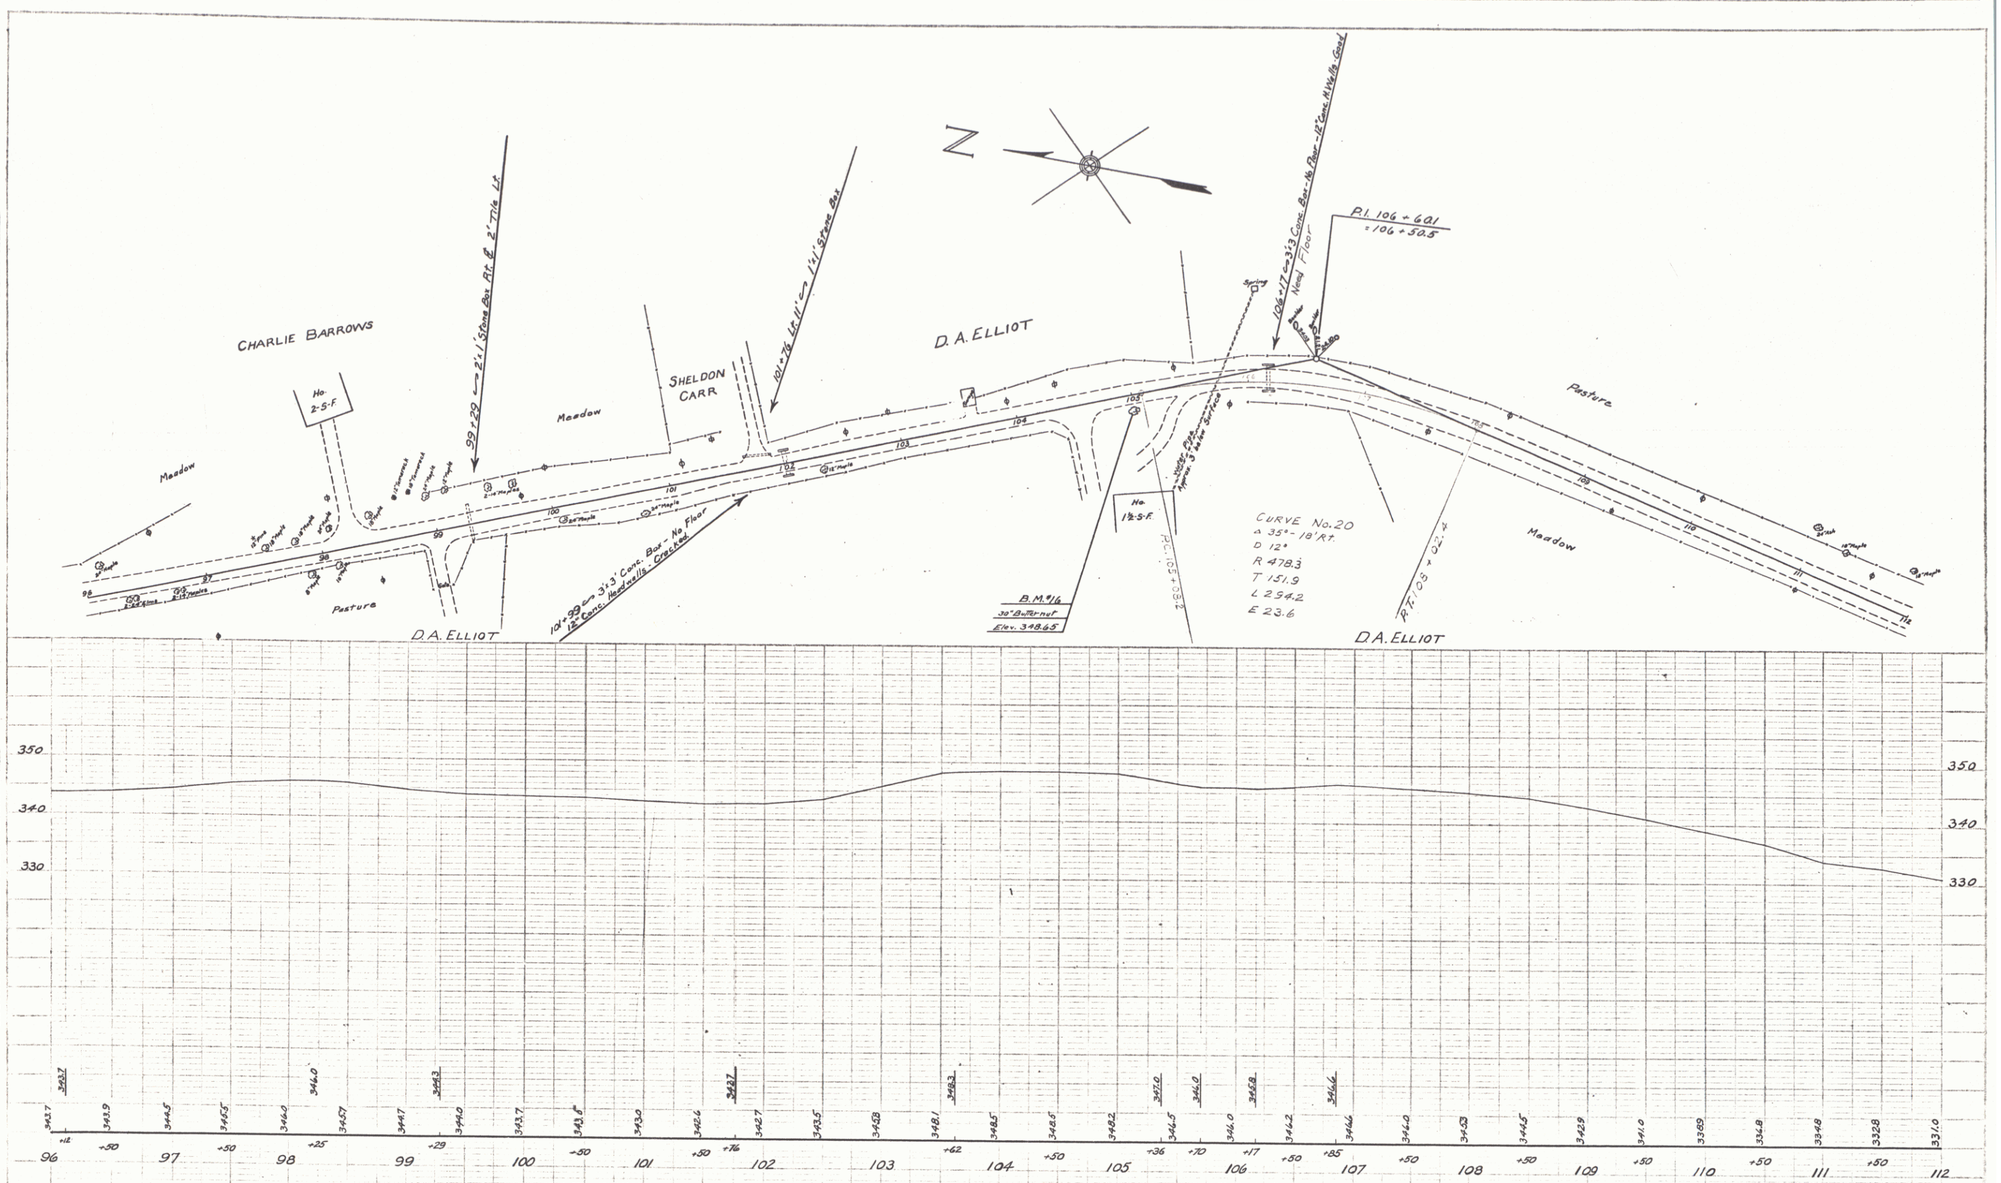

PARRINGTON	PM/BLE		
COLLINS	DM/BLE		
TRACED	COLLINS	DM/BLE	

SERIES WPSO No. 205-A.
SHEET 7 OF

MORGAN

5