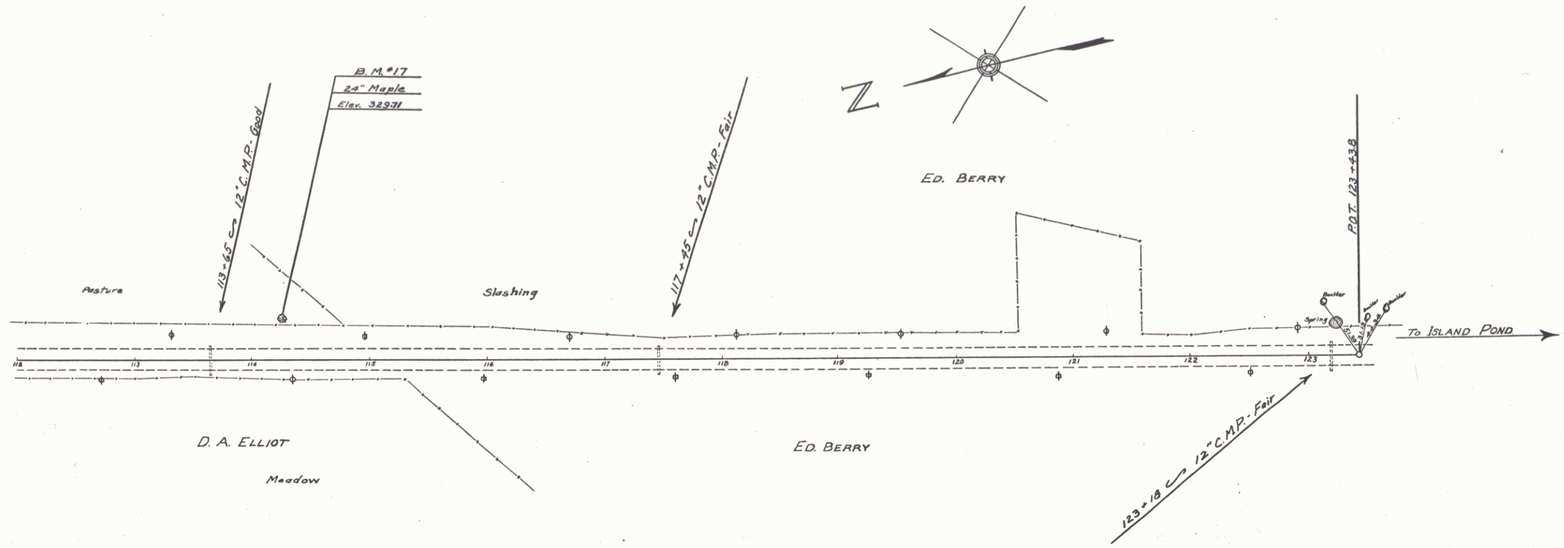

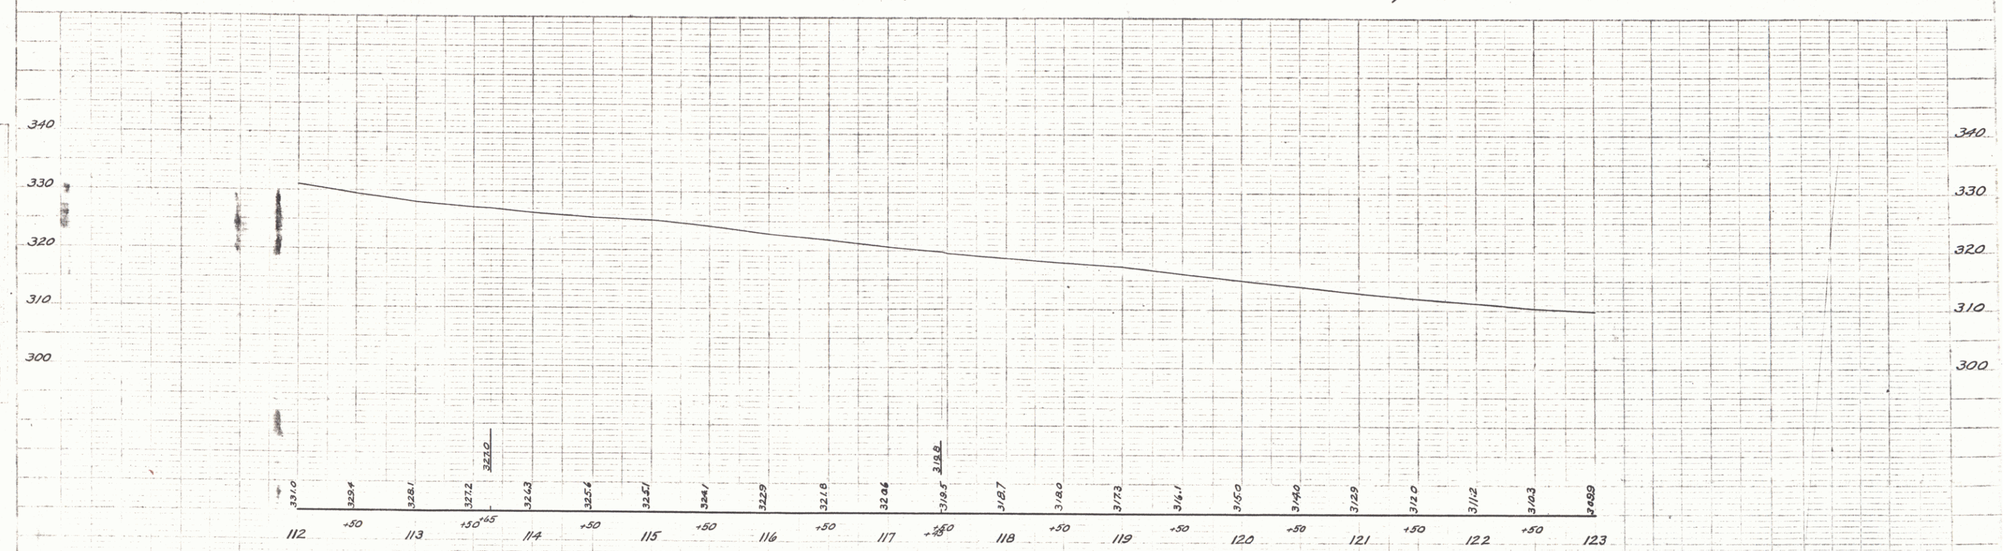

B.M. #17 Spike in Root of 24" Maple 33' Lt. of Sta. 114+25 Elev. 329.71.
B.M. #18 Point Spot on Boulder on Rt of Line (beyond Sta. 123+50) " 311.34.

SERIES WPSO No. 205-A
SHEET 8 OF

FARRINGTON No. 1936
COLLINS

MORGAN