CONSTRUCT DRIVE
Lt
199+50
Rt
196+73
200+25
208+66

~~TWO CABLE GUARD RAIL~~
~~Lt~~ ~~Rt~~
~~196+00—197+62~~

WOOD GUIDE POSTS
Lt
~~190+60—199+32~~
~~201+97—204+53~~
~~209+40—211+00~~
195+70—199+20
201+50—203+10
203+84—204+64
209+60—211+04

Rt
~~196+59—196+82~~
~~202+40—203+72~~
~~206+00—210+48~~
195+70—199+20
201+50—203+10
203+60—211+04

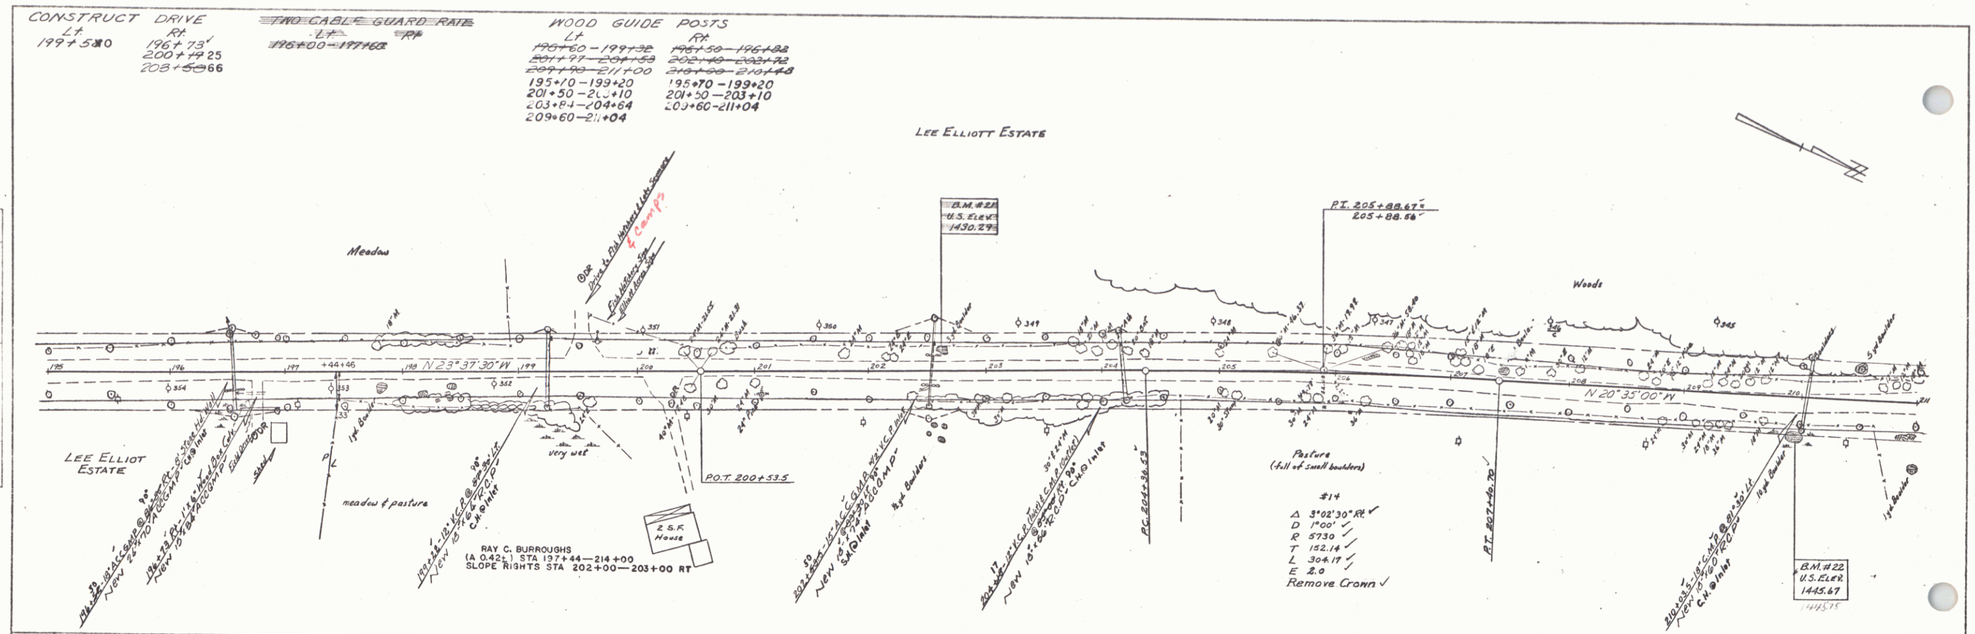

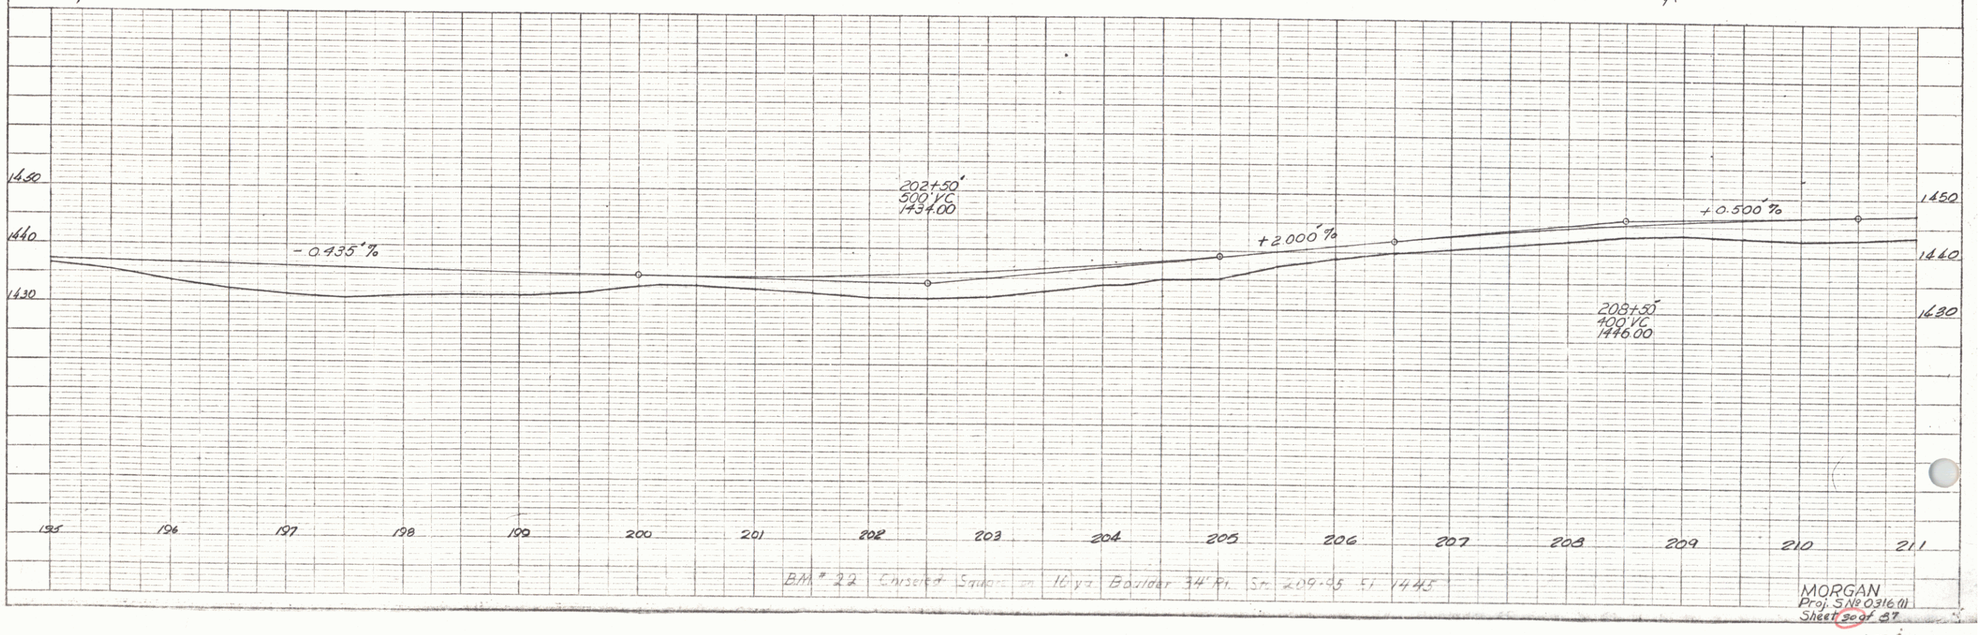

MORGAN
Proj. S № 0316(1)
Sheet 30 of 87

15