TOWN OF BRIGHTON

COUNTY OF ESSEX

Pin# 00R077

VT. ROUTE Nº III & STATE AID ROUTE Nº 3

DERBY CENTER – ISLAND POND ROAD

BEGINNING AT THE MORGAN – BRIGHTON TOWN LINE AND EXTENDING SOUTHEASTERLY 0. MILES TO THE INTERSECTION OF VT. RTE. Nº III AND VT. RTE. Nº 114.

LENGTH OF PROJECT FEET = 0. MILES

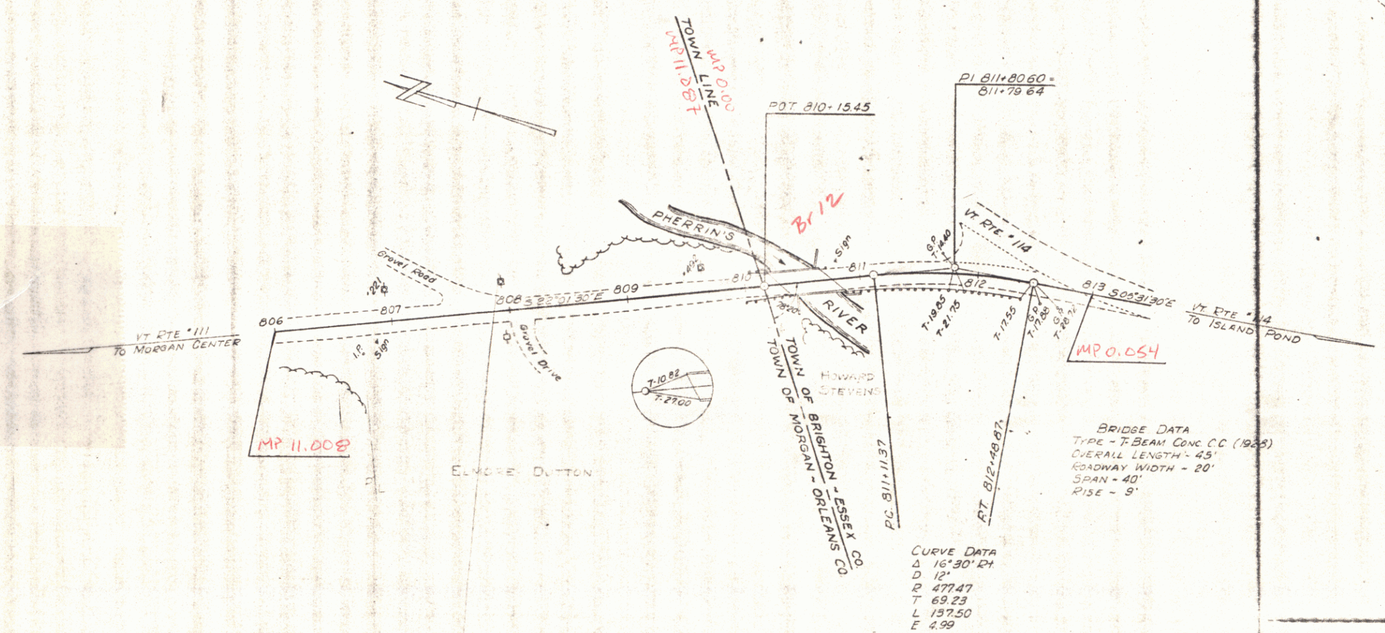

Project No.
MP 0.00 – 0.060
RIGHT-OF-WAY DIVISION
TOWN FILE
PERPETUAL
~~Rte~~ ~~Town~~ of Vt 111
(To Be Returned To R.O.W. Division)

12/1/66

SURVEYED BY FANTONI DATE DEC 1966
DRAWN BY BANKS DATE FEB 1967
TRACED BY BANKS DATE FEB 1967
BRIGHTON
VT ROUTE 111
SCALE: 1" = 50'
SHEET 1 OF 1