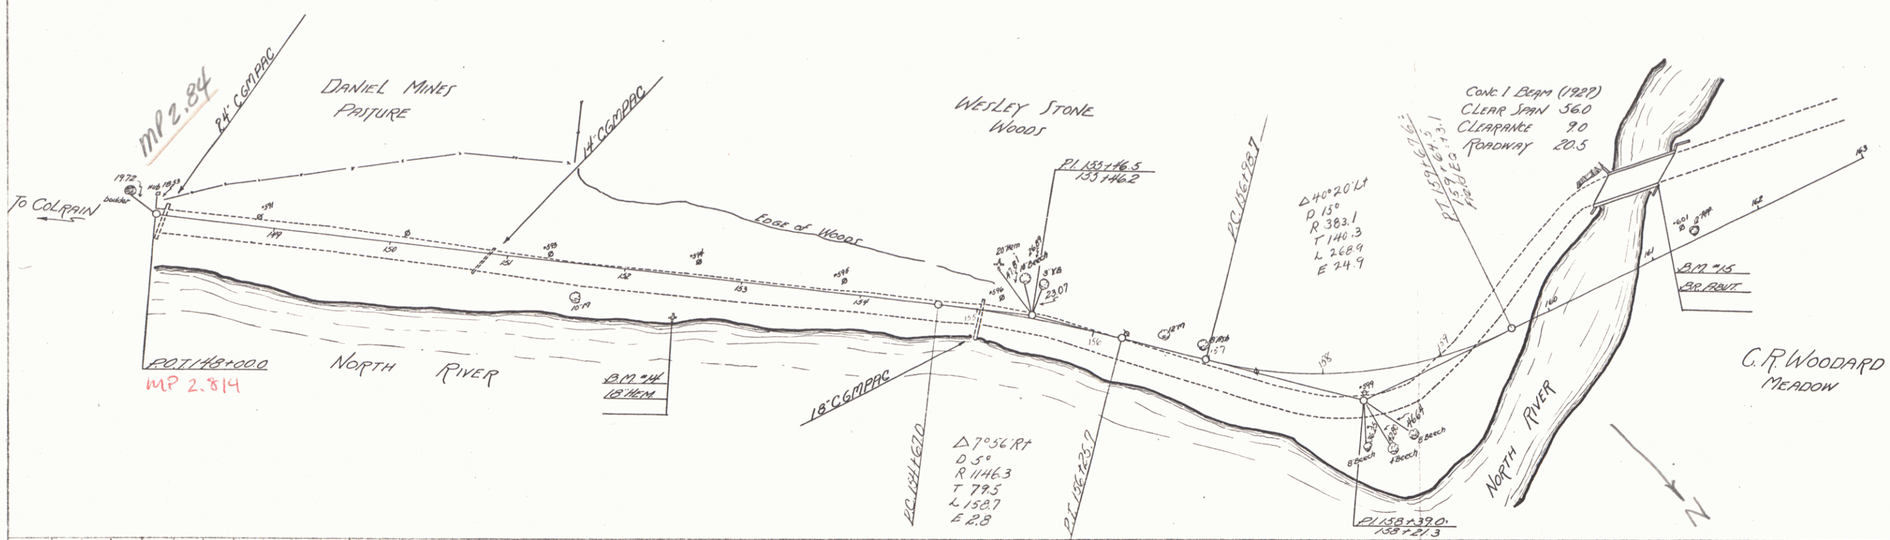

Halifax 24-L

SHEET 3

3