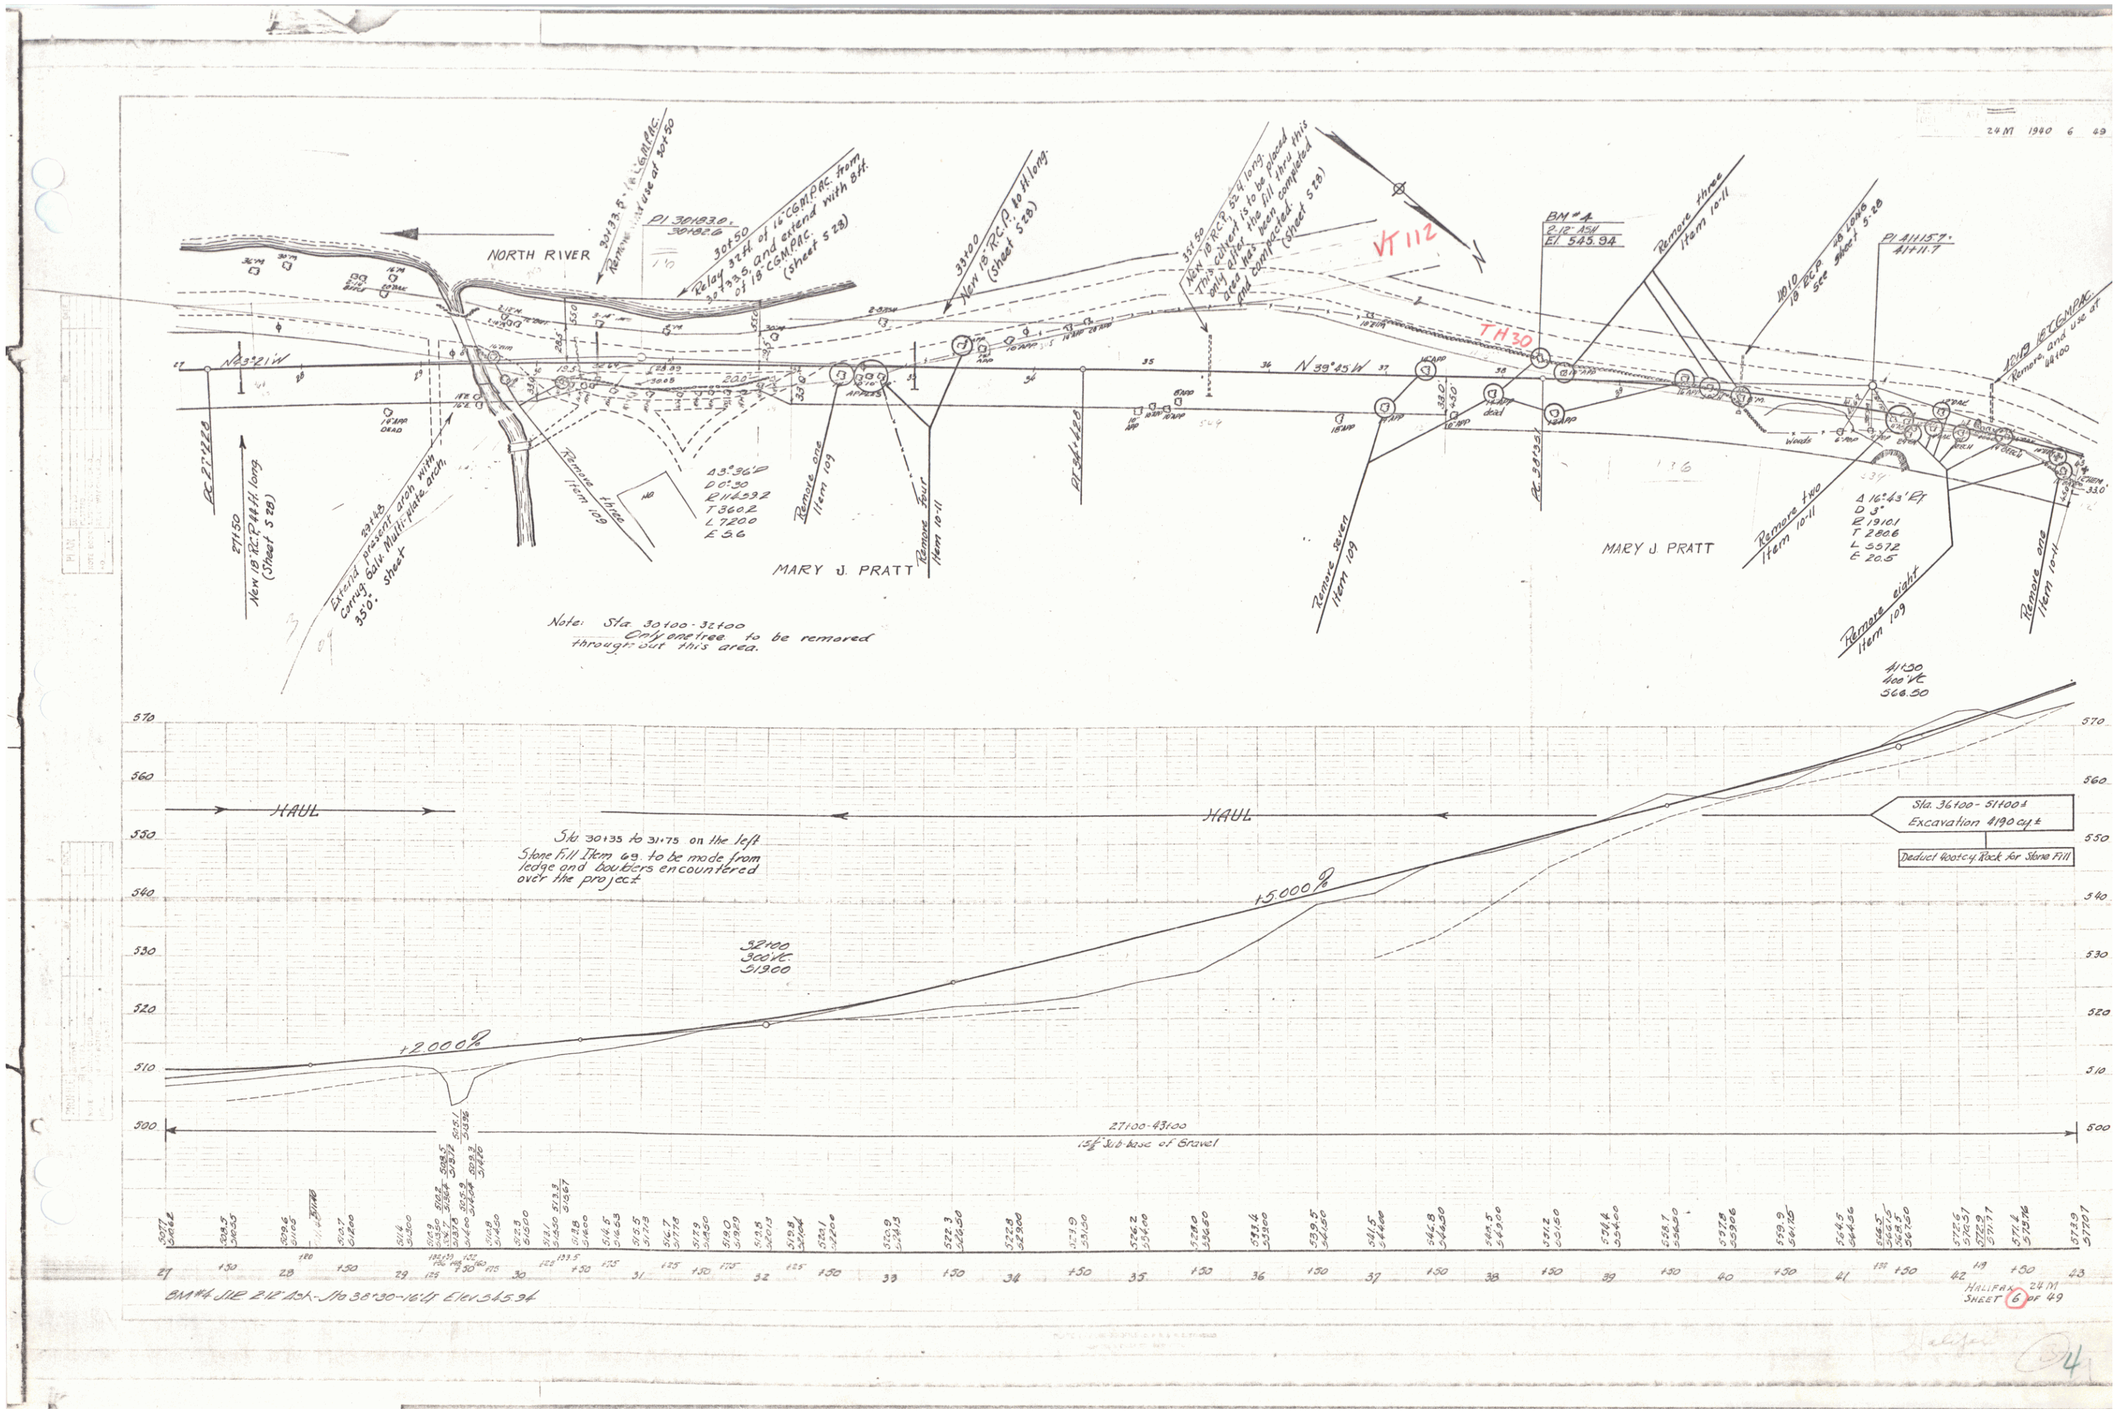
24 M 1960 6 49
NORTH RIVER
MARY J. PRATT
MARY J PRATT
Note: Sta 30+00-32+00 Only one tree to be removed throughout this area.
Remove three Item 109
Remove one Item 109
Remove four Item 10-11
Remove seven Item 109
Remove two Item 10-11
Remove eight Item 109
Remove one Item 10-11
Remove three Item 10-11
Extend present drain with corrug. Galv. Multi-plate arch, 35'0. Sheet
Relay 32 ft. of 16" CGMPAC. from 30+33 S. and extend with BH. of 18" CGMPAC. (Sheet S 28)
Nov 18" RCP 55' ll long. Only culvert is to be placed after the fill thru this area has been completed and compacted (Sheet S 28)
Nov 18" RCP 44' ll long (Sheet S 28)
Nov 18" RCP 55' ll long (Sheet S 28)
Remove and use of 30+50
BM #4
El. 545.94
Δ 16°43' Rt
D 3°
R 1910.1
T 280.6
L 557.2
E 20.5
4+50
400' VC
366.50
32+00
300' VC
319.00
+5.000%
+2.000%
HAUL
HAUL
Sta 30+35 to 31+75 on the left Stone fill Item 69. to be made from ledge and boulders encountered over the project
Sta. 36+00 - 51+00 Excavation 4190 cu.yd.
Deduct 400 cu.yd. Rock for Stone Fill
27+00-43+00
15" Sub-base of Gravel
BM #4 JUR 2½" Ash - Jlo 38+30-16'Lt Elev 545.94
HALIFAX 24 M
SHEET 6 of 49