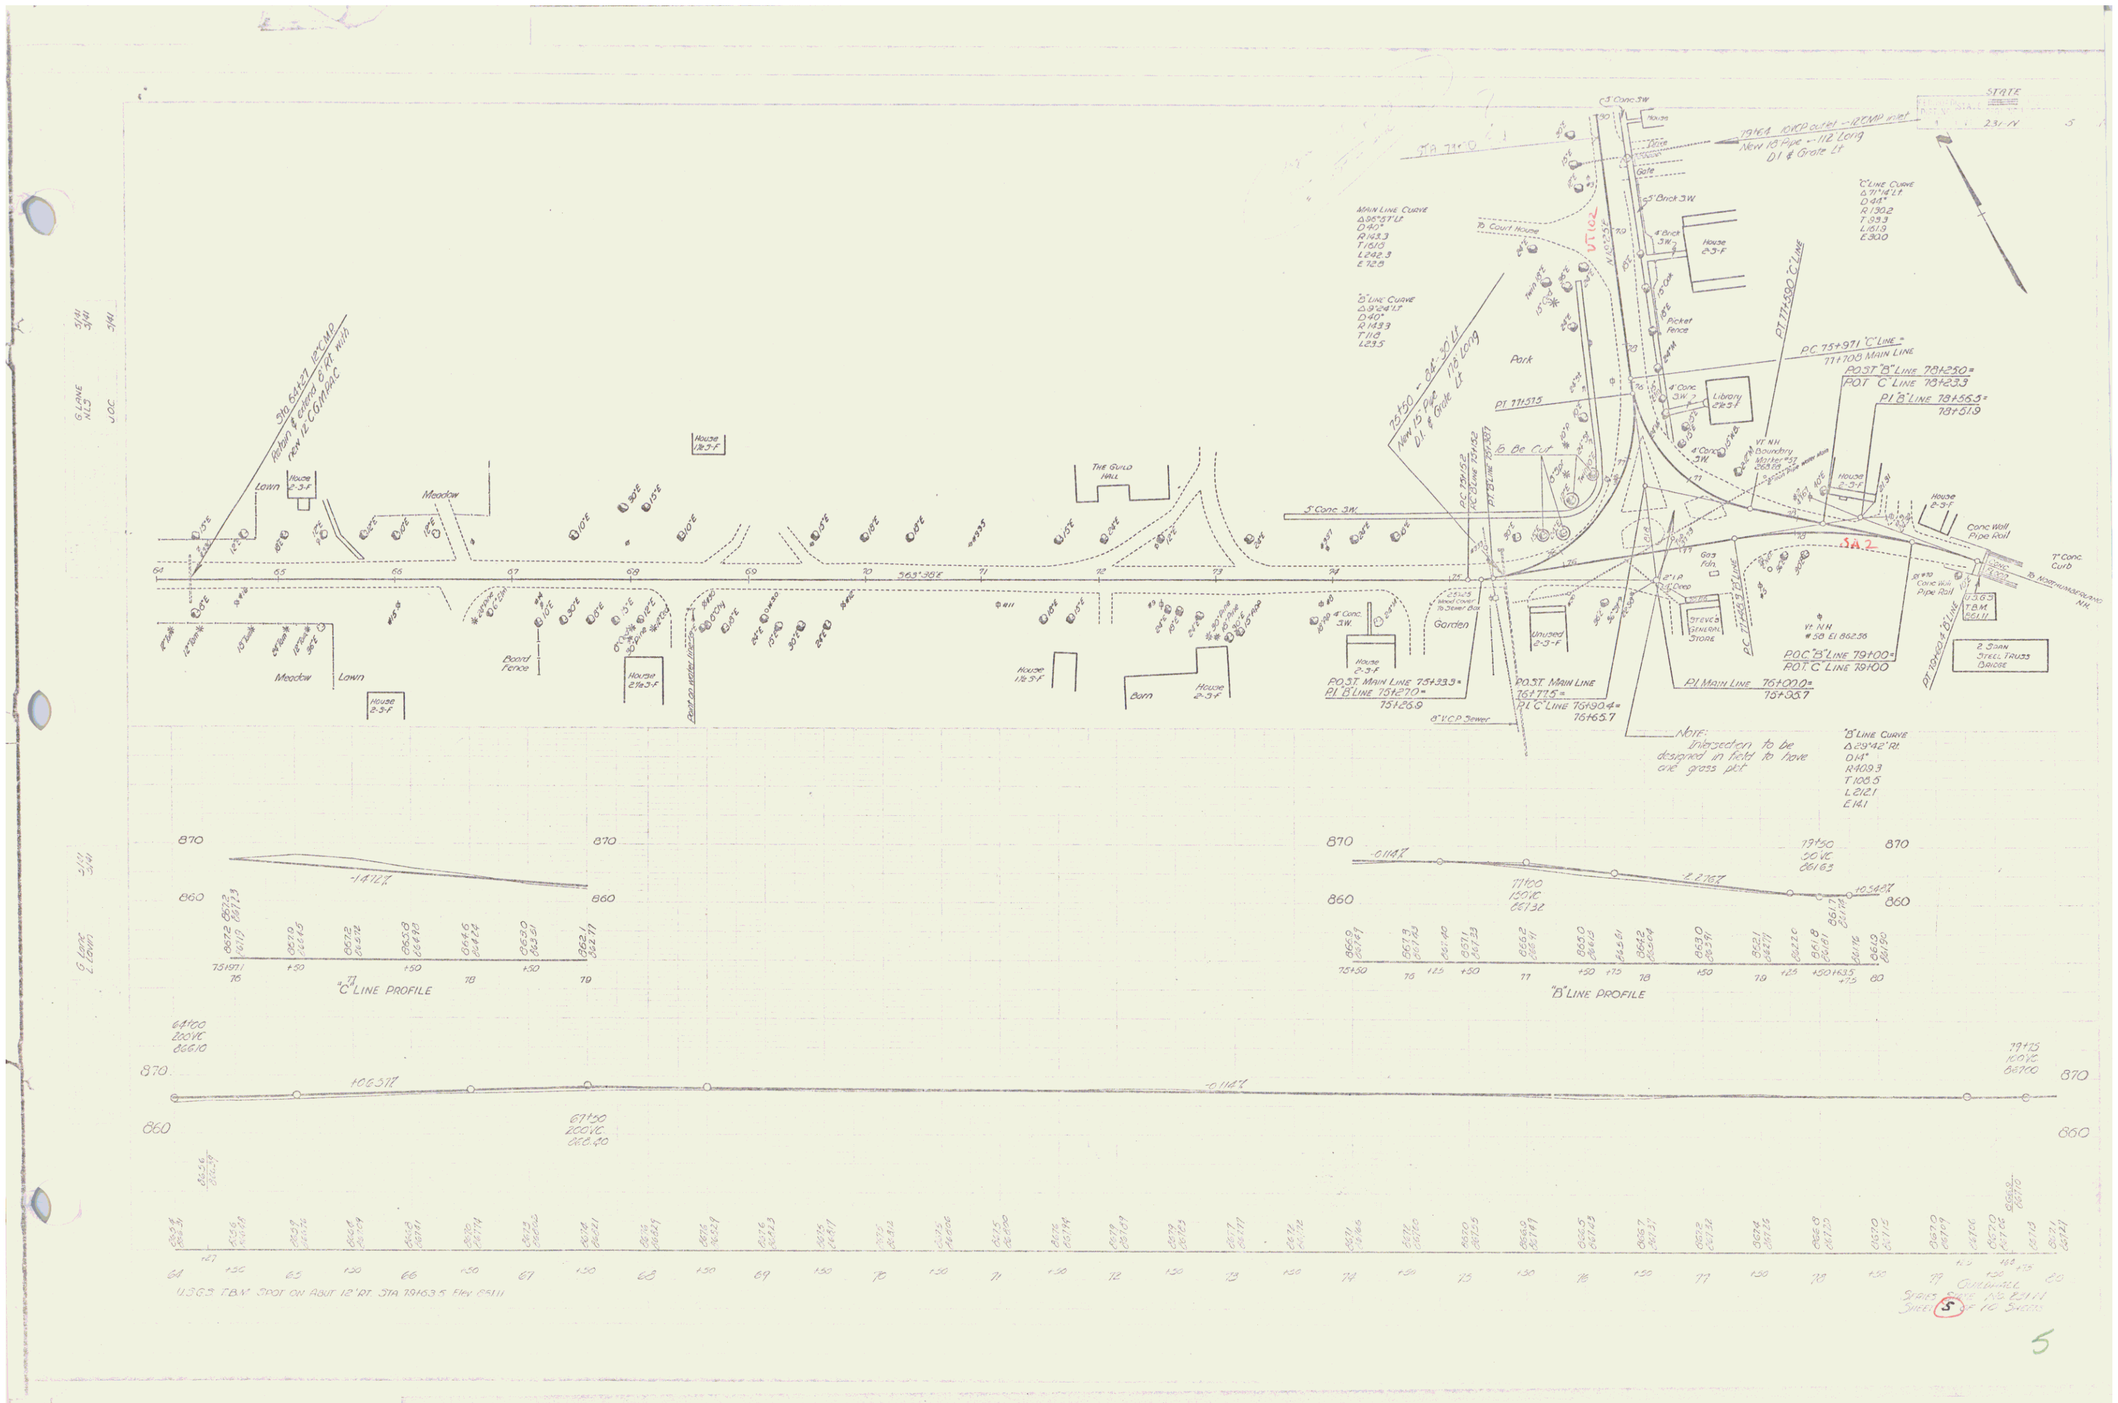
"C" LINE PROFILE
"B" LINE PROFILE
Park
Meadow
Lawn
Board Fence
Garden
Barn
Unused
Library
Gate
Picket Fence
Note: Intersection to be designed in field to have one grass pit
2 SPAN STEEL TRUSS BRIDGE
U.S.G.S. T.B.M. SPOT ON ABUT 12' RT. STA 79+63.5 Elev 861.11

5