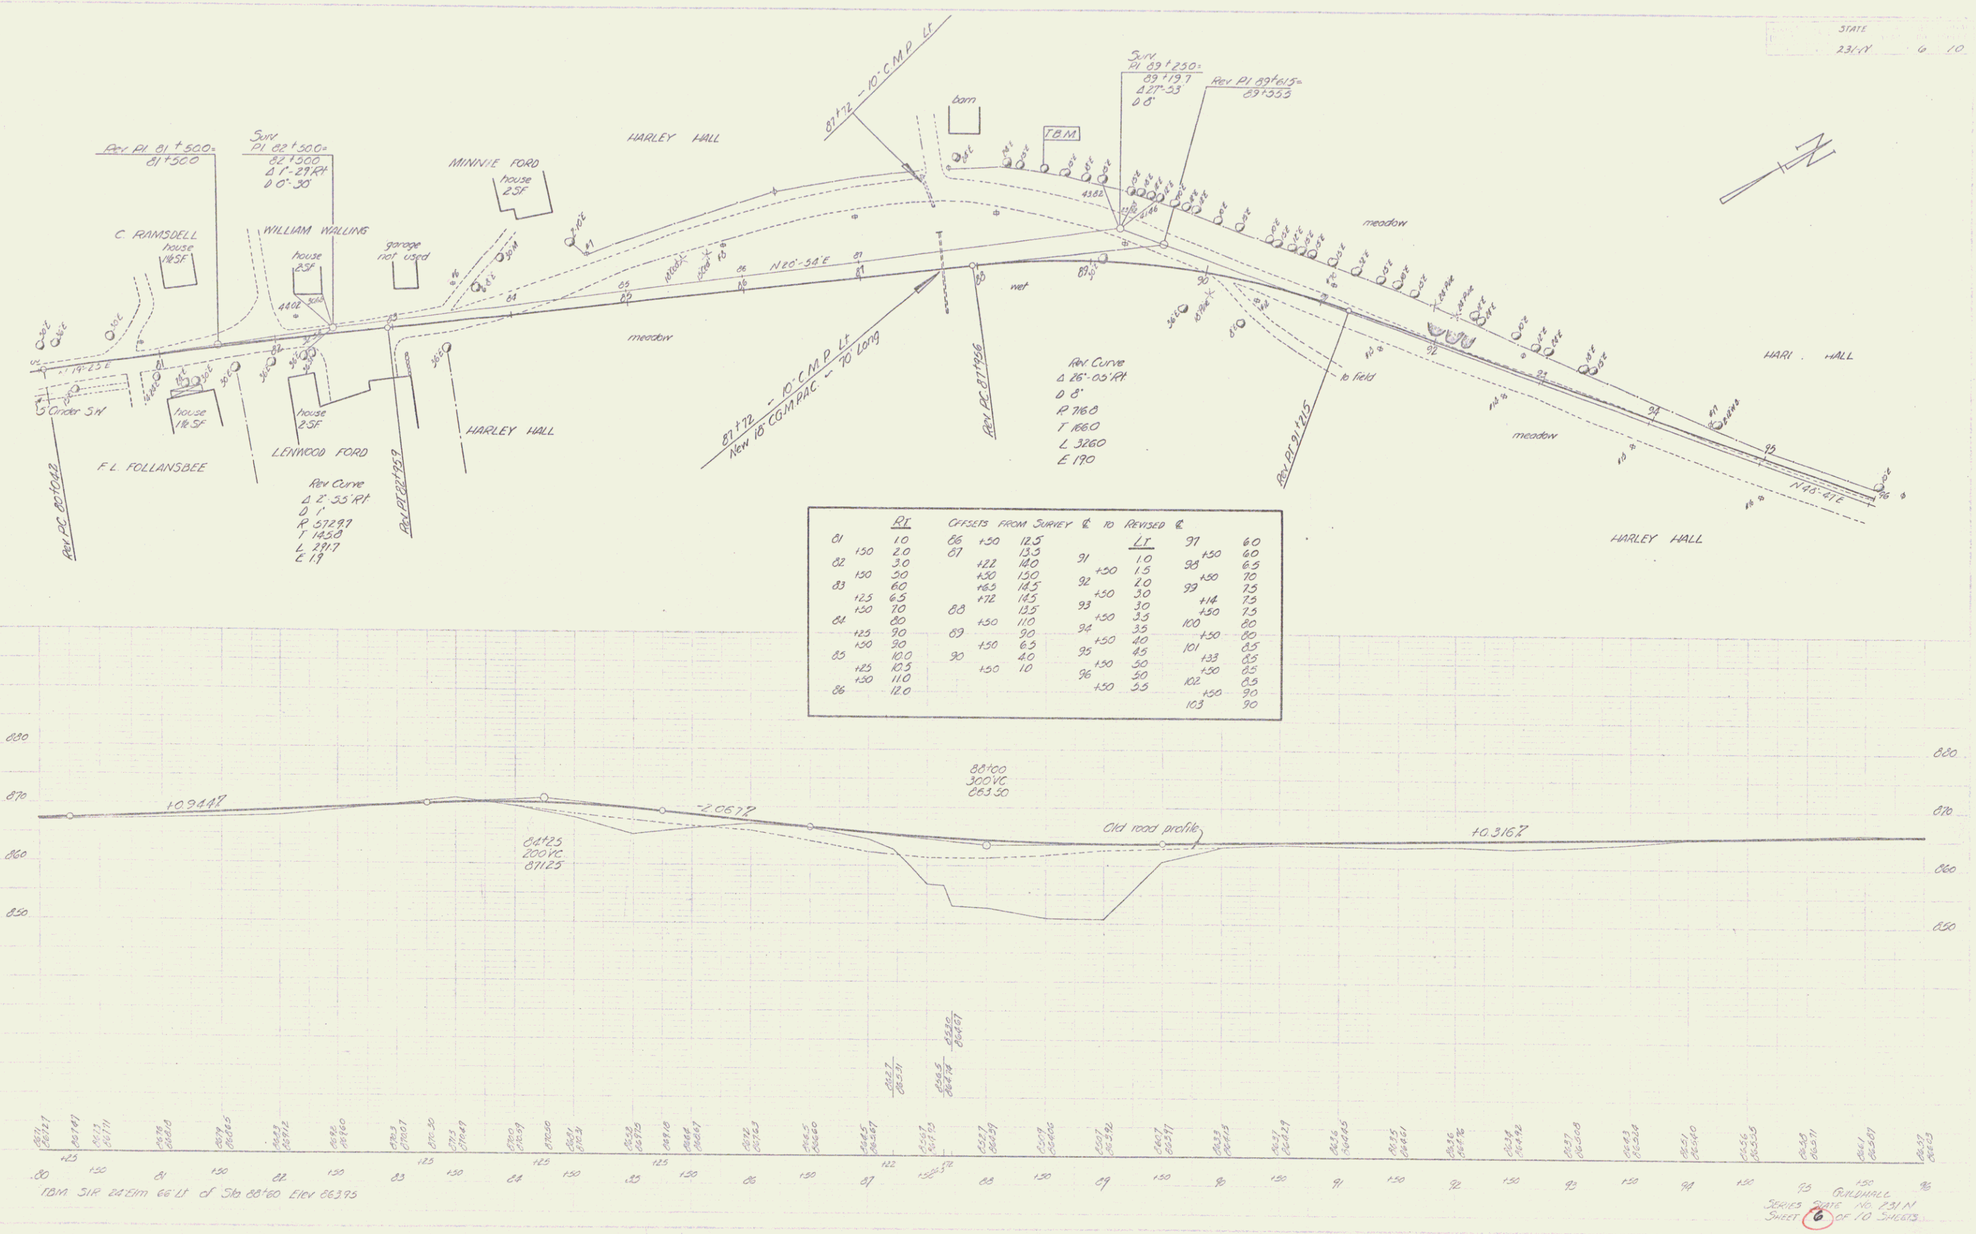

	Rt		Offsets from Survey ℄ to Revised ℄			Lt		
81		1.0	86	+50	12.5		97	6.0
	+50	2.0	87		13.5	91	+50	6.0
82		3.0		+22	14.0		98	6.5
	+50	5.0		+50	15.0	92	+50	7.0
83		6.0		+63	14.5		99	7.5
	+25	6.5		+72	14.5	93	+50	7.9
	+50	7.0	88		13.5		+14	7.5
84		8.0		+50	11.0	94	+50	8.0
	+25	9.0	89		9.0		100	8.0
	+50	9.0		+50	6.0	95	+50	8.5
85		10.0	90		4.0		101	8.5
	+25	10.5		+50	1.0	96	+50	8.5
	+50	11.0					102	8.5
86		12.0					+50	9.0
							103	9.0