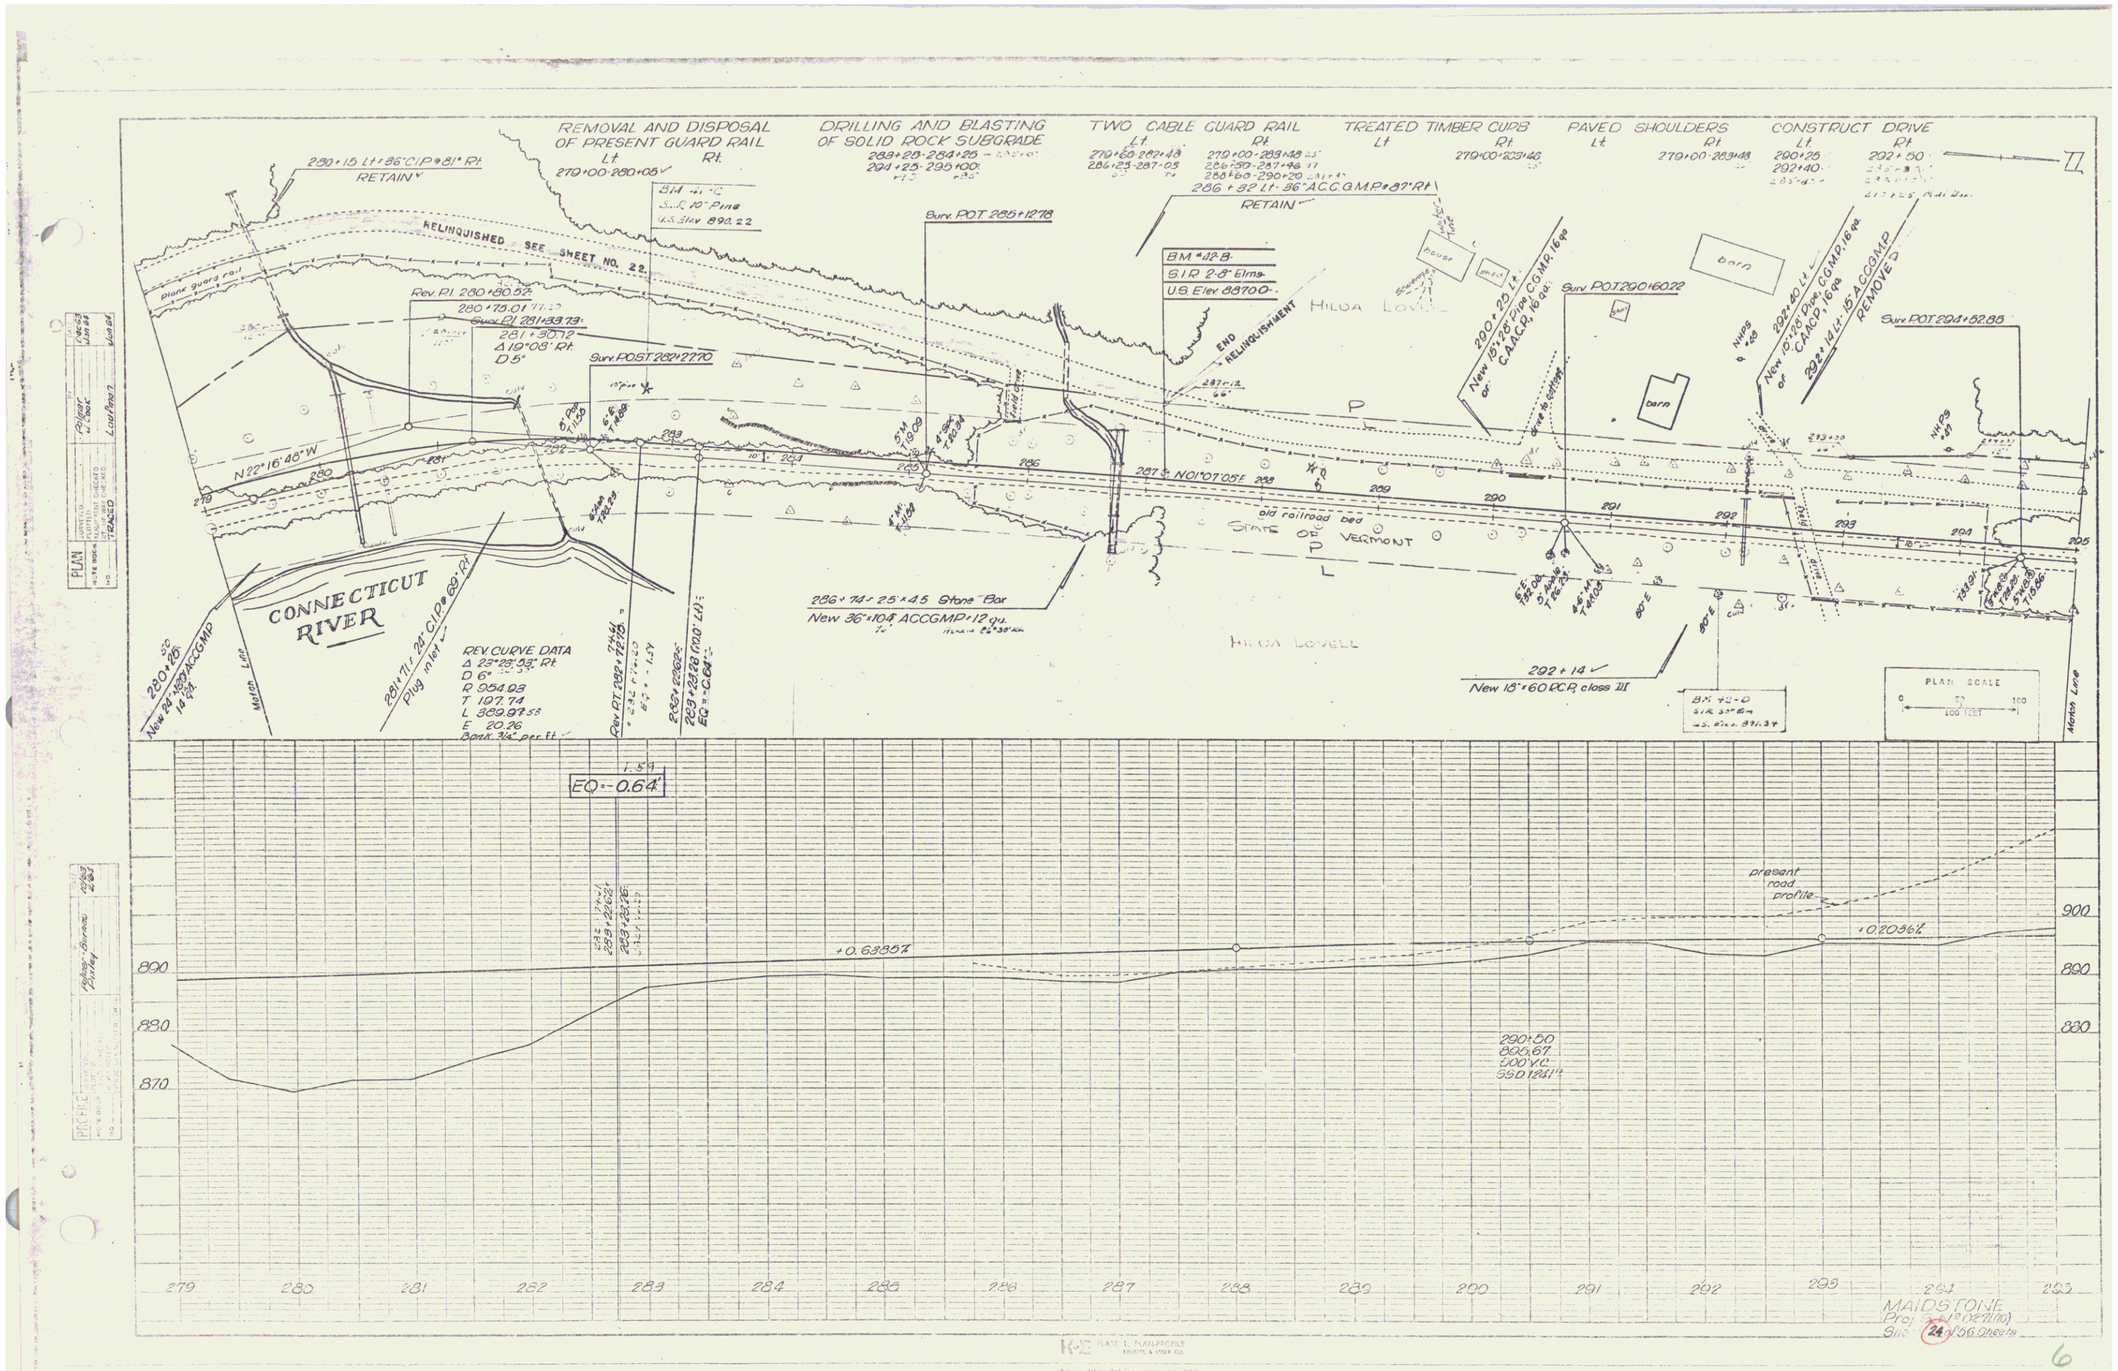

MAIDSTONE
Proj. No. 0271(10)
Sheet 24 of 56 Sheets

6