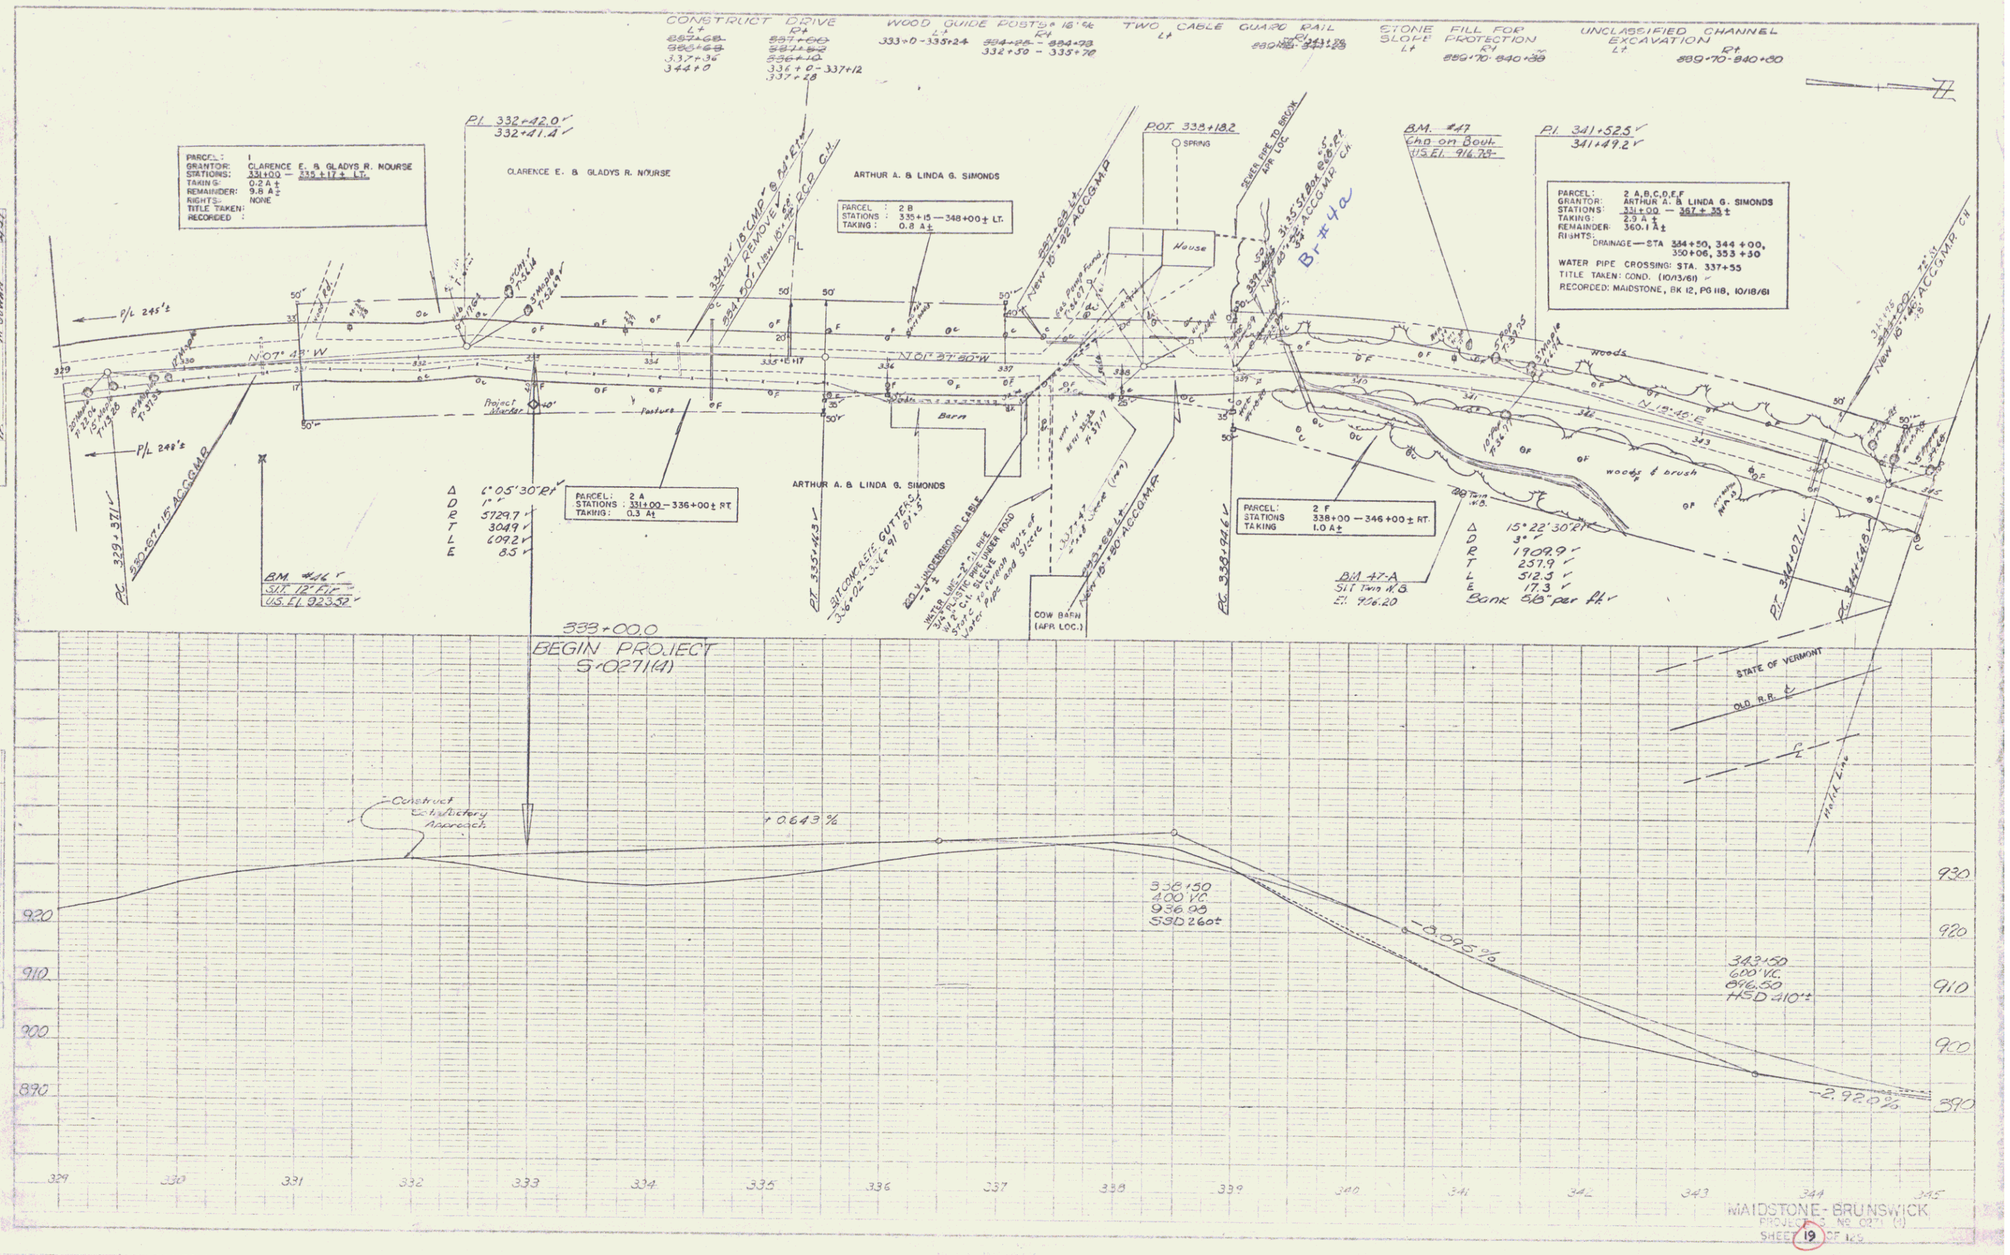
CONSTRUCT DRIVE
WOOD GUIDE POSTS @ 16'-6"
TWO CABLE GUARD RAIL
STONE FILL FOR SLOPE PROTECTION
UNCLASSIFIED CHANNEL EXCAVATION
PARCEL: 1
GRANTOR: CLARENCE E. & GLADYS R. NOURSE
STATIONS: 331+00 — 335+17 ± LT.
TAKING: 0.2 A ±
REMAINDER: 9.8 A ±
RIGHTS: NONE
TITLE TAKEN:
RECORDED:
CLARENCE E. & GLADYS R. NOURSE
ARTHUR A. & LINDA G. SIMONDS
PARCEL: 2 B
STATIONS: 335+15 — 348+00 ± LT.
TAKING: 0.8 A ±
P.I. 332+42.0
332+41.4
P.O.T. 338+18.2
SPRING
House
Barn
Pasture
Project Marker
BM. #47
Chs on Bout.
Elev. 916.75
P.I. 341+52.5
341+49.2
PARCEL: 2 A,B,C,D,E,F
GRANTOR: ARTHUR A. & LINDA G. SIMONDS
STATIONS: 331+00 — 367 + 35 ±
TAKING: 2.9 A ±
REMAINDER: 360.1 A ±
RIGHTS:
DRAINAGE — STA 344+50, 344+00, 350+06, 353+30
WATER PIPE CROSSING: STA. 337+55
TITLE TAKEN: COND. (10/13/61)
RECORDED: MAIDSTONE, BK 12, PG 118, 10/18/61
Br #42
PARCEL: 2 A
STATIONS: 331+00 — 336+00 ± RT.
TAKING: 0.3 A ±
PARCEL: 2 F
STATIONS 338+00 — 346+00 ± RT.
TAKING 1.0 A ±
Woods
Woods & brush
N 19°-40' E
N 07° 41' W
N 01° 27' 30" W
P/L 245'±
P/L 248'±
BM #46
S.I.T. 12" Fir
U.S. El. 923.52
BM 47-A
S.I.T. Twin W.B.
El. 906.20
Bank 6.8' per ft.
COW BARN (APR. LOC.)
333+00.0
BEGIN PROJECT
S-0271(4)
STATE OF VERMONT
OLD R.R.
Matt. Line
+0.643%
-0.095%
-2.920%
336+50
400' V.C.
936.99
SSD 260±
343+50
600' V.C.
896.50
HSD 410±
920
910
900
890
329
330
331
332
333
334
335
336
337
338
339
340
341
342
343
344
345
MAIDSTONE - BRUNSWICK
PROJECT S-0271 (4)
SHEET 19 OF 165

2