




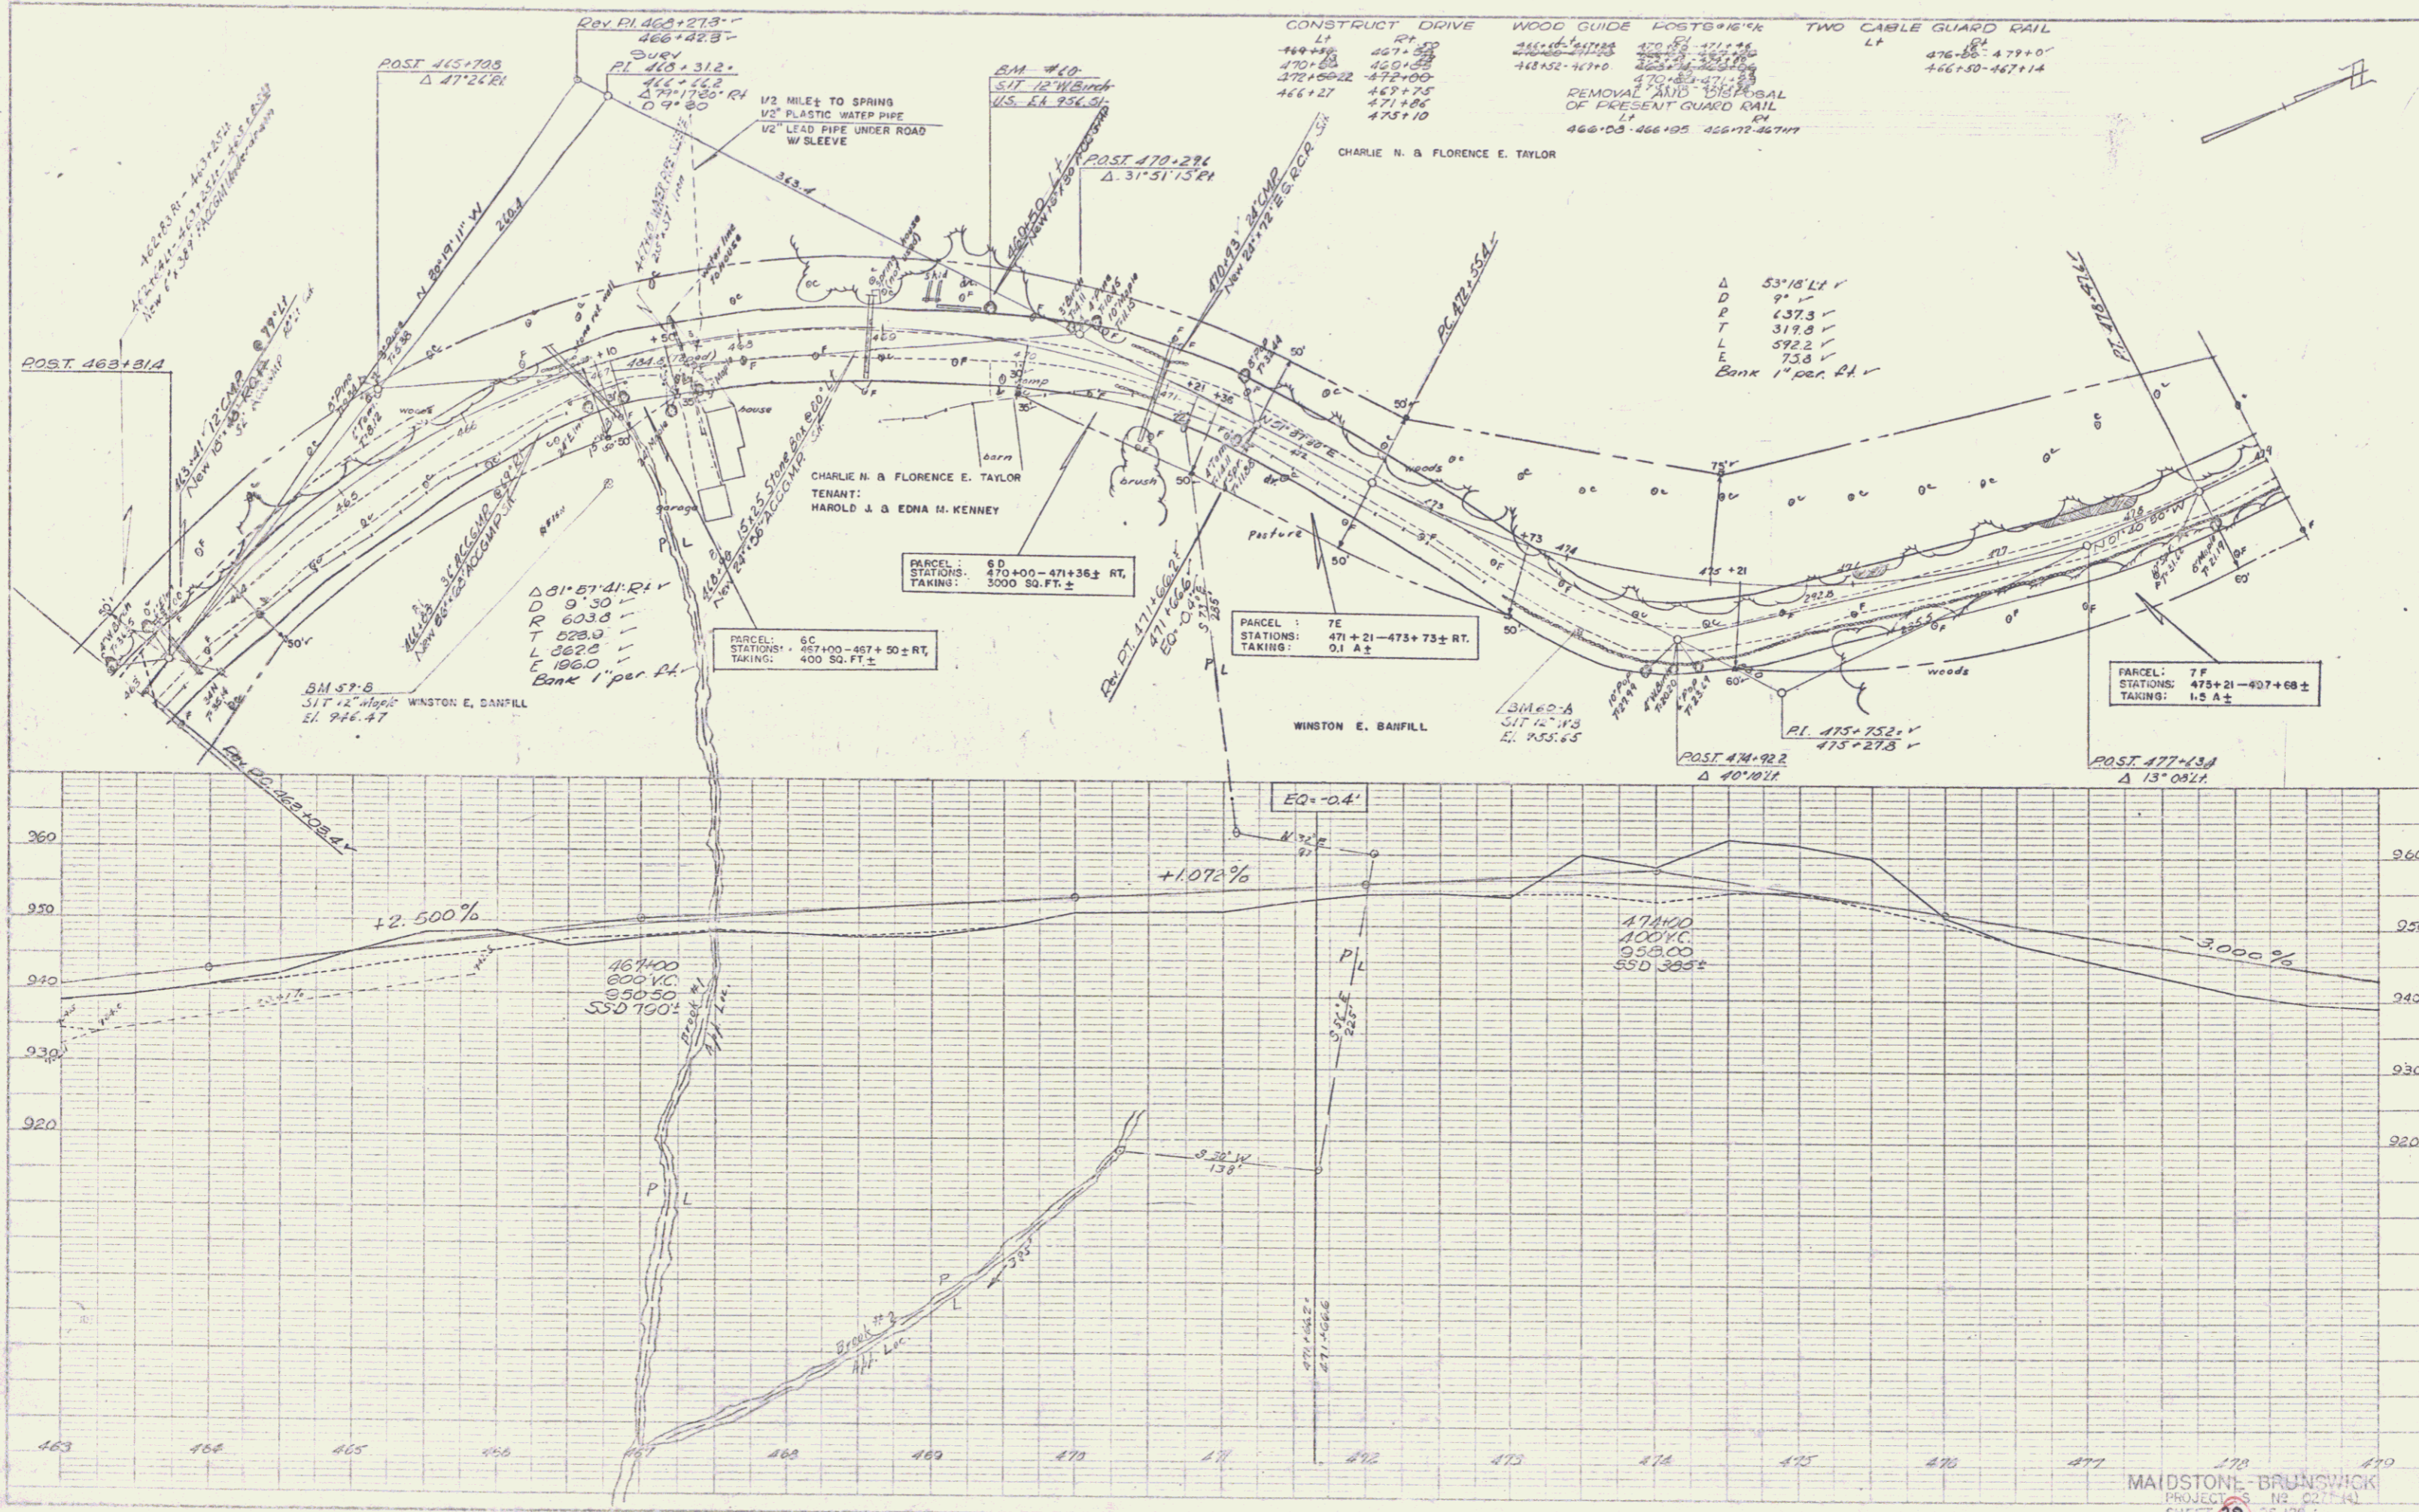

466+27	467+75	471+86	475+10

Δ 53'18" LI ✓
 D 9' ✓
 T 319.8 ✓
 L 592.2 ✓
 E 73.8 ✓
 Bank 1" per ft ✓