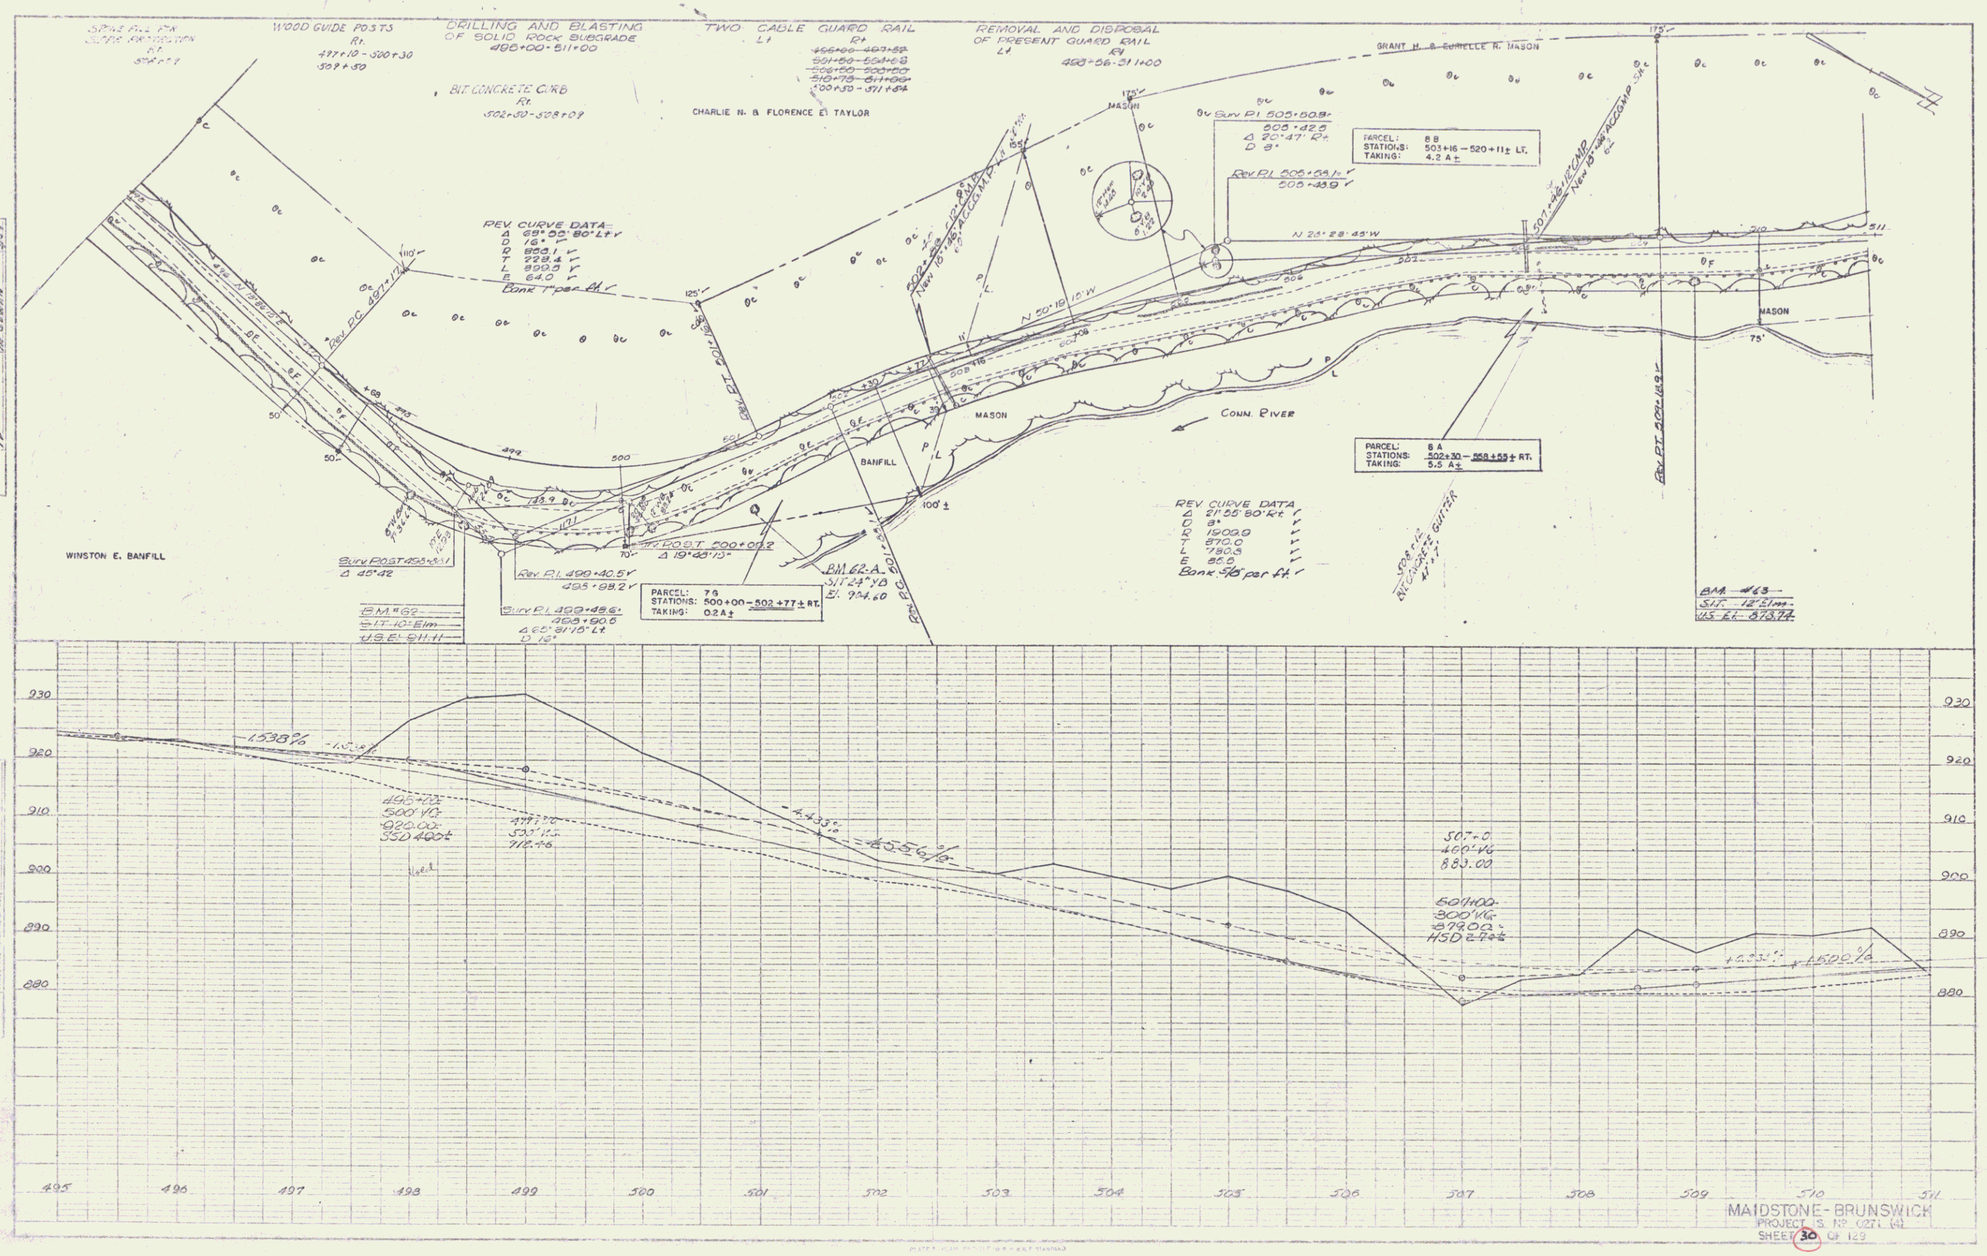

MAIDSTONE - BRUNSWICK
PROJECT S. NP. 0271 (4)
SHEET 30 OF 129

13