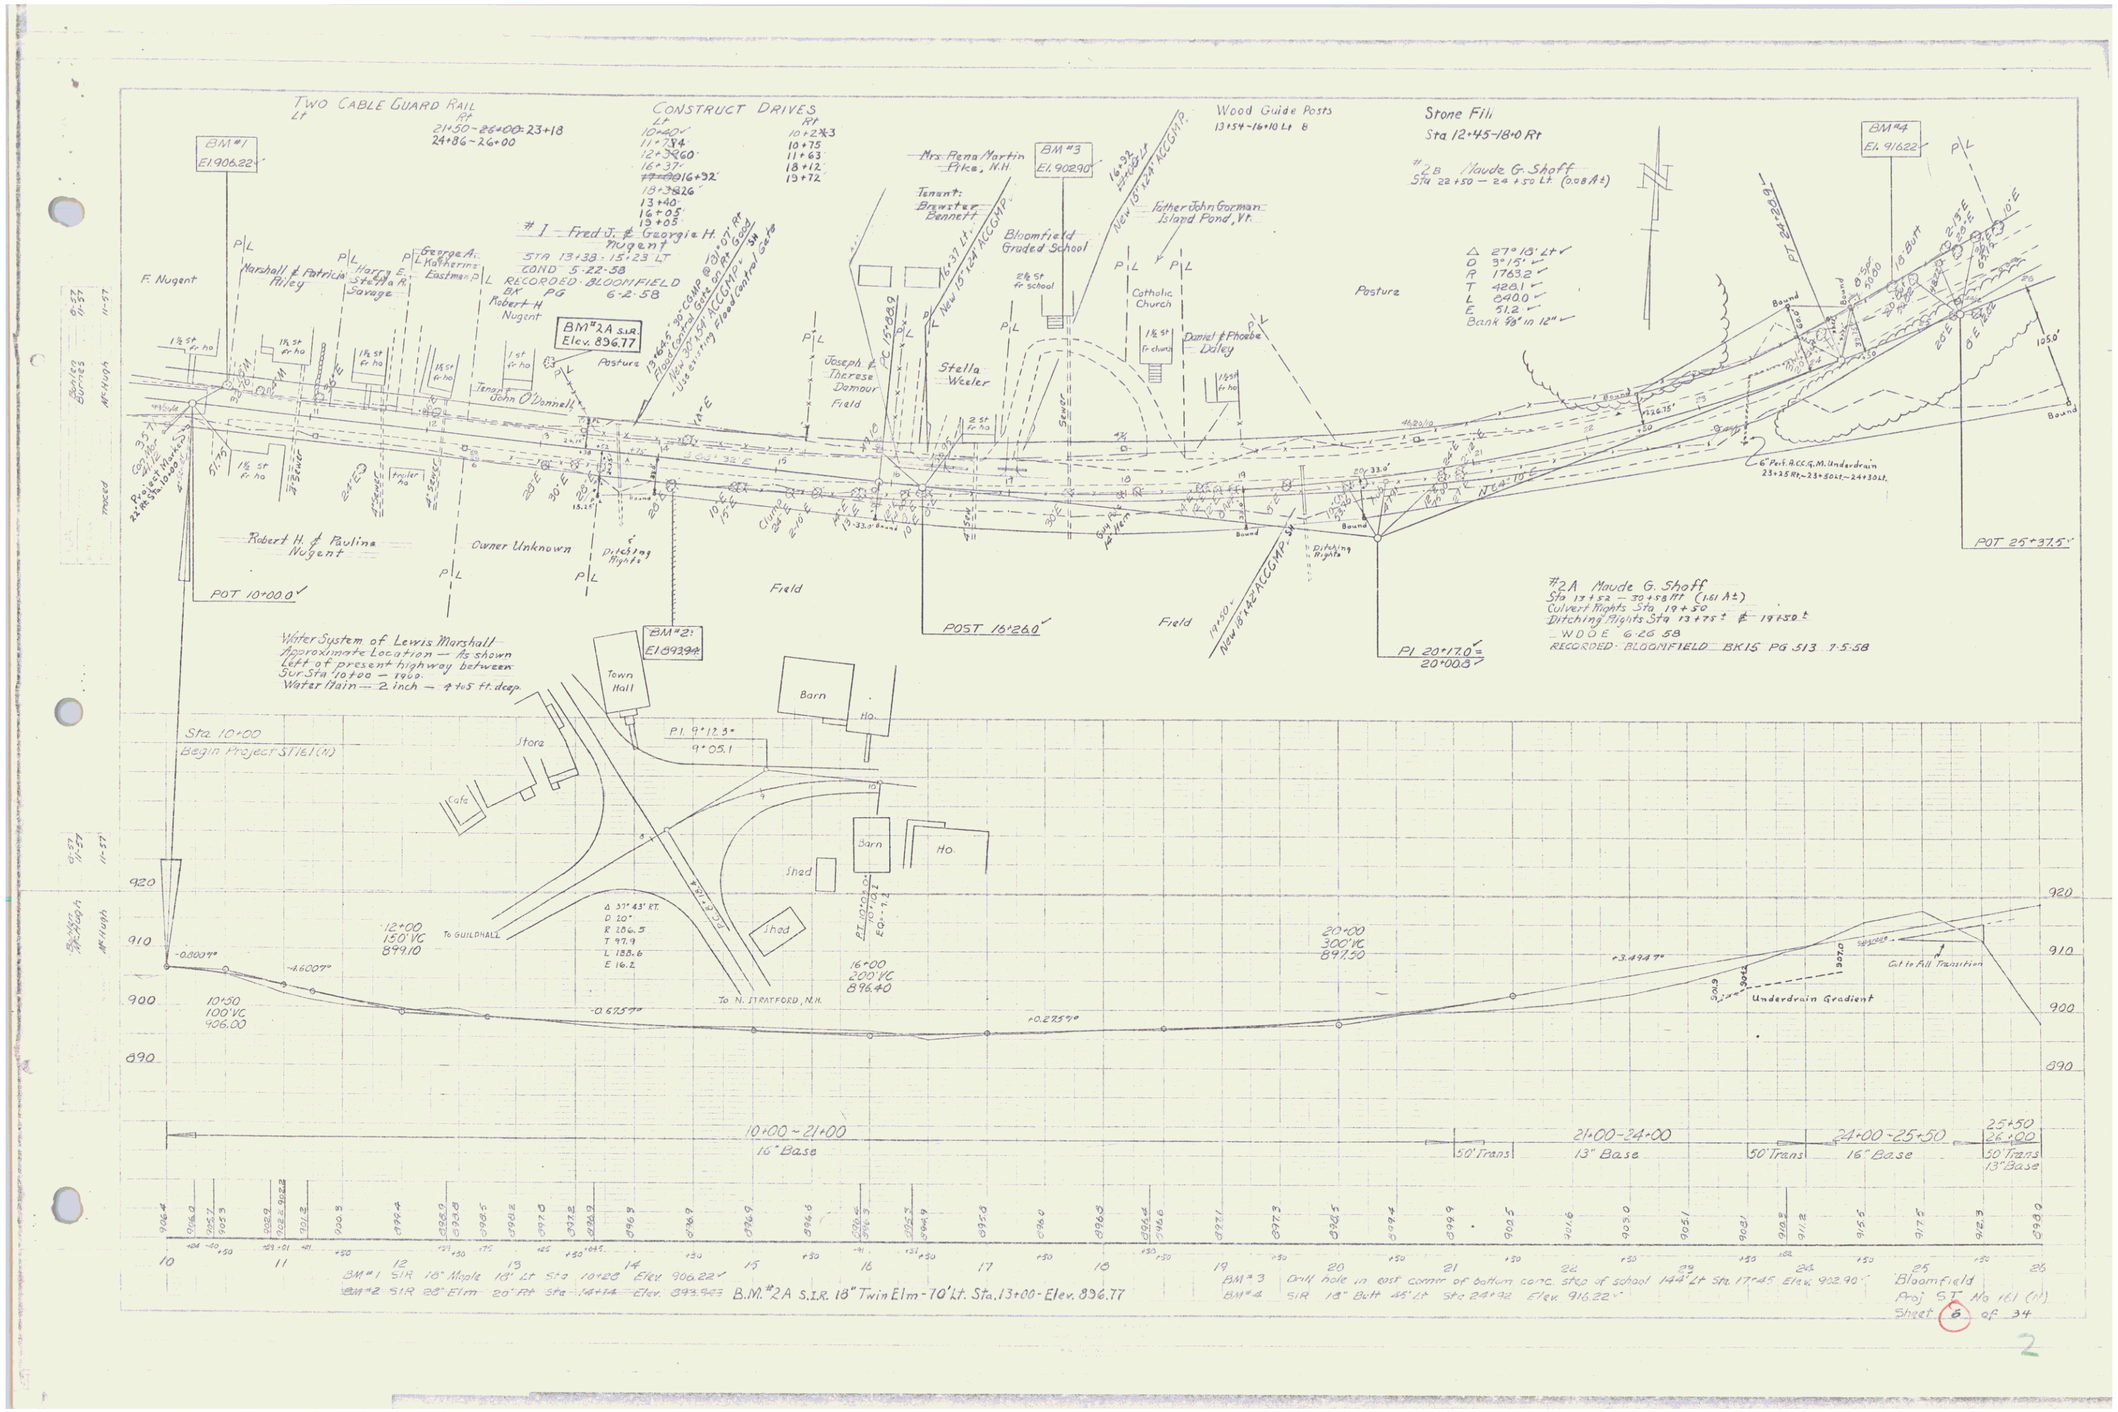

TWO CABLE GUARD RAIL
CONSTRUCT DRIVES
Wood Guide Posts
Stone Fill
Sta 12+45-18+0 Rt
#2B Maude G. Shaff
Sta 22+50 — 24+50 Lt. (0.08 A±)
BM #1 El. 906.22
BM #2A S.I.R. Elev. 896.77
BM #3 El. 902.90
BM #4 El. 916.22
#1 Fred J. & Georgie H. Nugent
STA 13+38 - 15+23 LT
COND 5-22-58
RECORDED BLOOMFIELD BK PG 6-2-58
Mrs. Rena Martin Pike, N.H.
Tenant: Brewster Bennett
Bloomfield Graded School
Father John Gorman Island Pond, Vt.
Catholic Church
Daniel & Phoebe Daley
Joseph & Therese Damour
Stella Weeler
Robert H. & Pauline Nugent
Owner Unknown
Ditching Rights
Field
Pasture
F. Nugent
Marshall & Patricia Riley
Harry E. & Stella R. Savage
George A. & Katherine Eastman
Robert H. Nugent
Tenant John O'Donnell
POT 10+00.0
POST 16+26.0
PI 20+17.0 = 20+00.8
POT 25+37.5
#2A Maude G. Shaff
Sta 13+52 — 30+58 Rt (1.61 A±)
Culvert Rights Sta 19+50
Ditching Rights Sta 13+75± & 19+50±
WDOE 6-26-58
RECORDED BLOOMFIELD BK15 PG 513 7-5-58
Water System of Lewis Marshall
Approximate Location — As shown
Left of present highway between
Sur Sta 10+00 — 1960.
Water Main — 2 inch — 4 to 5 ft. deep.
Sta 10+00
Begin Project ST161(N)
Town Hall
Barn
Ho.
Store
Cafe
Shed
To GUILDHALL
To N. STRATFORD, N.H.
12+00 150' VC 899.10
16+00 200' VC 896.40
20+00 300' VC 897.50
10+50 100' VC 906.00
Underdrain Gradient
Cut to Fill Transition
10+00 - 21+00 16" Base
21+00 - 24+00 13" Base
24+00 - 25+50 16" Base
25+50 26+00 50' Trans 13" Base
BM #1 SIR 18" Maple 18' Lt Sta 10+28 Elev. 906.22
BM #2 SIR 28" Elm 20' Rt Sta 14+14 Elev. 893.94
B.M. #2A S.I.R. 18" Twin Elm - 70' Lt. Sta. 13+00 - Elev. 896.77
BM #3 Drill hole in east corner of bottom conc. step of school 144' Lt Sta. 17+45 Elev. 902.90
BM #4 SIR 18" Butt 45' Lt Sta 24+92 Elev. 916.22
Bloomfield
Proj ST No 161 (N)
Sheet 6 of 34

2