WOOD GUARD RAIL REQUIRED

CULV. STA.	LT.	RT.
3+22	24 ft.	24 ft.
8+69	—	24 ft.
7+50	—	24 ft.

CABLE GUARD RAIL REQUIRED

STATIONS	L+R	LENG.	CONST.	PAY LENG.
6+02-7+62	LT	160	40	200 ft.
8+20-9+00	LT	80	40	120 "
12+50-13+00	LT	50	20	70 "

REINFORCED CONCRETE PIPE REQUIRED

STATION	DIAM.	LENG.	CEMENT RUBBLE MASONRY
3+22	18"	52 ft.	3.5 C.Y.
8+69	24"	44 ft.	4.5 "
7+50	15"	36 ft.	2.7 "

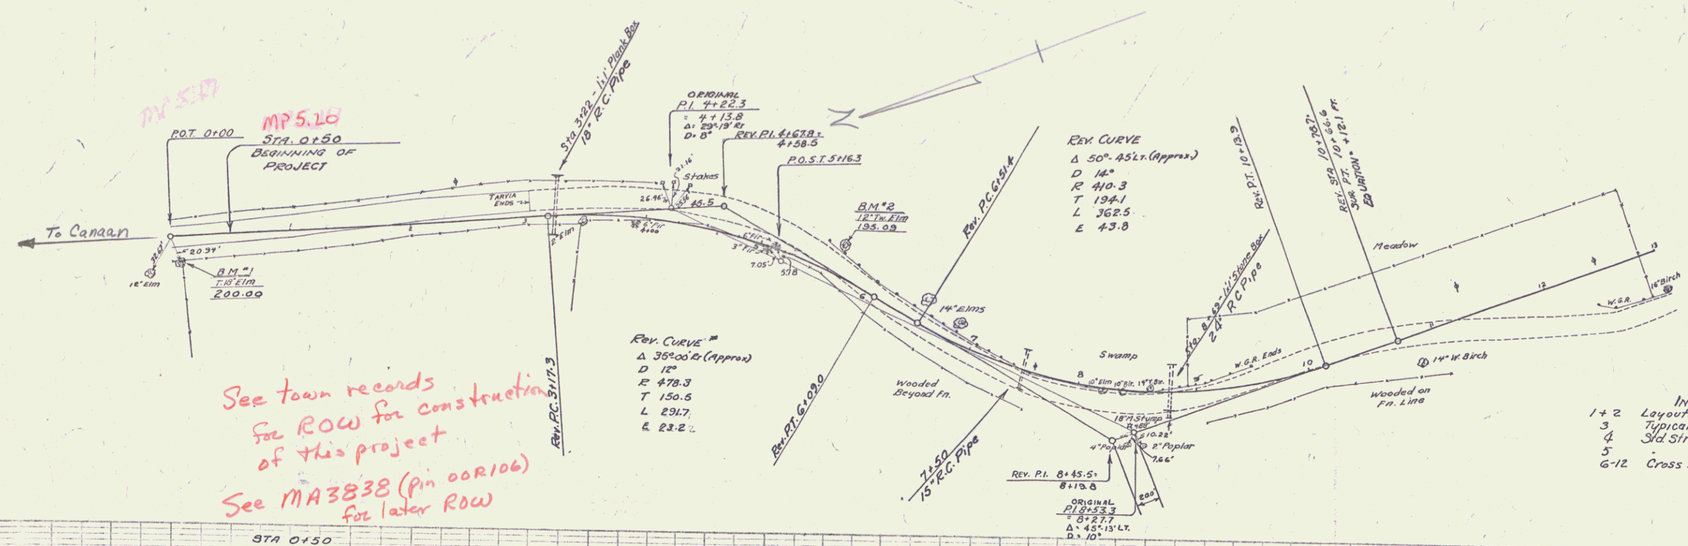

INDEX OF SHEETS

1+2	Layouts + Profile
3	Typical Section (2:1 ft Gravel)
4	Std. Structure Sheet S-20 Pipe Culv.
5	" " " S-22 Guard Rail
6-12	Cross Sections

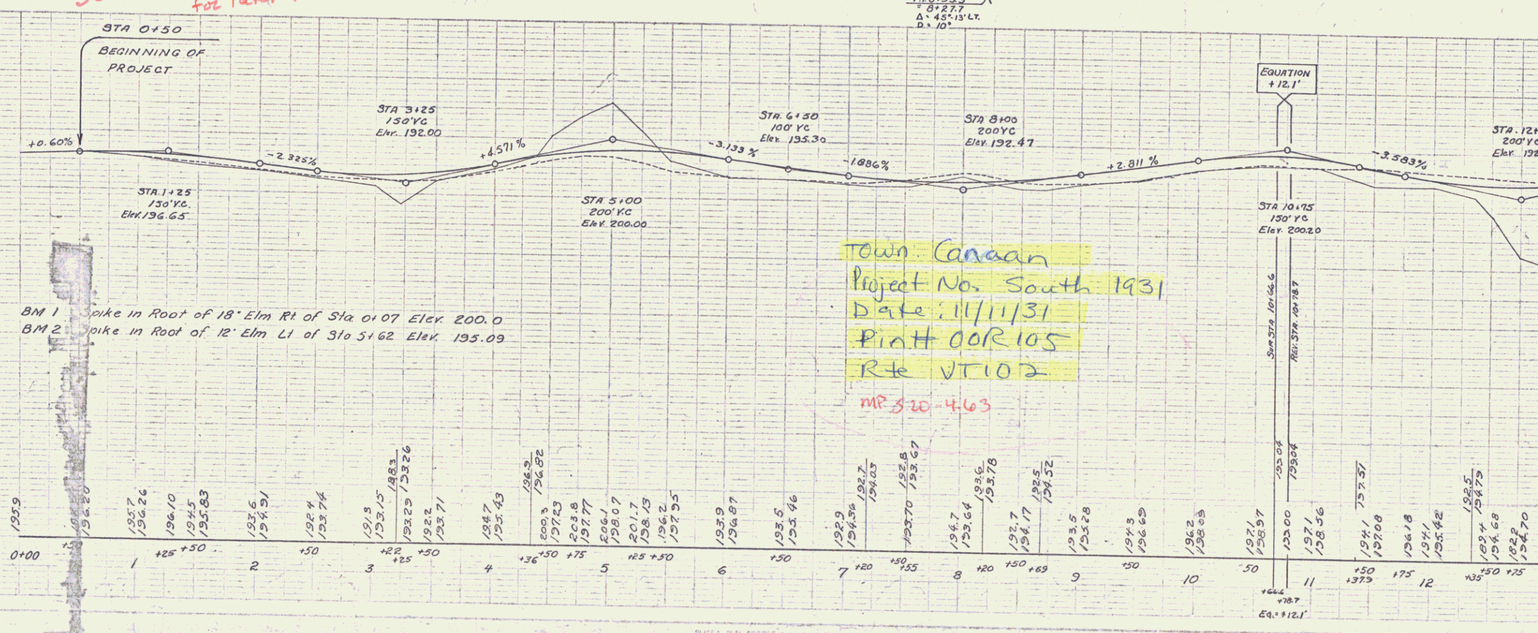

BM 1 Spike in Root of 18" Elm Rt of Sta 0+07 Elev. 200.0
BM 2 Spike in Root of 12" Elm Lt of Sta 5+62 Elev. 195.09

TOWN: Canaan
Project No. South 1931
Date: 11/11/31
Pin # 00R105
Rte VT102
MP 5.20-4.63

DIST #9 PLANS 1