RIGHT-OF-WAY DIVISION
TOWN FILE
PERPETUAL
FORM OF
(To Be Returned To R.O.W. Division)

WOOD GUARD RAIL REQUIRED

CULV. STA.	LT.	RT.
13+22	—	24 ft.
17+05	—	24 "
21+55	—	24 "
23+58	24 ft.	24 "

CABLE GUARD RAIL REQUIRED

STATIONS	LT. OR RT.	LENG.	QUAT.	PAY LENGTH
13+00-13+62	LT	62'	40'	102 ft.
16+90-19+30	LT	240	40	280 "
20+80-22+80	LT	200	40	240 "

REINFORCED CONCRETE PIPE REQUIRED

STATION	DIAM.	LENGTH	EXCAVATION & RUBBLE MASONRY
13+22	18"	88 ft.	3.5 c.y.
21+55	18"	52 "	3.5 c.y.
17+05	18"	48 "	3.6 c.y.
23+58	30"	56 "	5.0 c.y.

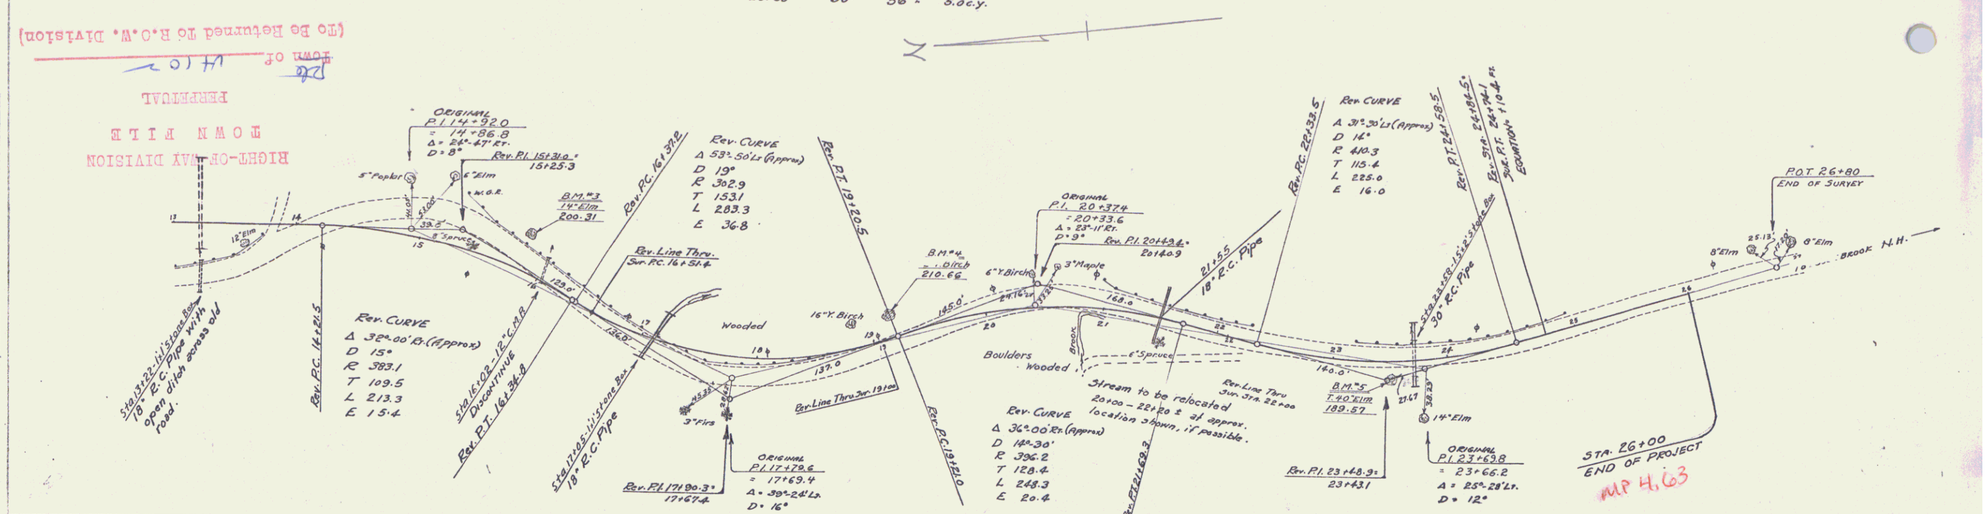

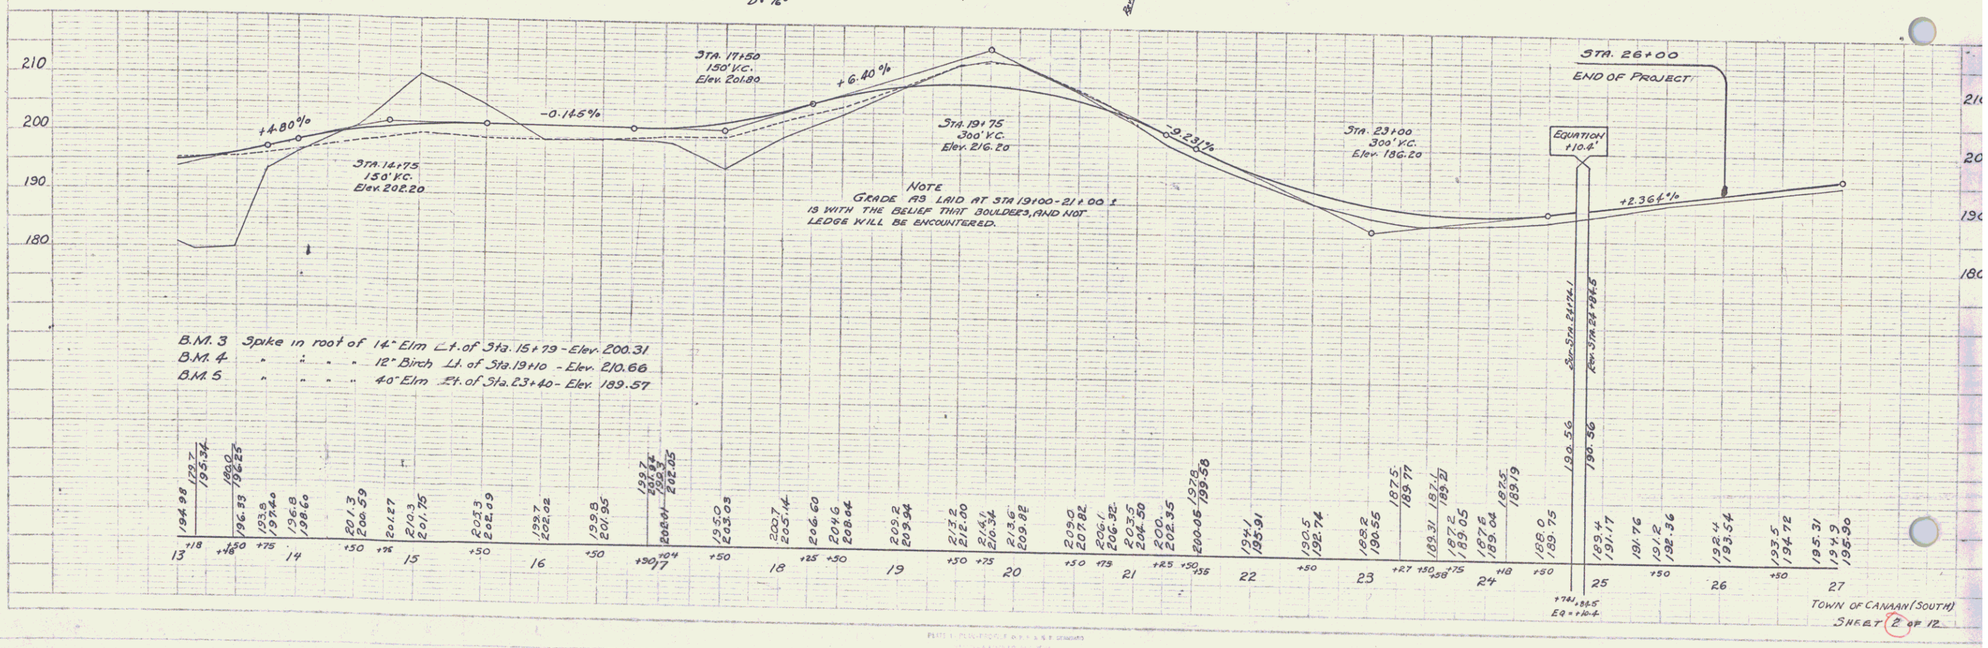

TOWN OF CANAAN (SOUTH)
SHEET 2 OF 12

CANAAN (SOUTH)
2