MARTHA L. VANDERWOLK
PARCELS
1A 0.22A±
1B 0.07A±
TOTAL 0.29A±

ECCOMMUNITY INC.
PARCEL 2 0.15A±

W.D. DATED 11/21/77 RECORDED IN BOOK 27, PAGE 446 ON 11/28/77.

OPTION DATED 10/7/77 RECORDED IN BOOK 27 PAGE 503-4 ON 3/3/78.

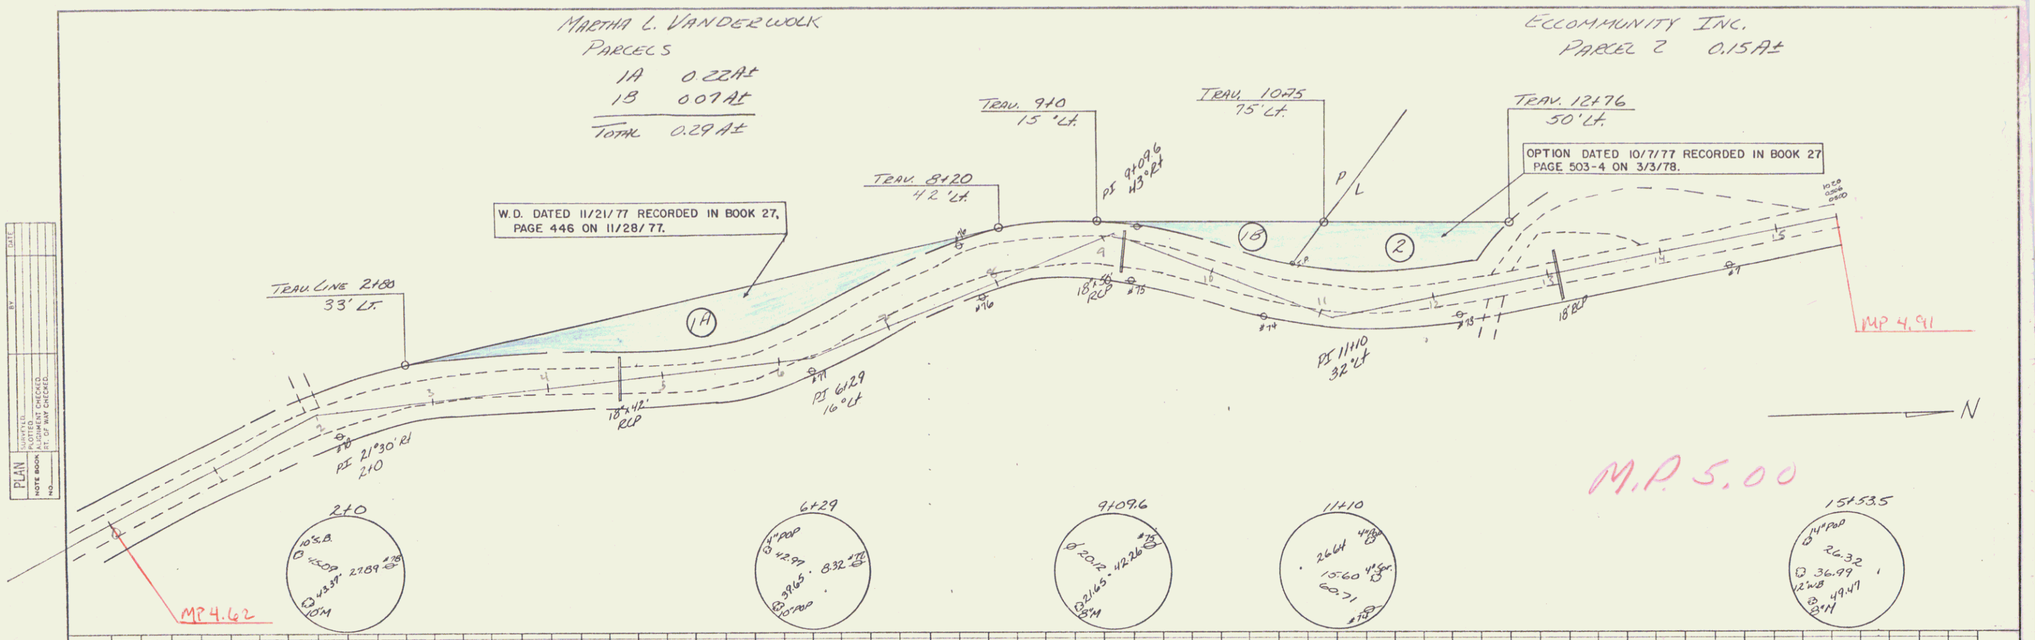

TOWN OF CANAAN
Project MA3838
Pin# 00R106
Route VT102
Date 11/7/1977

SHEET 1

CANAAN Rte 102
1

PLATE 1, PLAN-PROFILE