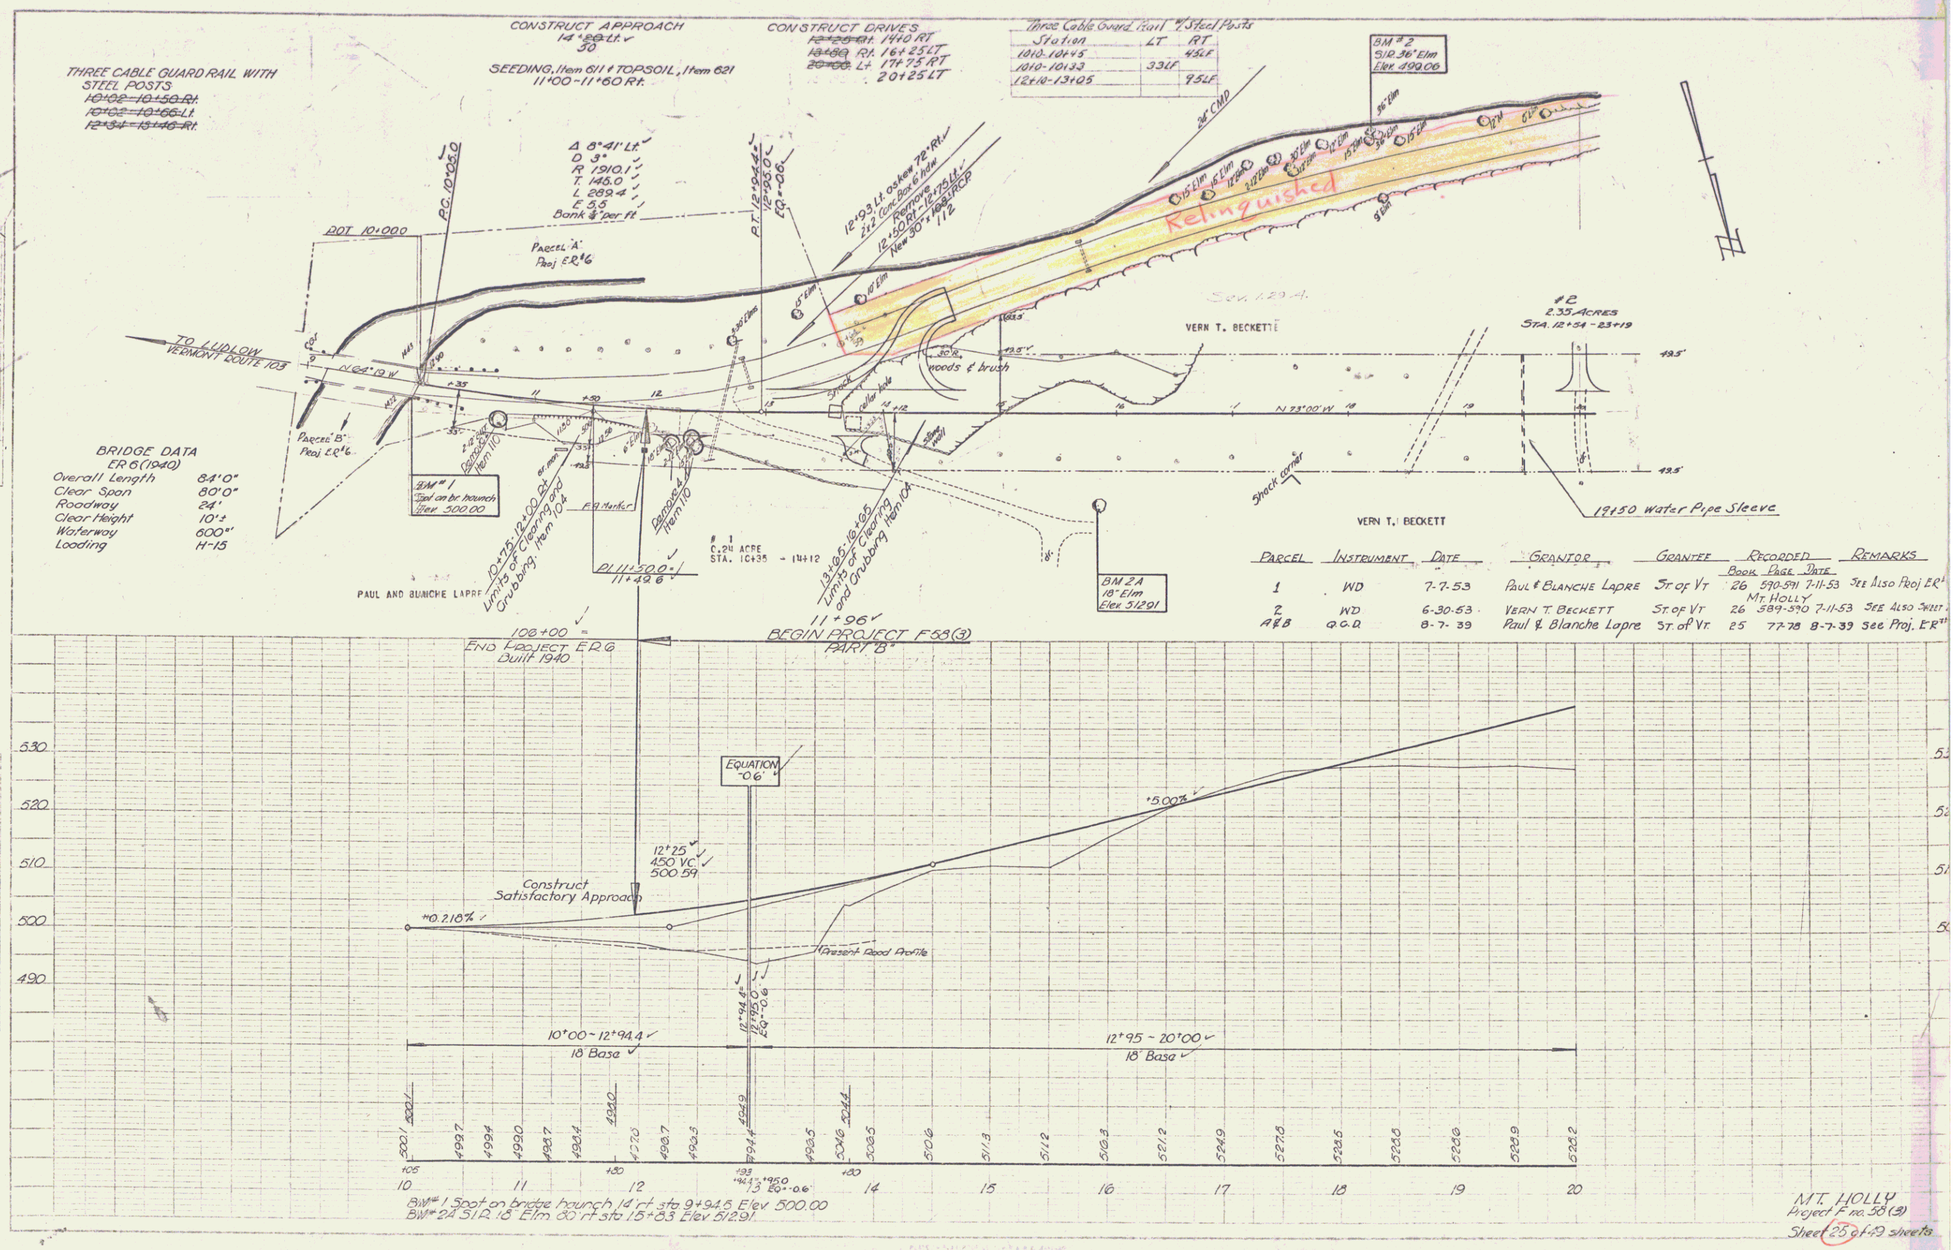

Parcel	Instrument	Date	Grantor	Grantee	Recorded Book	Page	Date	Remarks
1	WD	7-7-53	Paul & Blanche Lapre	St. of Vt	26	590-591	7-11-53	See Also Proj E.R.
2	WD	6-30-53	Vern T. Beckett	St. of Vt	26	589-590	7-11-53	See Also Sheet
A&B	Q.C.D.	8-7-39	Paul & Blanche Lapre	St. of Vt.	25	77-78	8-7-39	See Proj. E.R.

MT. HOLLY

VT 103

MT. HOLLY
Project F no. 58(3)
Sheet 25 of 49 sheets