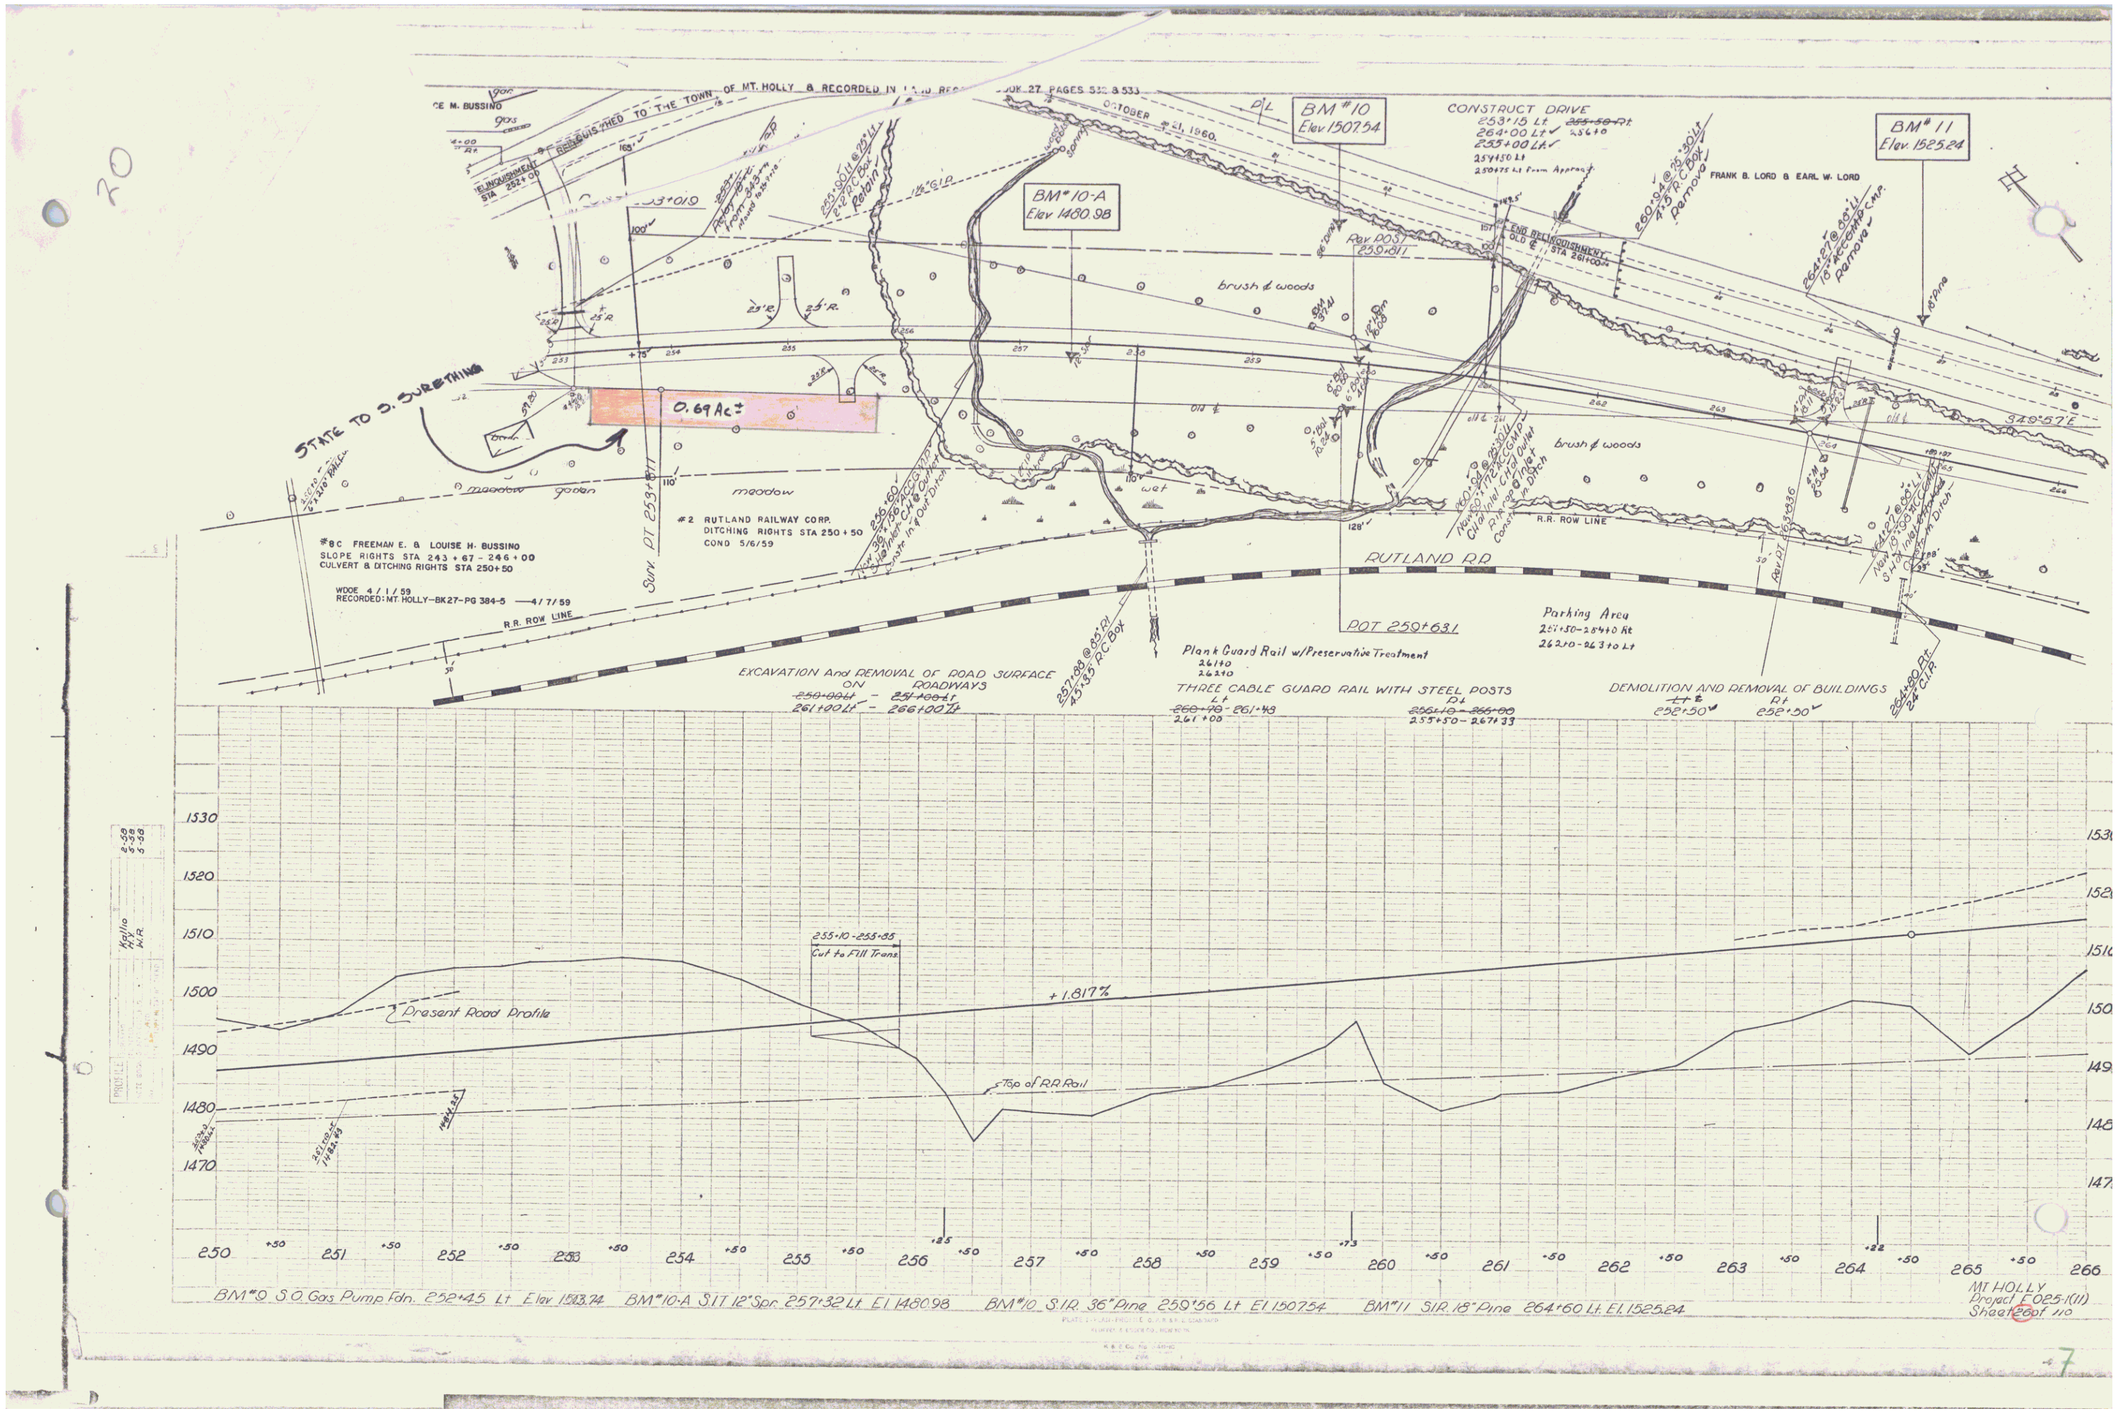
BM #10
Elev 1507.54
BM #10-A
Elev 1480.98
BM #11
Elev 1525.24
CONSTRUCT DRIVE
FRANK B. LORD & EARL W. LORD
brush & woods
meadow
wet
0.69 Ac±
STATE TO D. SURETHINK
#8C FREEMAN E. & LOUISE H. BUSSINO
SLOPE RIGHTS STA 243+67 - 246+00
CULVERT & DITCHING RIGHTS STA 250+50
WDOE 4/1/59
RECORDED: MT. HOLLY-BK27-PG 384-5 —4/7/59
#2 RUTLAND RAILWAY CORP.
DITCHING RIGHTS STA 250+50
COND 5/6/59
R.R. ROW LINE
RUTLAND RR
POT 250+63.1
Parking Area
EXCAVATION And REMOVAL OF ROAD SURFACE ON ROADWAYS
Plank Guard Rail w/Preservative Treatment
THREE CABLE GUARD RAIL WITH STEEL POSTS
DEMOLITION AND REMOVAL OF BUILDINGS
Present Road Profile
+1.817%
Top of R.R. Rail
255+10 - 255+85
Cut to Fill Trans
BM#9 S.O. Gas Pump Fdn. 252+45 Lt Elev 1503.74
BM#10-A S.I.T. 12" Spr. 257+32 Lt El 1480.98
BM#10 S.I.R. 36" Pine 259+56 Lt El 1507.54
BM#11 S.I.R. 18" Pine 264+60 Lt El 1525.24
MT HOLLY
Project F025-1(11)
Sheet 20 of 110