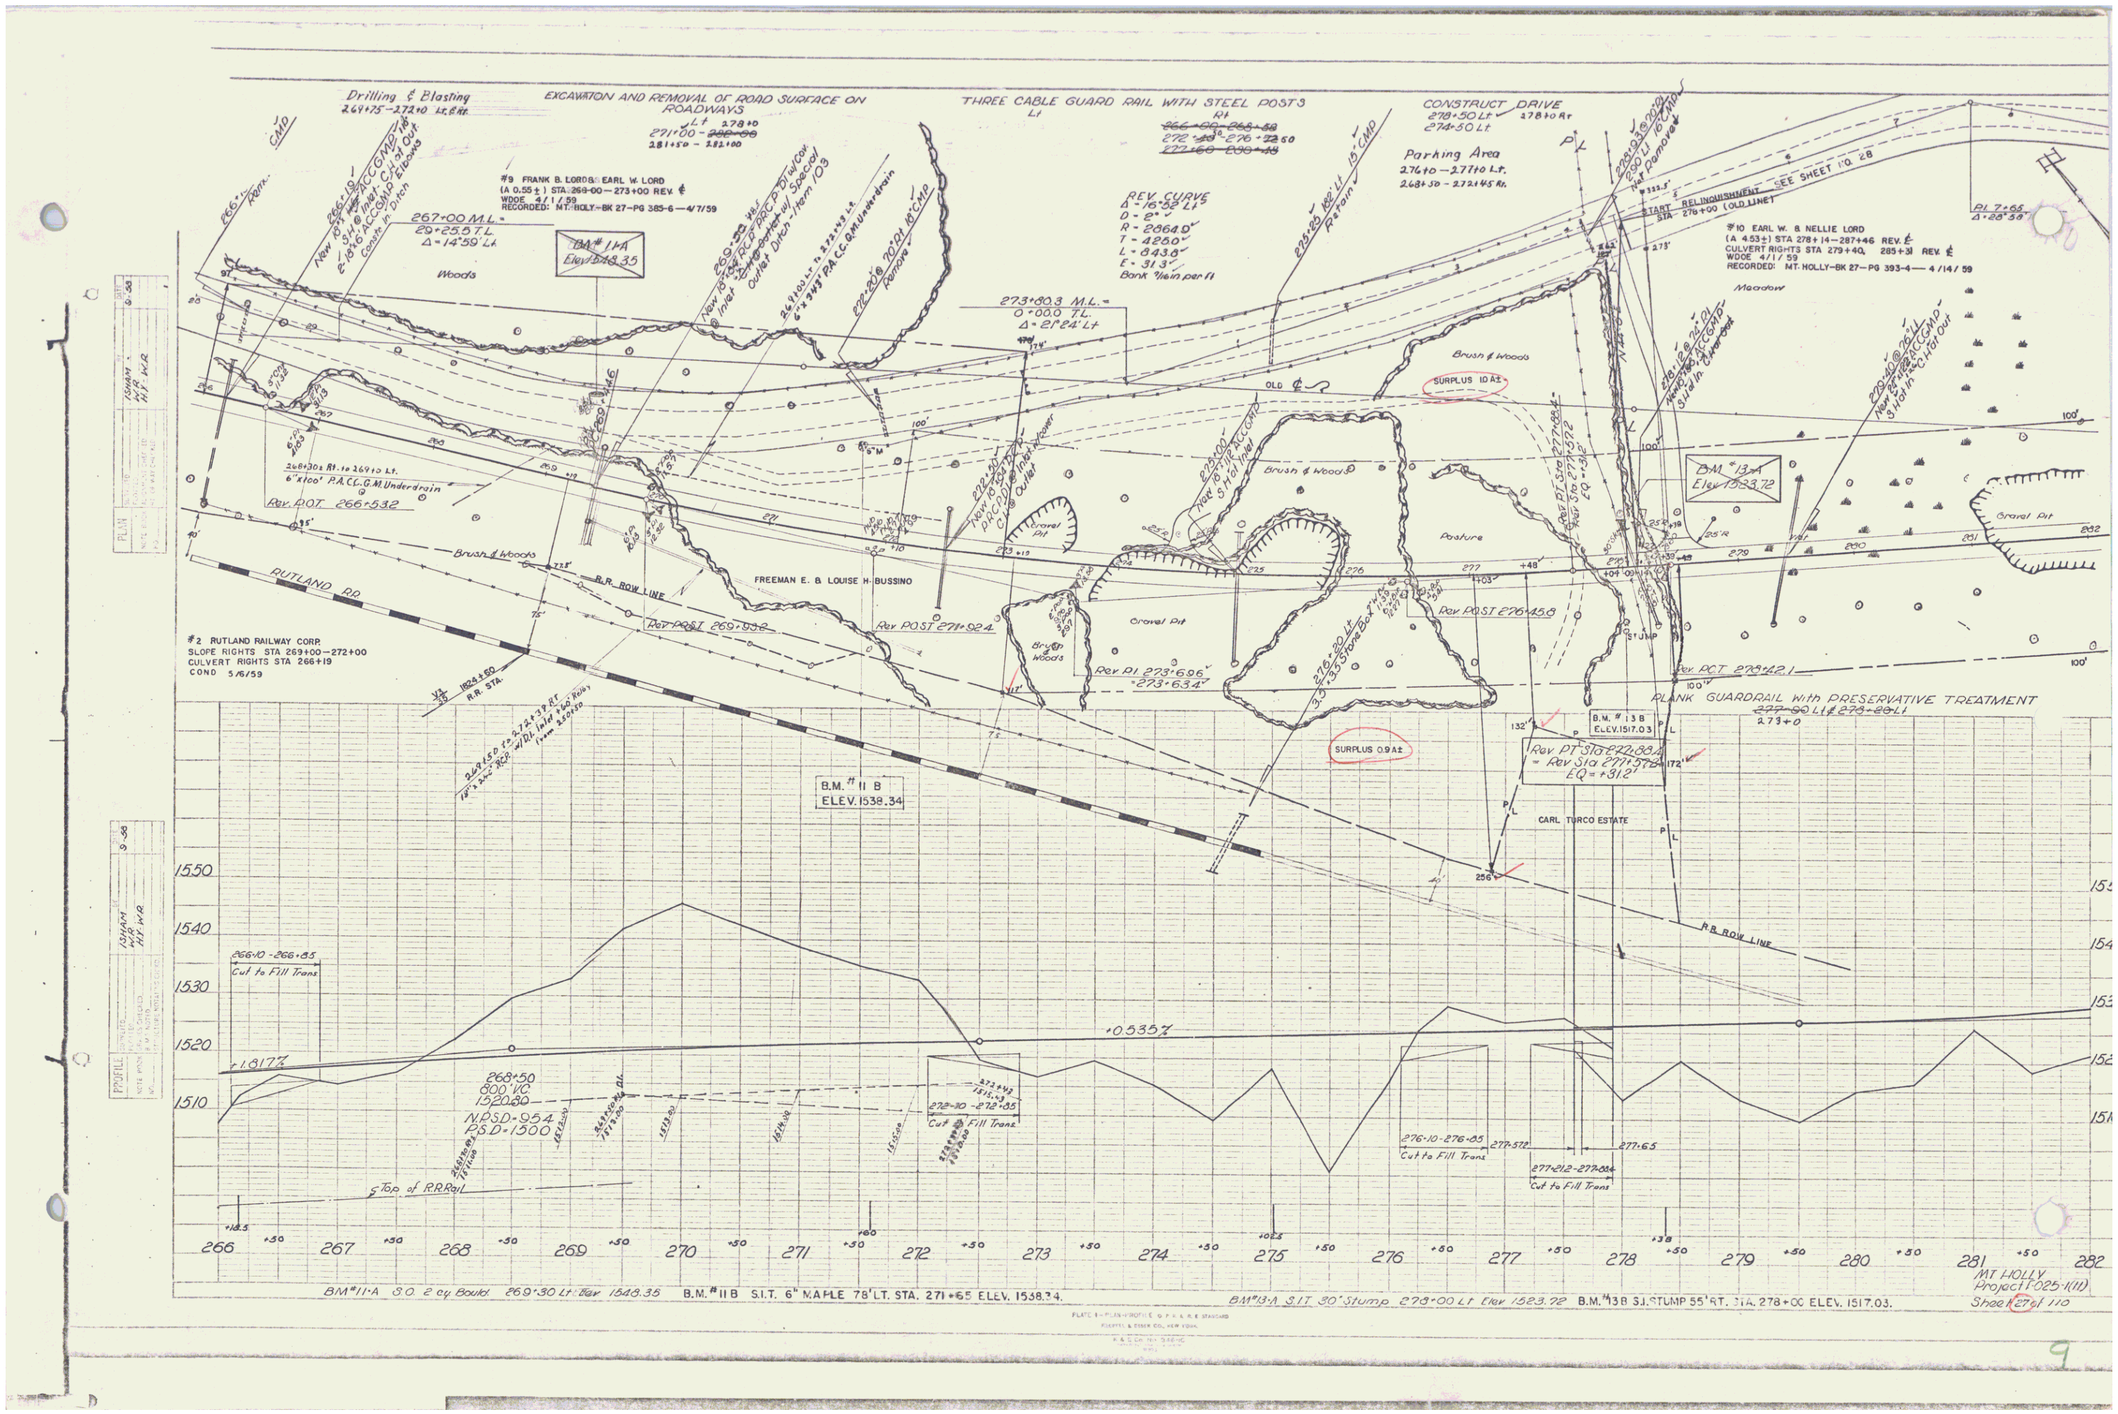
Drilling & Blasting
EXCAVATION AND REMOVAL OF ROAD SURFACE ON ROADWAYS
THREE CABLE GUARD RAIL WITH STEEL POSTS
CONSTRUCT DRIVE
Parking Area
#9 FRANK B. LORDS & EARL W. LORD
#10 EARL W. & NELLIE LORD
#2 RUTLAND RAILWAY CORP.
FREEMAN E. & LOUISE H. BUSSINO
CARL TURCO ESTATE
RUTLAND RR
R.R. ROW LINE
PLANK GUARDRAIL with PRESERVATIVE TREATMENT
Woods
Pasture
Meadow
Gravel Pit
Brush & Woods
SURPLUS 1.0 Ac
SURPLUS 0.9 Ac
B.M. # 11 B ELEV. 1538.34
B.M. # 13 B ELEV. 1517.03
BM # 11A Elev 1548.35
BM # 13A Elev 1523.72
REV. CURVE
Top of R.R. Rail
+1.617%
+0.535%
BM#11-A S.O. 2 cy Bould. 269'-30' Lt. Elev 1548.35 B.M.#11B S.I.T. 6" MAPLE 75' LT. STA. 271+65 ELEV. 1538.34.
BM#13-A S.I.T. 30" Stump 273'-00' Lt. Elev 1523.72 B.M.#13B S.I. STUMP 55' RT. STA. 278+00 ELEV. 1517.03.
MT HOLLY
Project F-025-1(11)
Sheet 27 of 110

9