FEDERAL AID DIST. NO.	STATE	FED. AID PROJ. NO.	FISCAL YEAR	SHEET NO.	TOTAL SHEETS
1	VT				

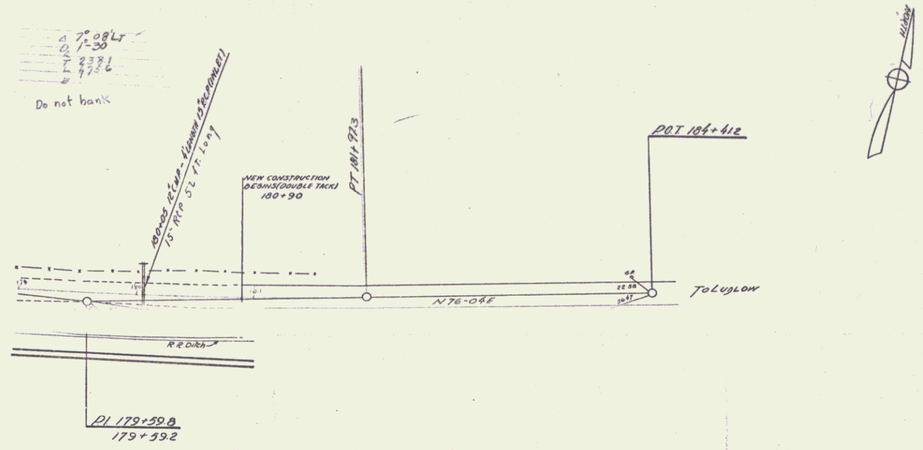

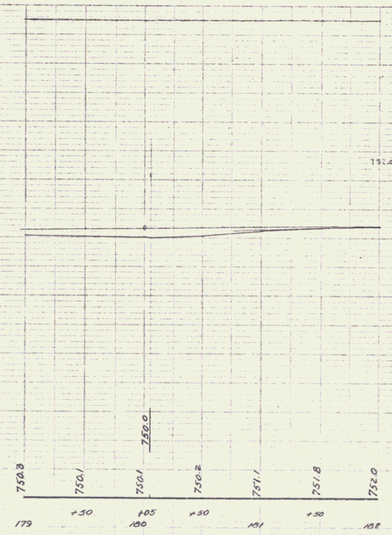

SERIES FAP 58 D (1)
SHEET 13 OF

14