| FED. ROAD DIST. NO. | STATE | FED. AID PROJ. NO. | FISCAL YEAR | SHEET NO. | TOTAL SHEETS |
|---|---|---|---|---|---|
| 1 | VT. | 110A | 1928 | 12 | 64 |

## WOOD GUARD RAIL REQUIRED

ON LEFT
Sta. 5+10 to Sta. 5+34 Length 24Ft.
" 6+56 " 6+80 " 24Ft.
ON RIGHT
Sta. 5+36 to Sta. 5+60 Length 24Ft.
" 6+84 " 7+08 " 24Ft.

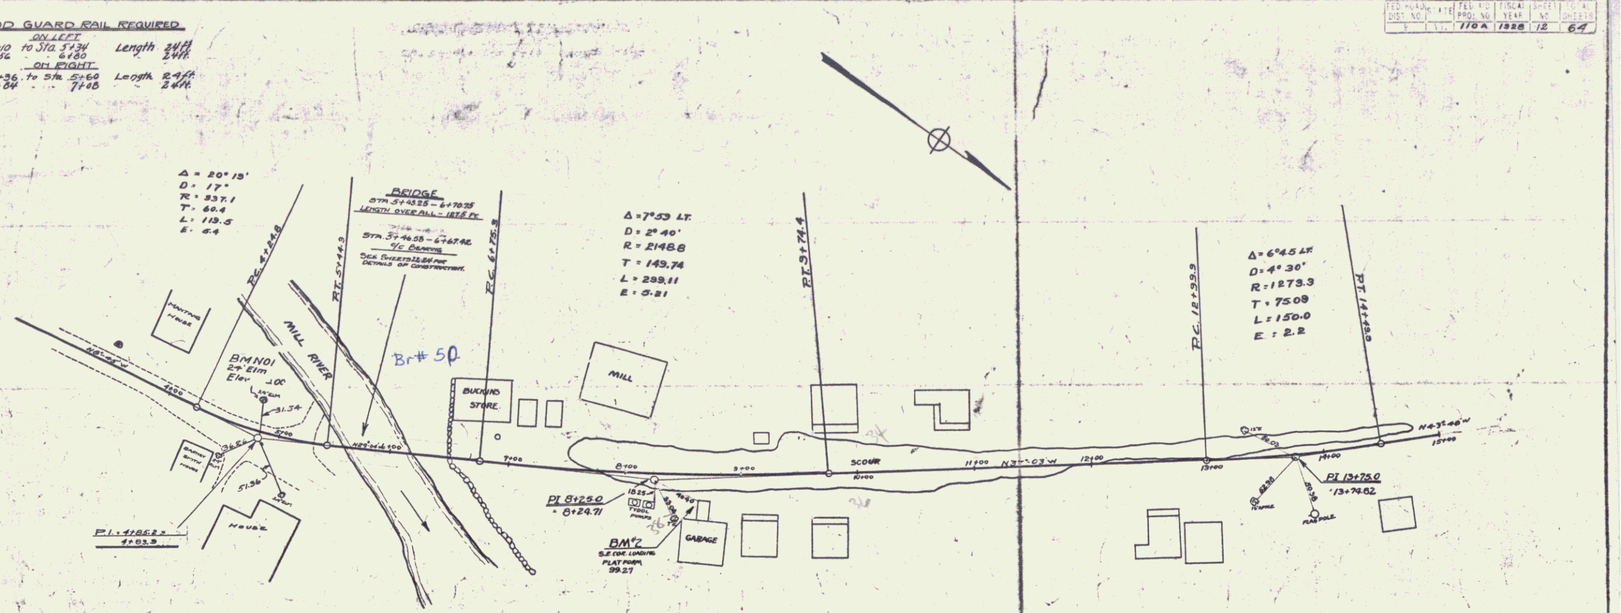


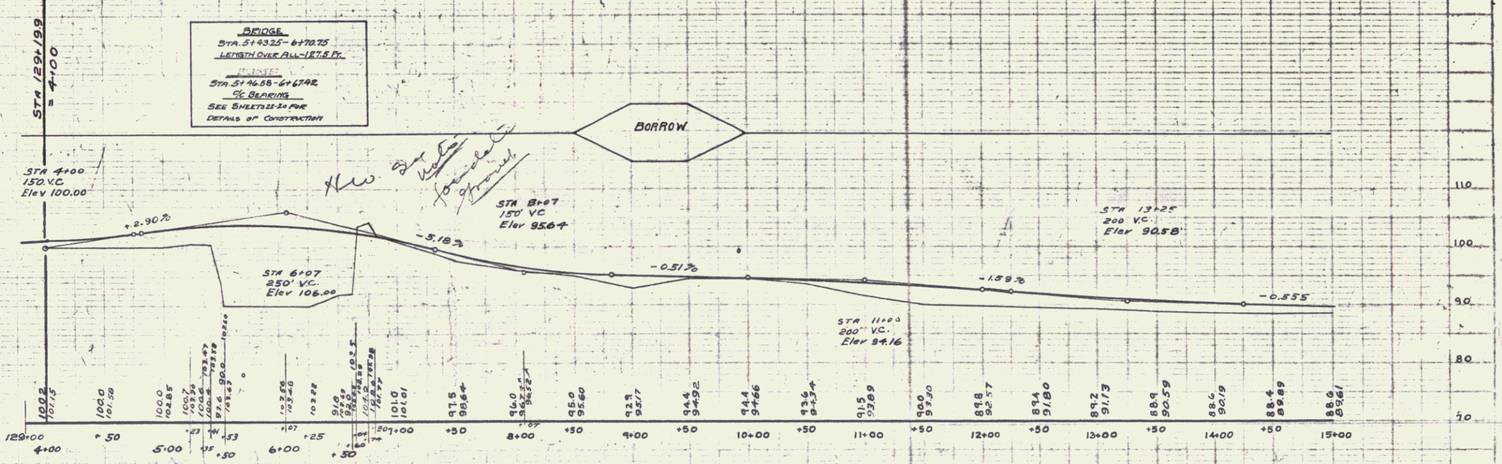


BM N01 21" Elm at E. End Temp. Bridge at Sta. 5+38 Elev. 100.00

BM N02 S.E. Cor. Concrete Platform ford Service Station East of Sta. 8+63 Elev. 99.27

SERIES F. NO. 110A
SHEET 12 OF 64