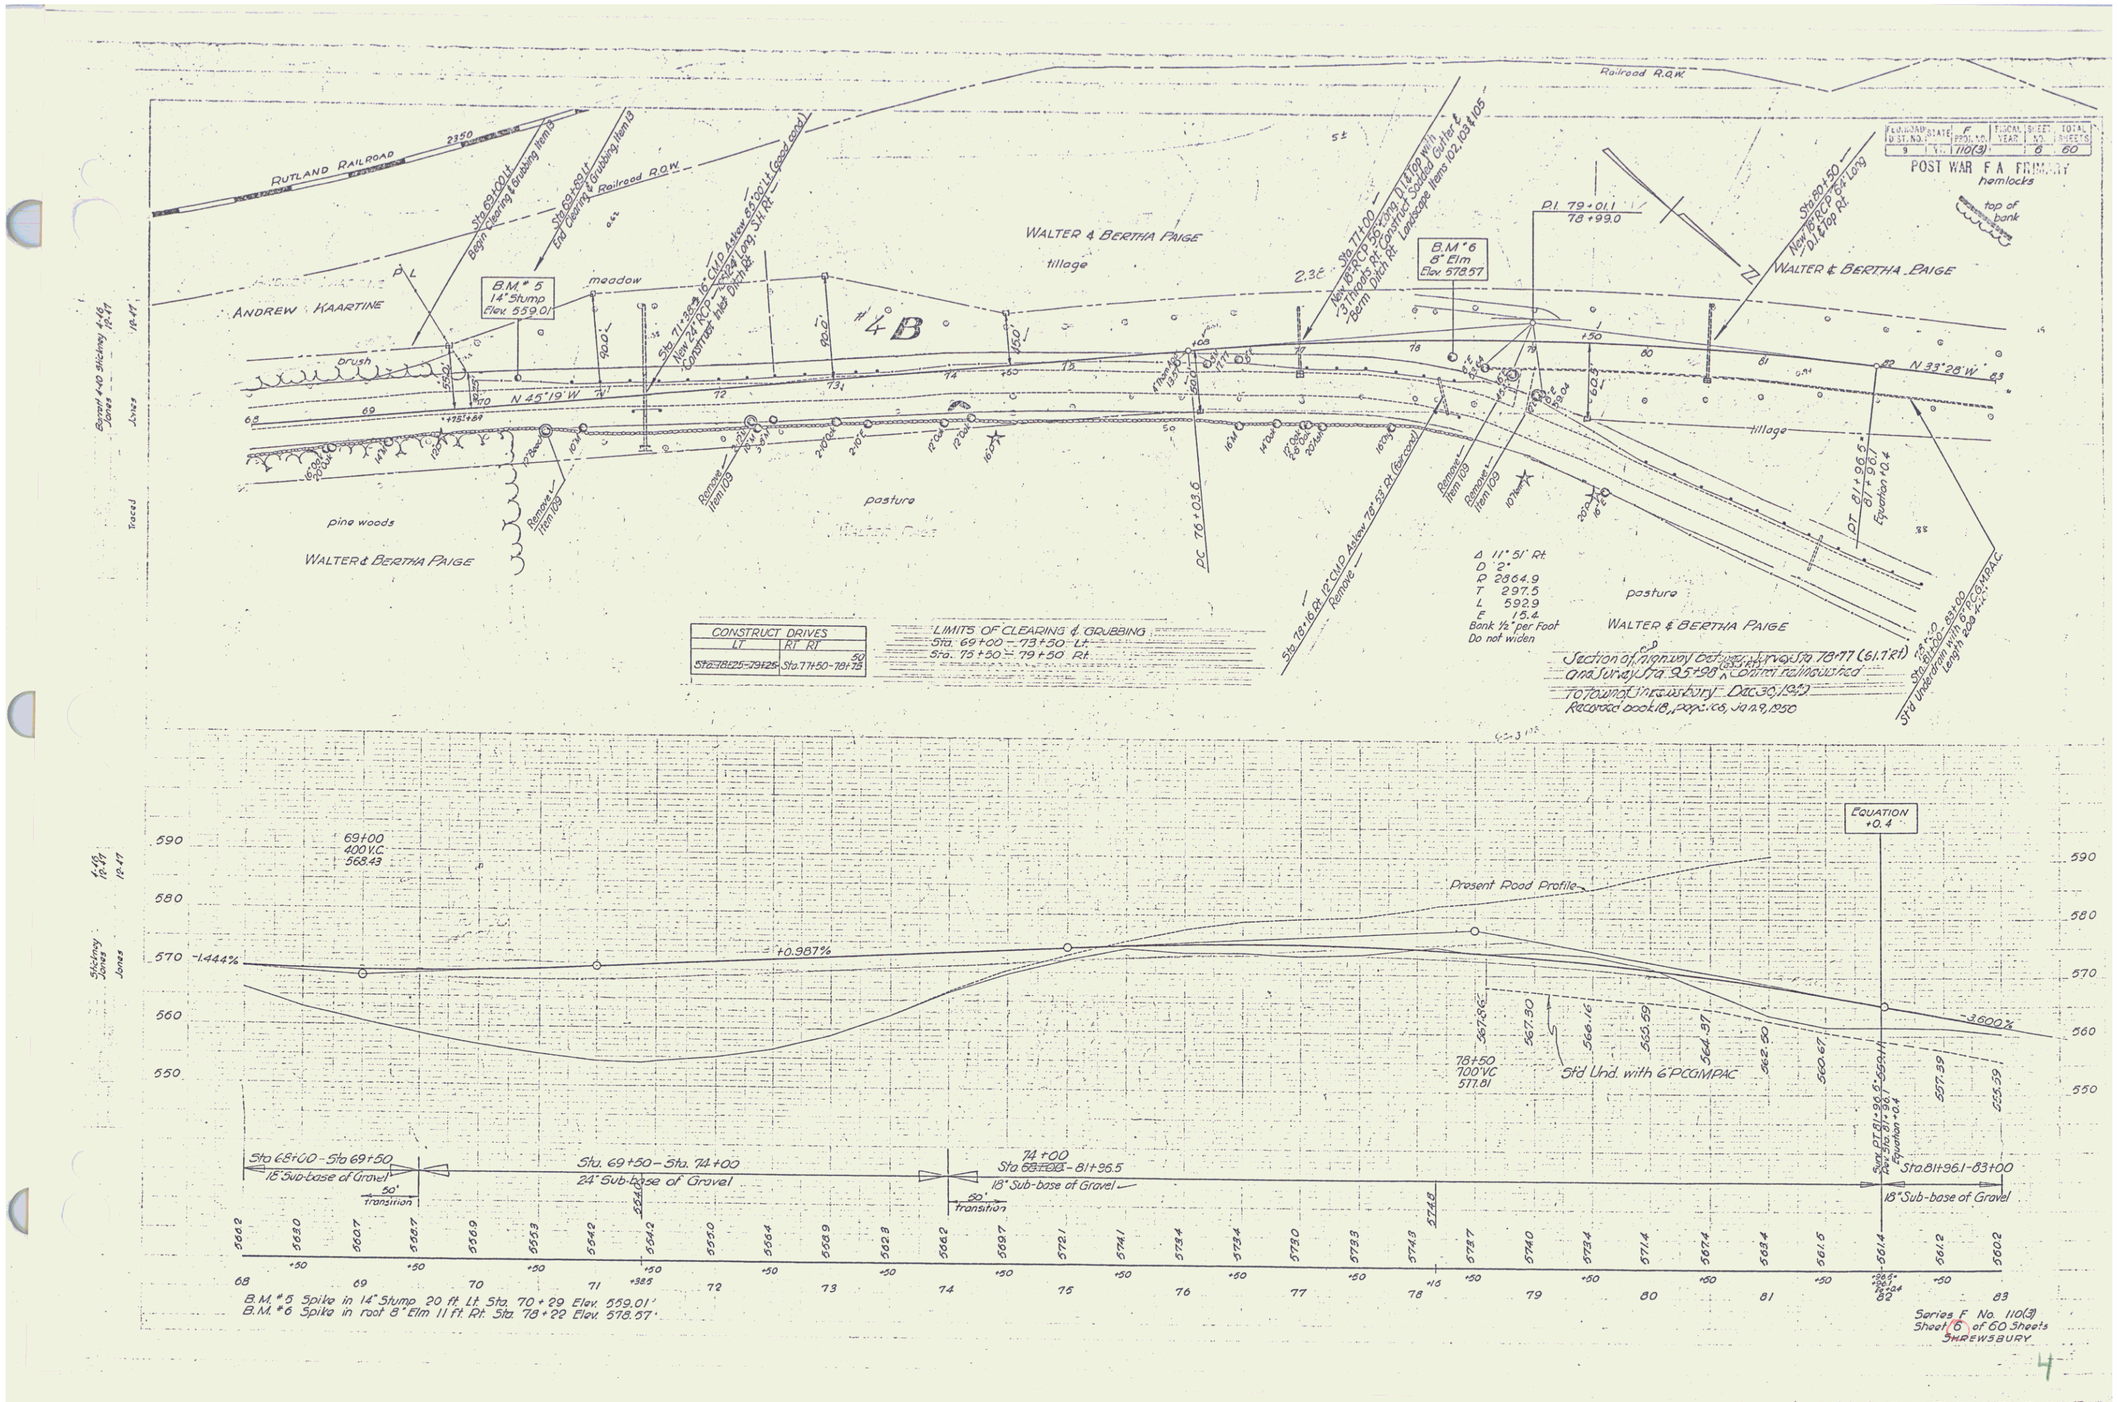
Railroad R.O.W.
RUTLAND RAILROAD
Sta. 69+00 Lt. Begin Clearing & Grubbing Item 13
Sta. 69+89 Lt. End Clearing & Grubbing Item 13
Sta. 71+35.4 16" CMP Asbestos 60' Lt. (Good condition) New 24" RCP 124' Long, Sta. Rt. Construct Hill Ditch Rt.
WALTER & BERTHA PAIGE
tillage
ANDREW KAARTINE
B.M. # 5 14" Stump Elev. 559.01
meadow
brush
N 45°19' W
#4B
Remove Item 109
pine woods
WALTER & BERTHA PAIGE
pasture
PC 76+03.6
Sta. 77+00 New 18" RCP 50' Long D.I. & Top with 3' Hoods Rt. Construct Solid Cutter & Berm Ditch Rt. Landscape Items 102, 103 & 105
B.M. # 6 8" Elm Elev. 578.57
PI 79+01.1 78+99.0
Sta. 80+50 New 18" RCP 54' Long D.I. & Top Rt.
WALTER & BERTHA PAIGE
top of bank
POST WAR F.A. PRIMARY
hemlocks
N 33°28' W
tillage
PT 81+96.5 81+96.1 Equation 0.4
Sta. 78+16 Rt. 12" CMP Asbestos 78' 53" Rt. (Removed)
Remove
Δ 11° 51' Rt
D 2°
R 2864.9
T 297.5
L 592.9
E 15.4
Bank ½" per Foot
Do not widen
pasture
WALTER & BERTHA PAIGE
Sta. 82+00 Rt. Sta. 83+00 Lt. 5" Underdrain with 6" PCCGMPAC Length 206 ft.
CONSTRUCT DRIVES
LT. RT. RT.
Sta. 78+25-79+25 Sta. 77+50-78+75 50
LIMITS OF CLEARING & GRUBBING
Sta. 69+00 - 73+50 - Lt.
Sta. 75+50 - 79+50 Rt.
Bryant 4-10 Stickney 4-18 Jones 10-47
Traced Jones 19-47
Stickney 1-49 Jones 10-49 Jones 10-47
590
580
570
560
550
69+00
400 V.C.
568.43
-1.444%
+0.987%
Present Road Profile
EQUATION +0.4
-3.600%
78+50
700 V.C.
577.81
Std Und. with 6" PCCGMPAC
567.86
567.30
566.16
563.59
564.97
562.80
560.67
557.59
555.59
Sta. 68+00 - Sta. 69+50
18" Sub-base of Gravel
50' transition
Sta. 69+50 - Sta. 74+00
24" Sub-base of Gravel
74+00
Sta. 74+00 - 81+96.5
18" Sub-base of Gravel
50' transition
Sta. 81+96.1 - 83+00
18" Sub-base of Gravel
68 69 70 71 72 73 74 75 76 77 78 79 80 81 82 83
B.M. # 5 Spike in 14" Stump 20 ft. Lt. Sta. 70+29 Elev. 559.01'
B.M. # 6 Spike in root 8" Elm 11 ft. Rt. Sta. 78+22 Elev. 578.57'
Series F No. 110(3)
Sheet 6 of 60 Sheets
SHREWSBURY
4