




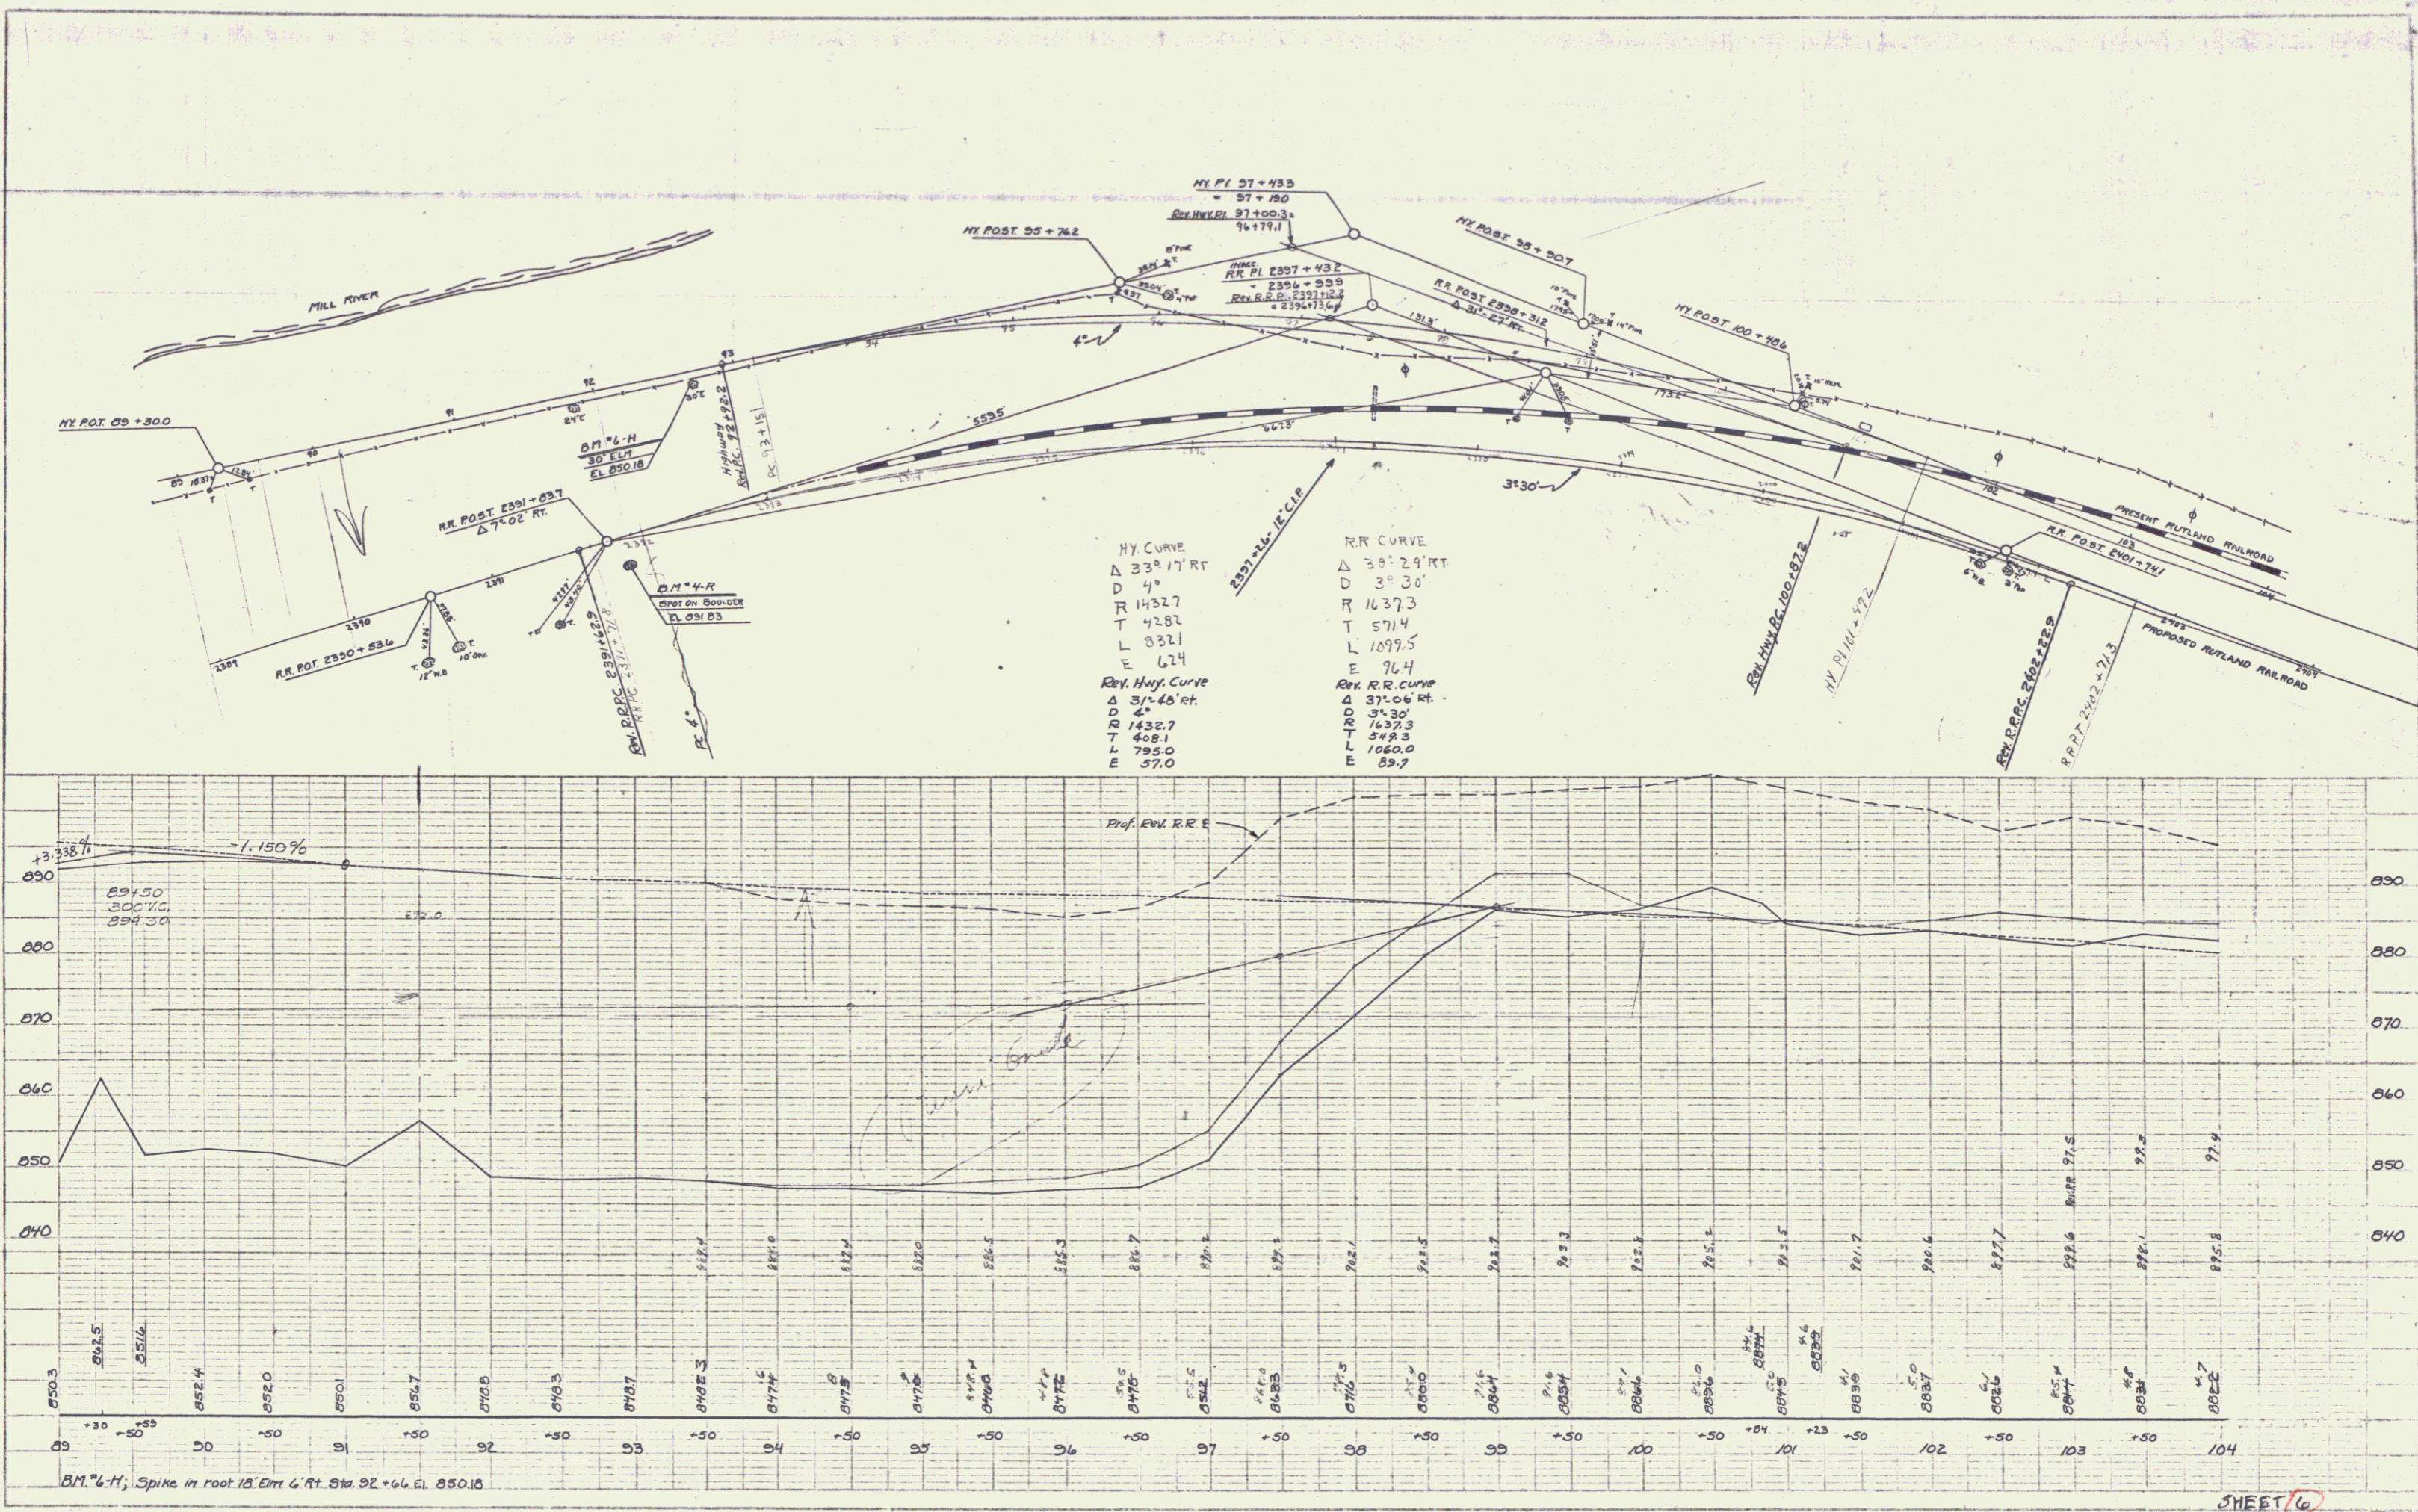

SHEET 16

15

6