


FED. ROAD DIST. NO.	STATE	FED. AID PROJ. NO.	FISCAL YEAR	SHEET NO.	TOTAL SHEETS
5	Vt.			7A	8

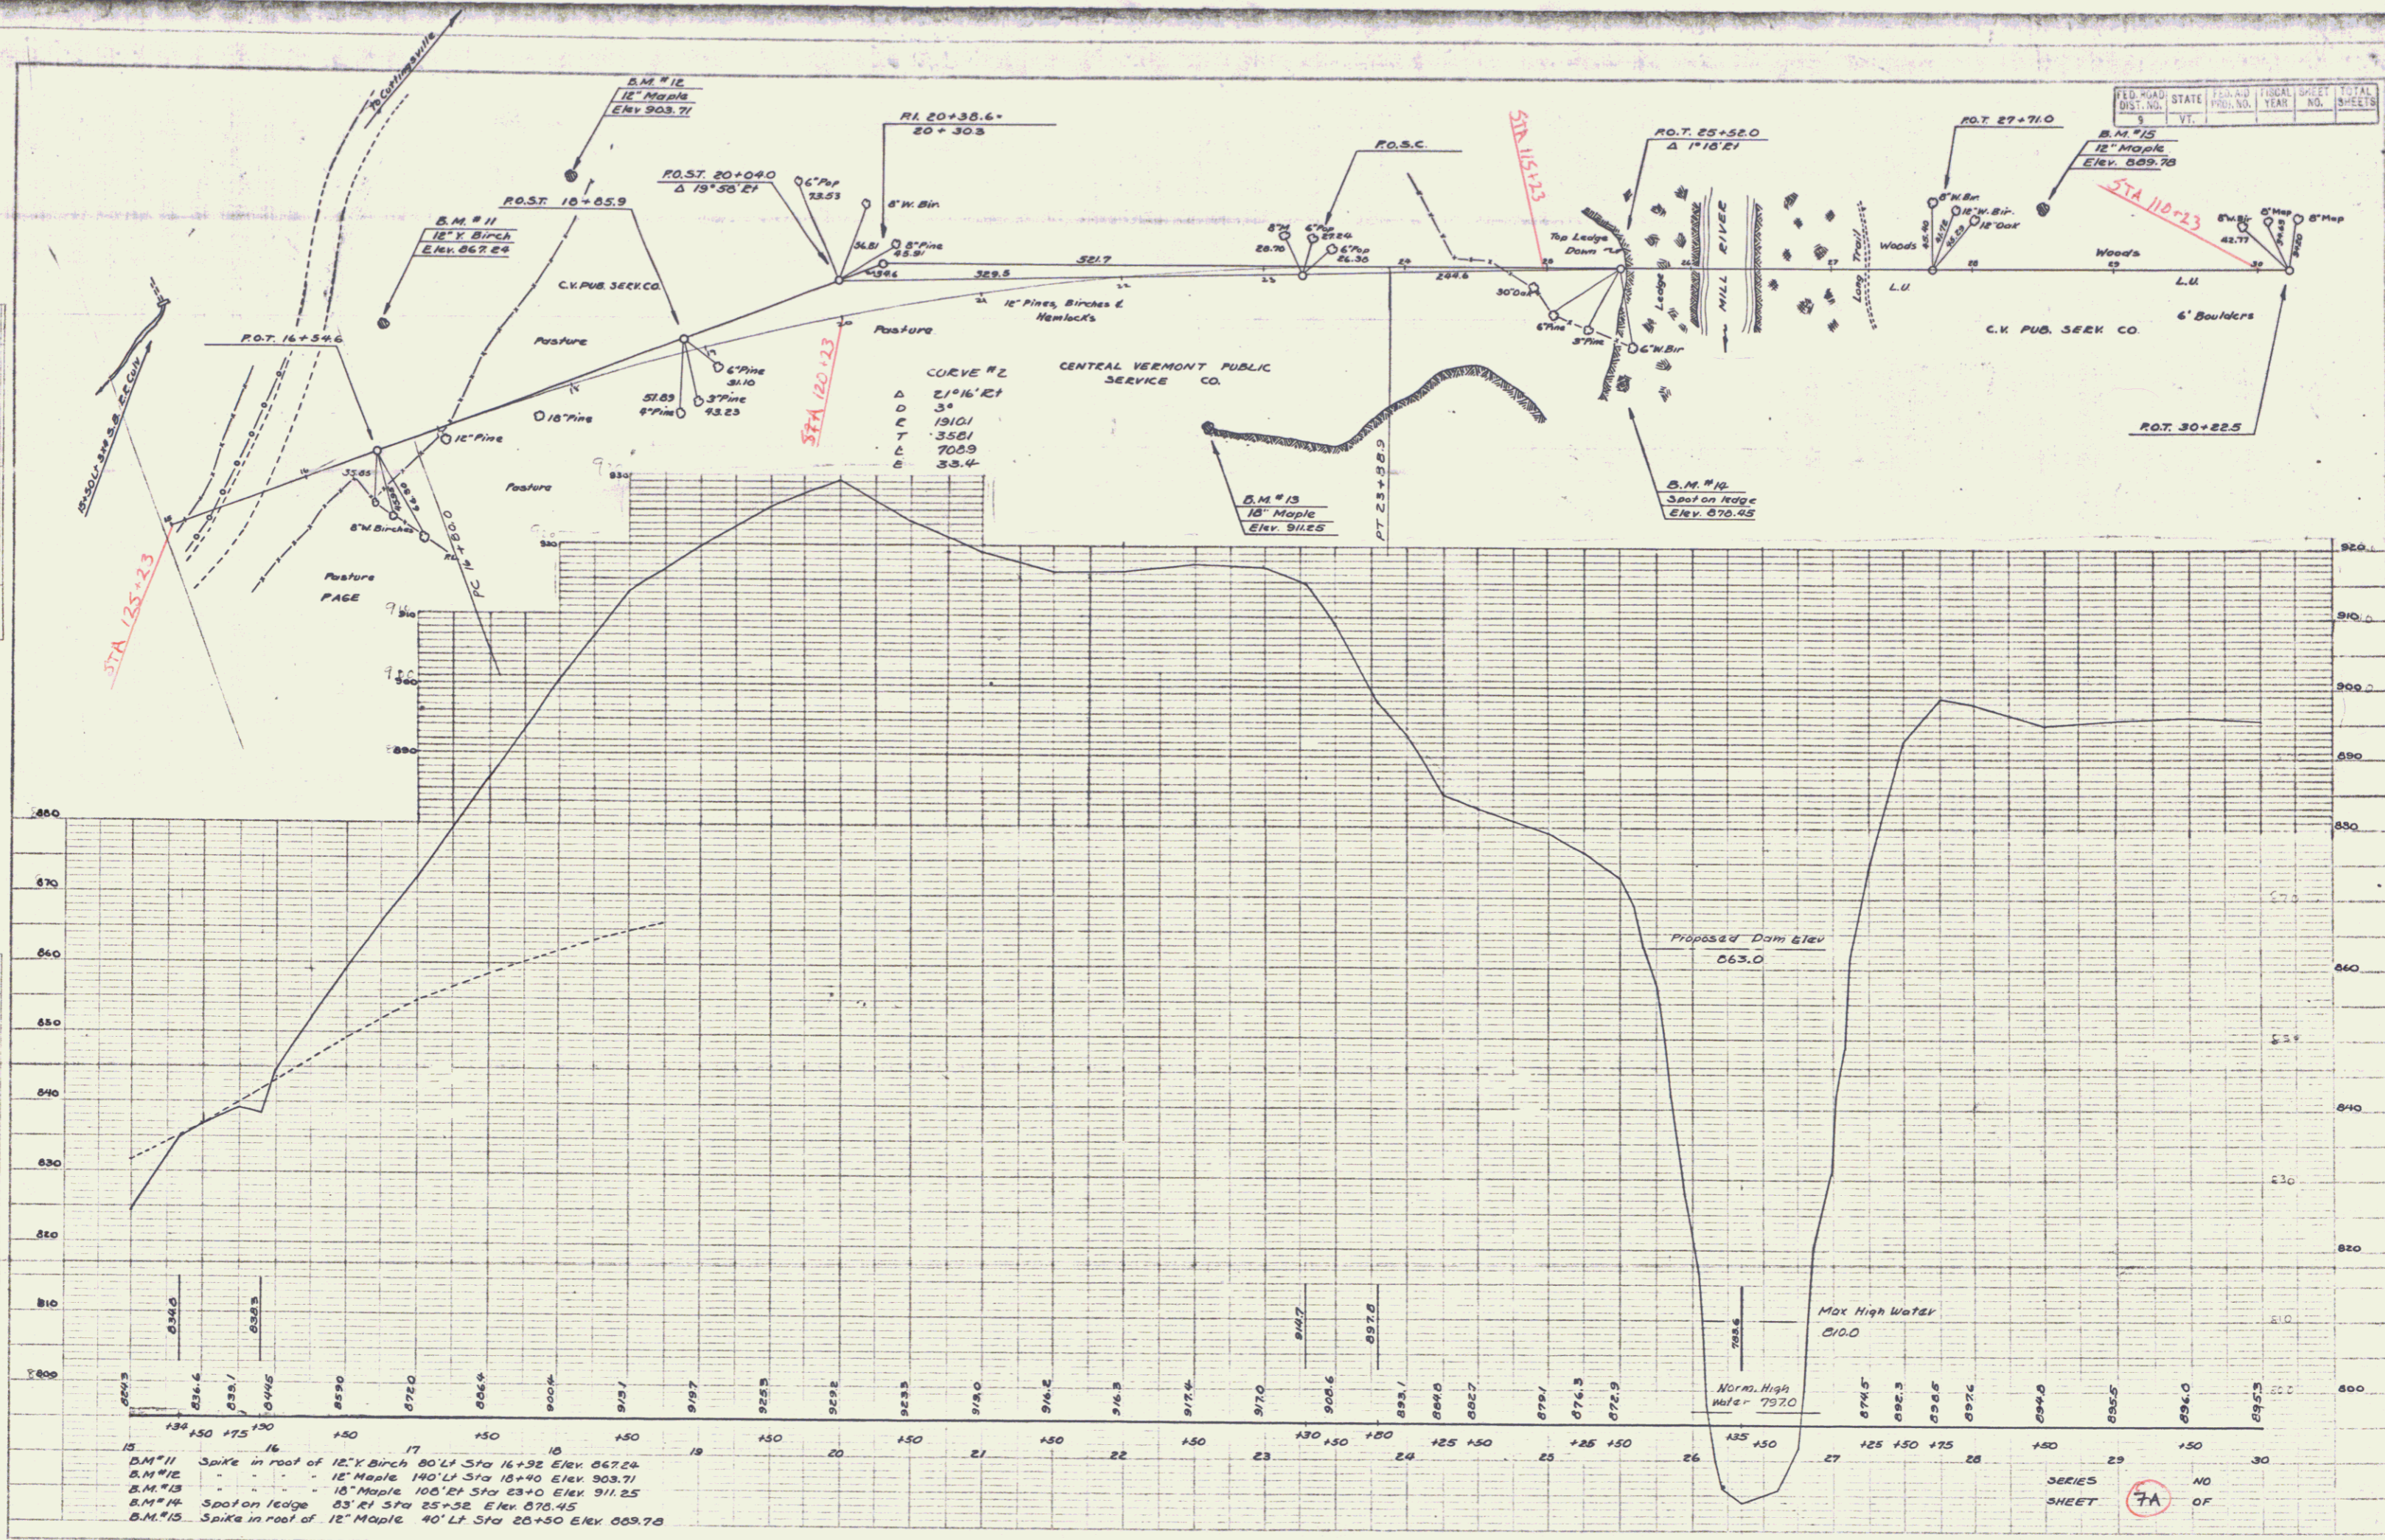



15 B.M.#11 Spike in root of 12" X Birch 80' Lt. Sta 16+32 Elev. 867.24  
 16 B.M.#12 12" Maple 140' Lt. Sta 18+40 Elev. 903.71  
 17 B.M.#13 18" Maple 100' Lt. Sta 23+00 Elev. 911.25  
 18 B.M.#14 Spot on ledge 83' Rt. Sta 25+32 Elev. 876.45  
 19 B.M.#15 Spike in root of 12" Maple 40' Lt. Sta 26+50 Elev. 889.78

SERIES NO. 7A OF 8 SHEETS