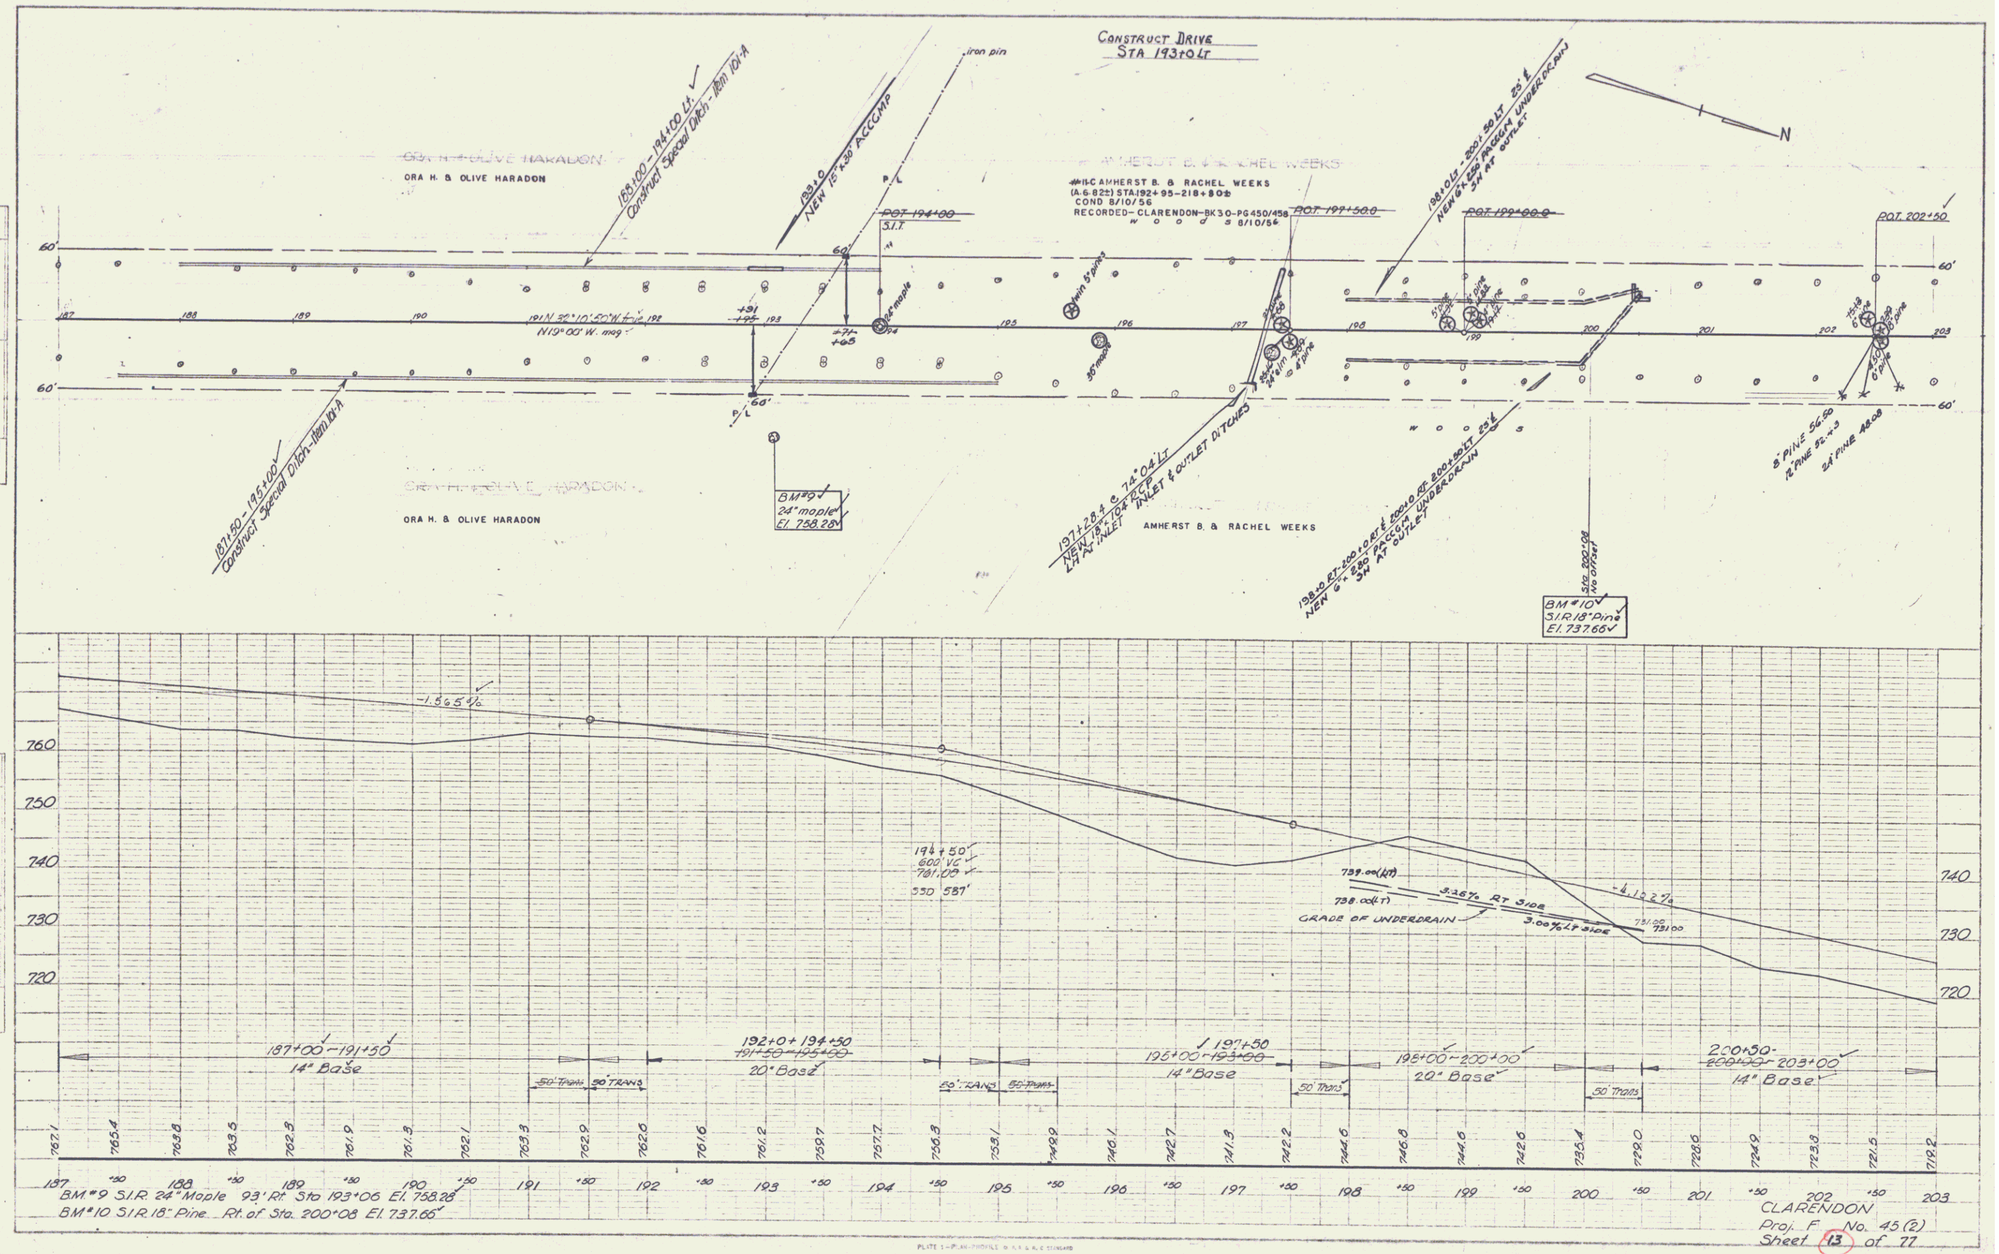
CONSTRUCT DRIVE
STA 193+0 Lt
ORA H. & OLIVE HARADON
AMHERST B. & RACHEL WEEKS
#15-C AMHERST B. & RACHEL WEEKS
(A.6.82±) STA.192+95-218+80±
COND. 8/10/56
RECORDED-CLARENDON-BK 30-PG 450/458
8/10/56
N19°00' W. mag
BM #9
24" maple
El. 758.28
BM #10
S.I.R. 18" Pine
El. 737.66
GRADE OF UNDERDRAIN
-1.365%
-4.122%
3.267% RT SIDE
3.00% LT SIDE
187+00-191+50
14" Base
192+0+194+50
20" Base
195+00-197+50
14" Base
197+50
195+00-200+00
20" Base
200+50-203+00
14" Base
50' TRANS
BM #9 S.I.R. 24" Maple 93' Rt Sta 193+06 El. 758.28
BM #10 S.I.R. 18" Pine Rt. of Sta. 200+08 El. 737.66
CLARENDON
Proj. F No. 45(2)
Sheet 13 of 77