FED. ROAD DIST. NO.	STATE	FED. AID PROJ. NO.	FISCAL YEAR	SHEET NO.	TOTAL SHEETS
9	VT.	125-A	1931	20	54

CABLE GUARD RAIL REQUIRED

Sta.	Leng.	Contour	Hgt.	Leng.
225+24-225+72	LL	48'	40'	88'

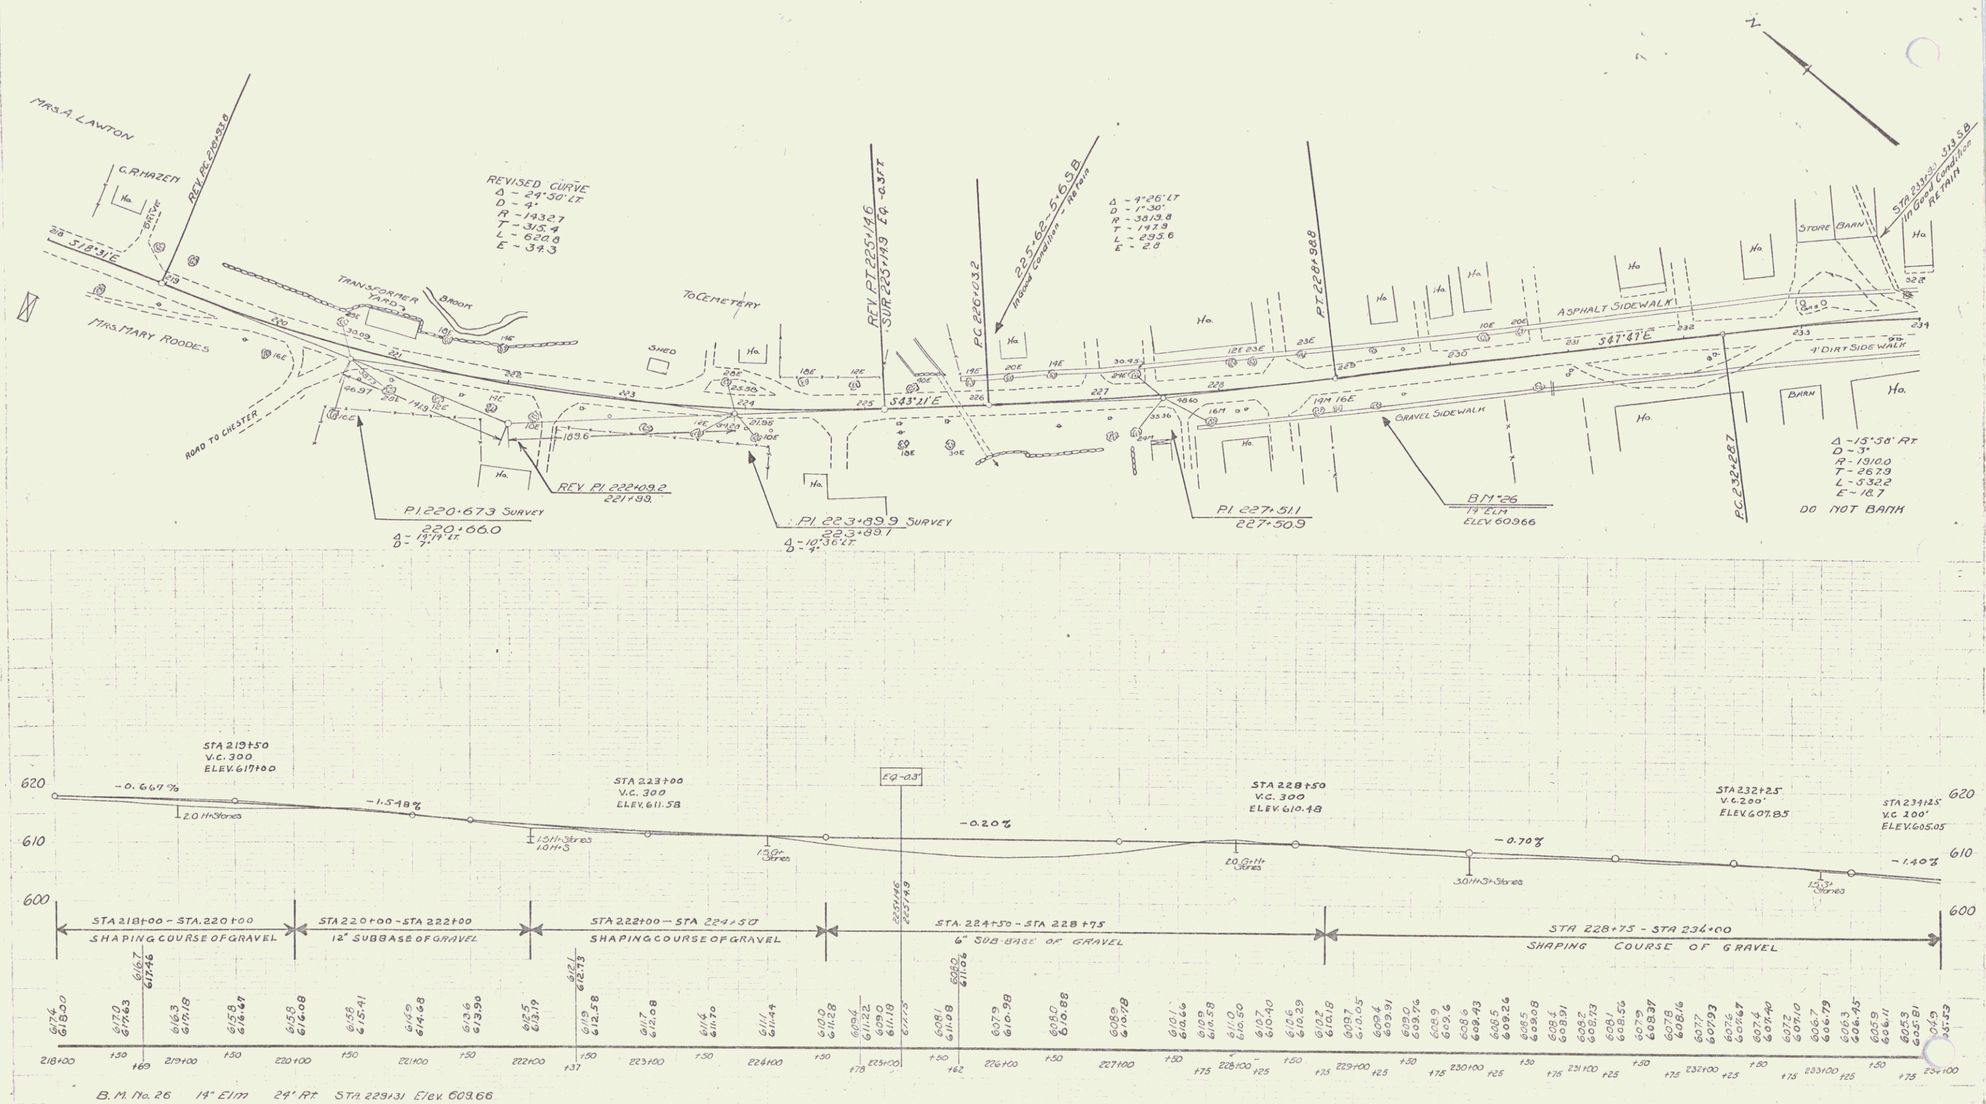

B.M. No. 26 14" Elm 24" Rt STA. 229+31 Elev. 609.66

SERIES F No. 125-A
Sheet 20 of 54

18