FED.ROAD DIST. No.	STATE	FED. AID PROJ. No.	FISCAL YEAR	SHEET No.	TOTAL SHEETS

Guard Rail Required

on Left

Sta. 26+18 to Sta 26+42 – 24 Ft.
" 30+88 to " 31+12 – 24 "
" 35+88 to " 36+12 – 24 "

on Right

Sta. 26+18 to Sta. 26+42 – 24 Ft.
" 28+30 to " 29+34 – 104 "
" 30+88 to " 31+12 – 24 "
" 35+88 to " 36+12 – 24 "
Total This Sheet 248.

New Culverts Required

~~33+00~~ 33+00
Sta. 26+30 – ~~2-42~~ Rein. Conc. Culvert – 86 Ft. Long
1-2-4 Concrete – 5 Cu. yds.
1-2½-5 " – 5.5 "
Rein. Steel – 117 lbs.

~~Sta. 31+00 — 16' Corr. Iron Pipe Culvert – 26 Ft. Long~~
~~1-2½-5 Concrete — 1.7 Cu. yds.~~

37+50
Sta. 36+00 – 16' Corr. Iron Pipe Culvert – 44 Ft. Long
1-2½-5 Concrete – 1.7 Cu. yds.

Sub-Base Required


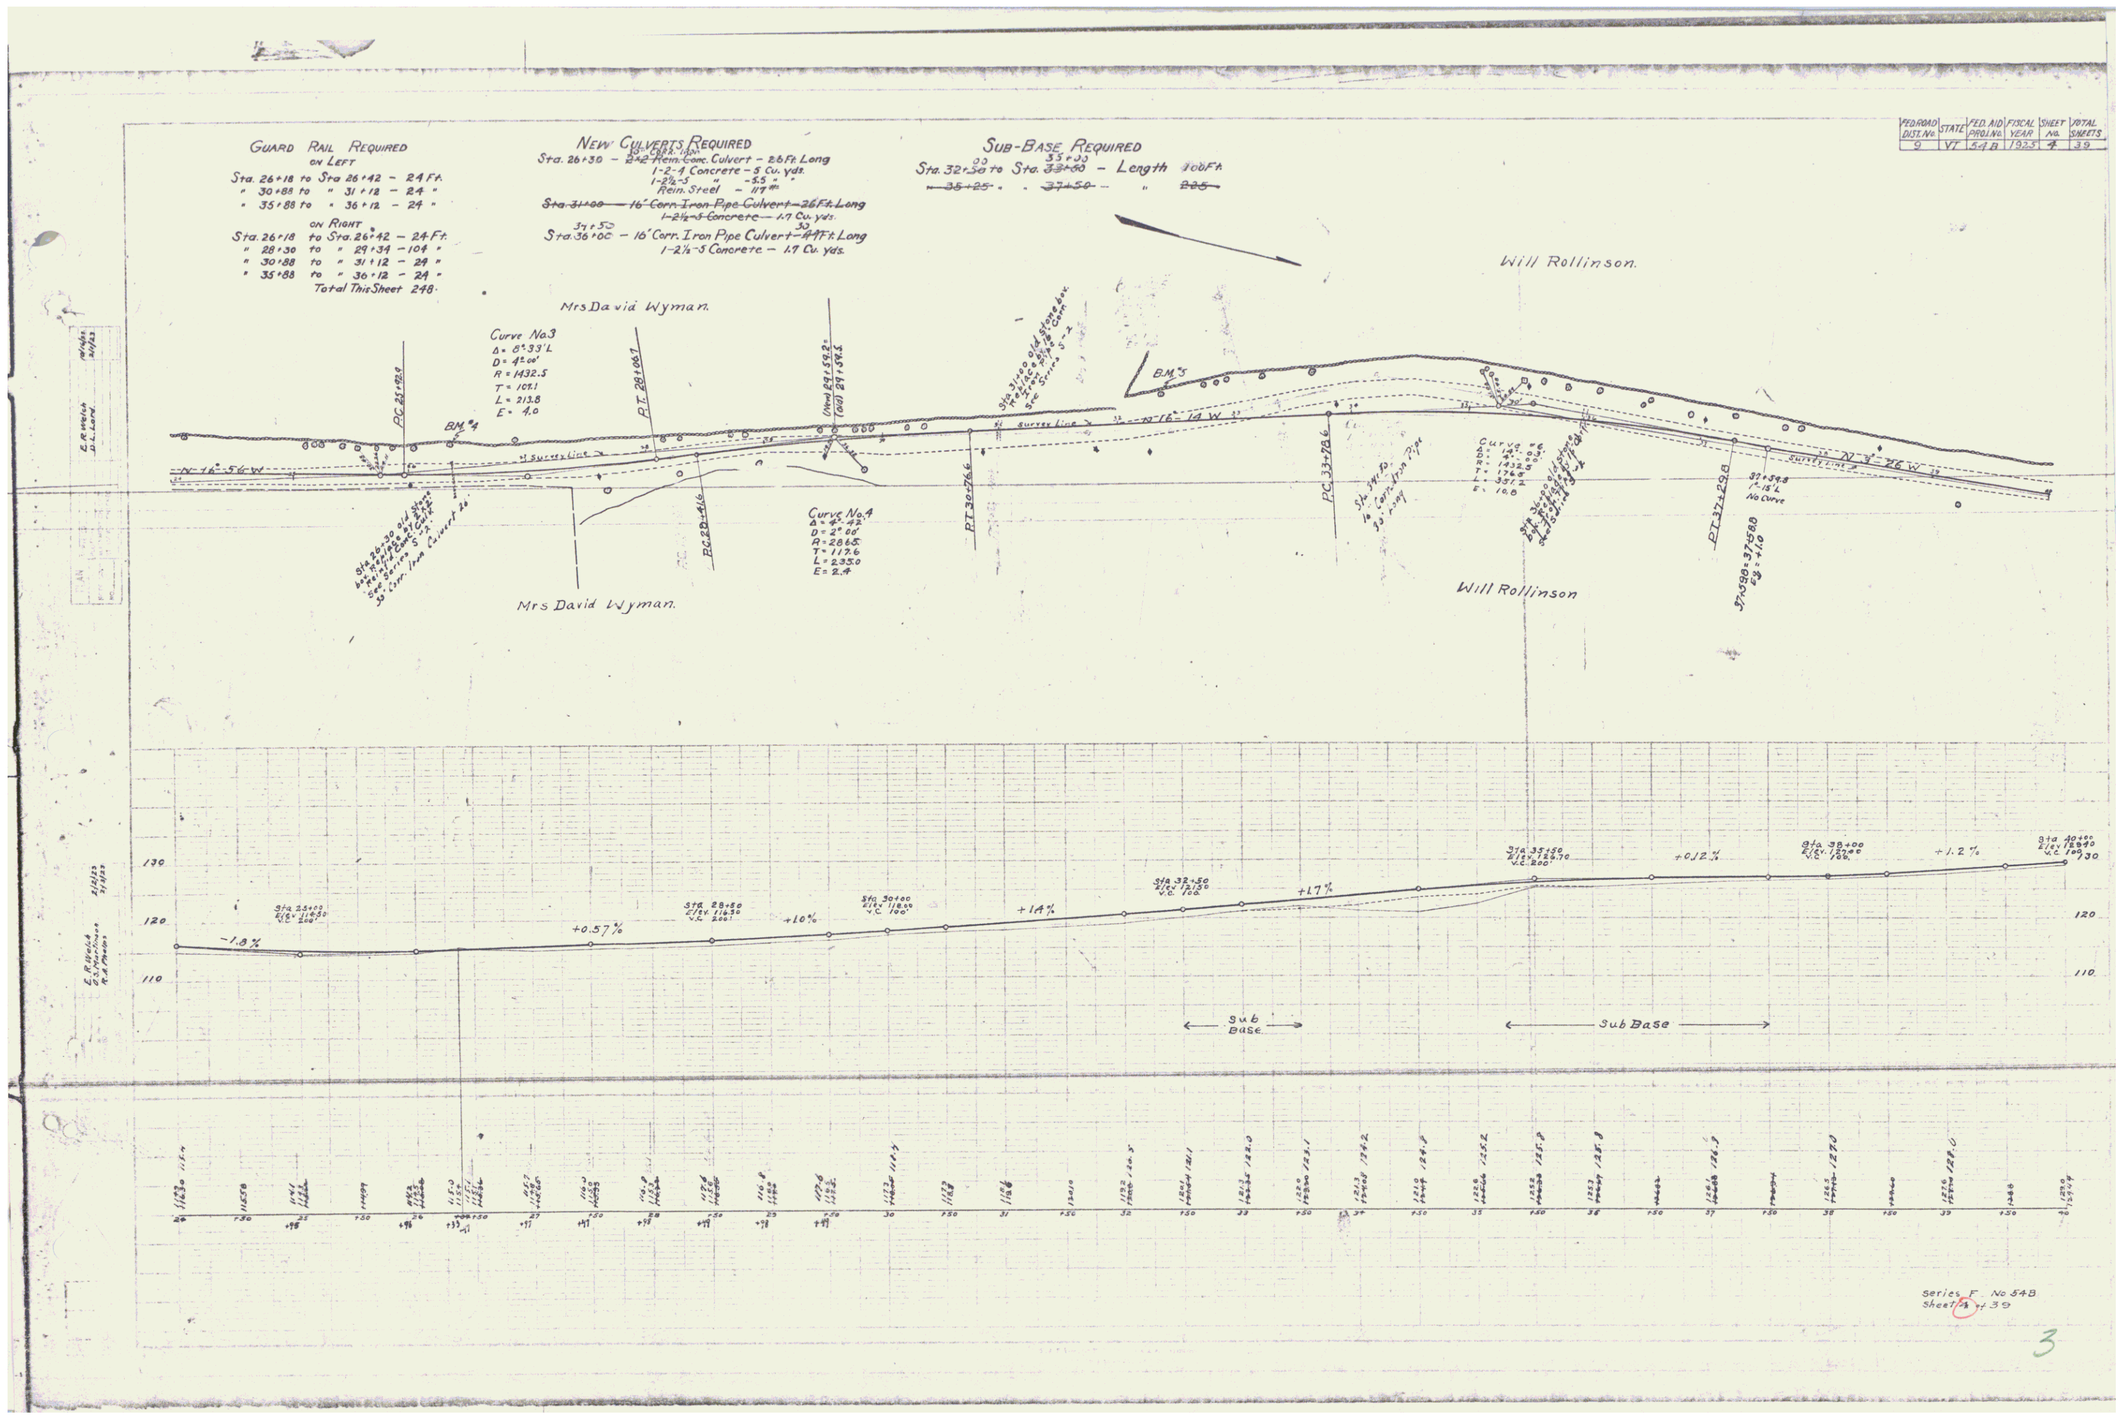

Series F No 548

3