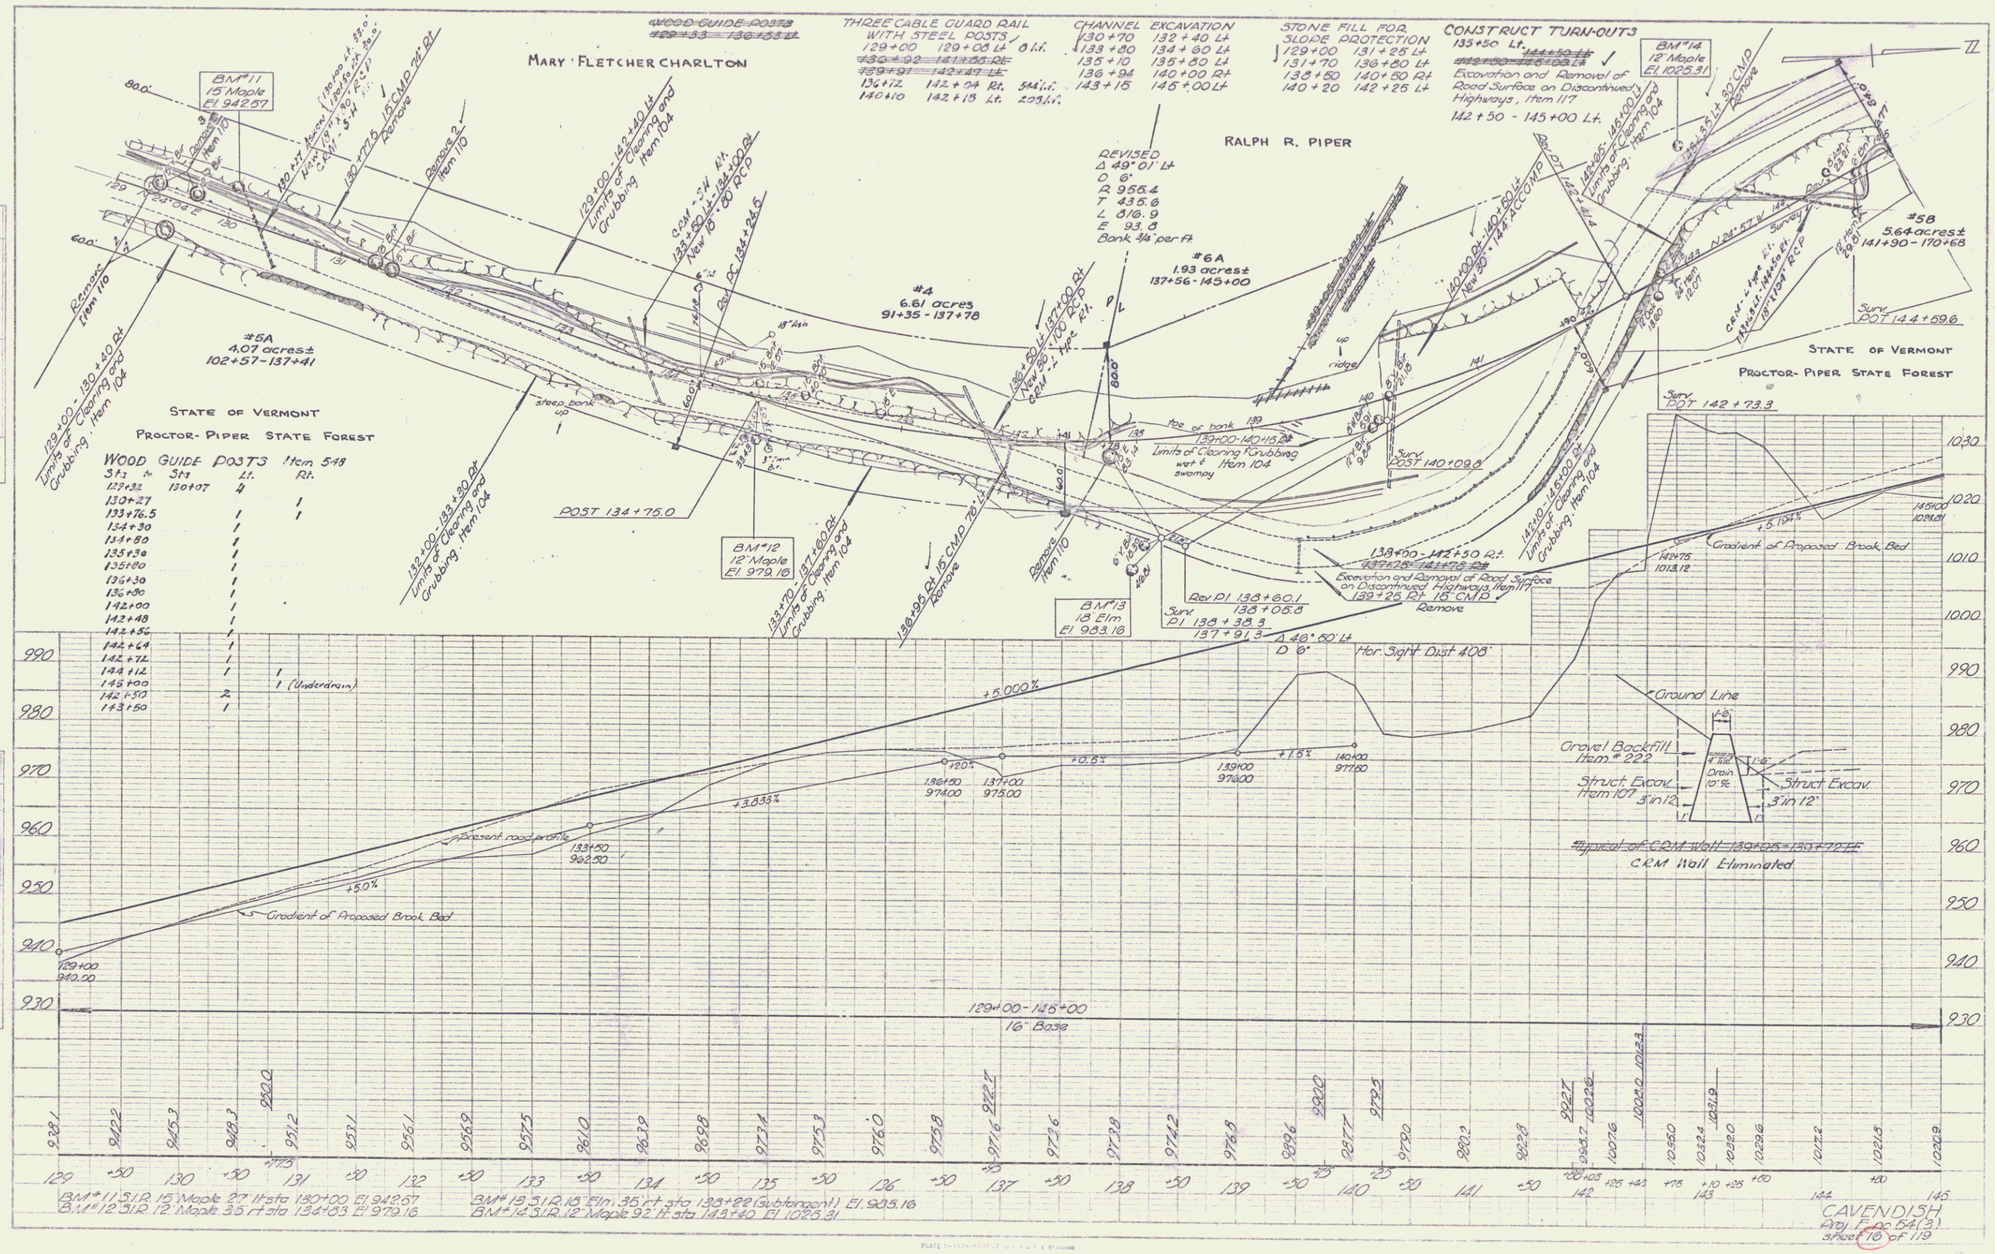
MARY FLETCHER CHARLTON
RALPH R. PIPER
STATE OF VERMONT
PROCTOR-PIPER STATE FOREST
WOOD GUIDE POSTS Item 548
THREE CABLE GUARD RAIL WITH STEEL POSTS
CHANNEL EXCAVATION
STONE FILL FOR SLOPE PROTECTION
CONSTRUCT TURN-OUTS
135+50 Lt.
Excavation and Removal of Road Surface on Discontinued Highways, Item 117
142+50 - 145+00 Lt.
REVISED
Δ 49° 01' Lt
D 6°
R 955.4
T 435.6
L 816.9
E 93.8
Bank 3/4" per ft
#4
6.61 acres
91+35 - 137+78
#5A
4.07 acres±
102+57 - 137+41
#6A
1.93 acres±
137+56 - 145+00
#5B
5.64 acres±
141+90 - 170+68
BM #11
15 Maple
El 942.57
BM #12
12 Maple
El 979.16
BM #13
18 Elm
El 983.16
BM #14
12 Maple
El 1025.31
POST 134+75.0
Surv POST 140+09.8
Surv POST 142+73.3
Surv POST 144+69.6
Limits of Clearing Grubbing wet & swampy Item 104
Limits of Clearing and Grubbing Item 104
Remove Item 110
Remove 2 Item 110
Excavation and Removal of Road Surface on Discontinued Highways, Item 117
Rev PI 138+60.1
Surv PI 138+05.8
Surv PI 138+98.3
137+91.3
Δ 48° 50' Lt
D 6°
Hor. Sight Dist 408'
+5.000%
+3.833%
+5.0%
+2.0%
+0.8%
+1.5%
+5.194%
Present road profile
Gradient of Proposed Brook Bed
Ground Line
Gravel Backfill Item # 222
Struct. Excav. Item 107
Drain 10" ϕ
3 in 12
CRM Wall Eliminated
129+00 - 145+00
16' Base
(BM #11 S1.R. 15" Maple 27' lt sta 130+00 El 942.57
BM #12 S1.R. 12" Maple 35' rt sta 134+83 El 979.16
BM #13 S1.R. 18" Elm 35' rt sta 138+22 (subtangent) El 983.16
BM #14 S1.R. 12" Maple 92' lt sta 145+40 El 1025.31
CAVENDISH
Proj. F-no 5A(3)
Sheet 10 of 119

7