




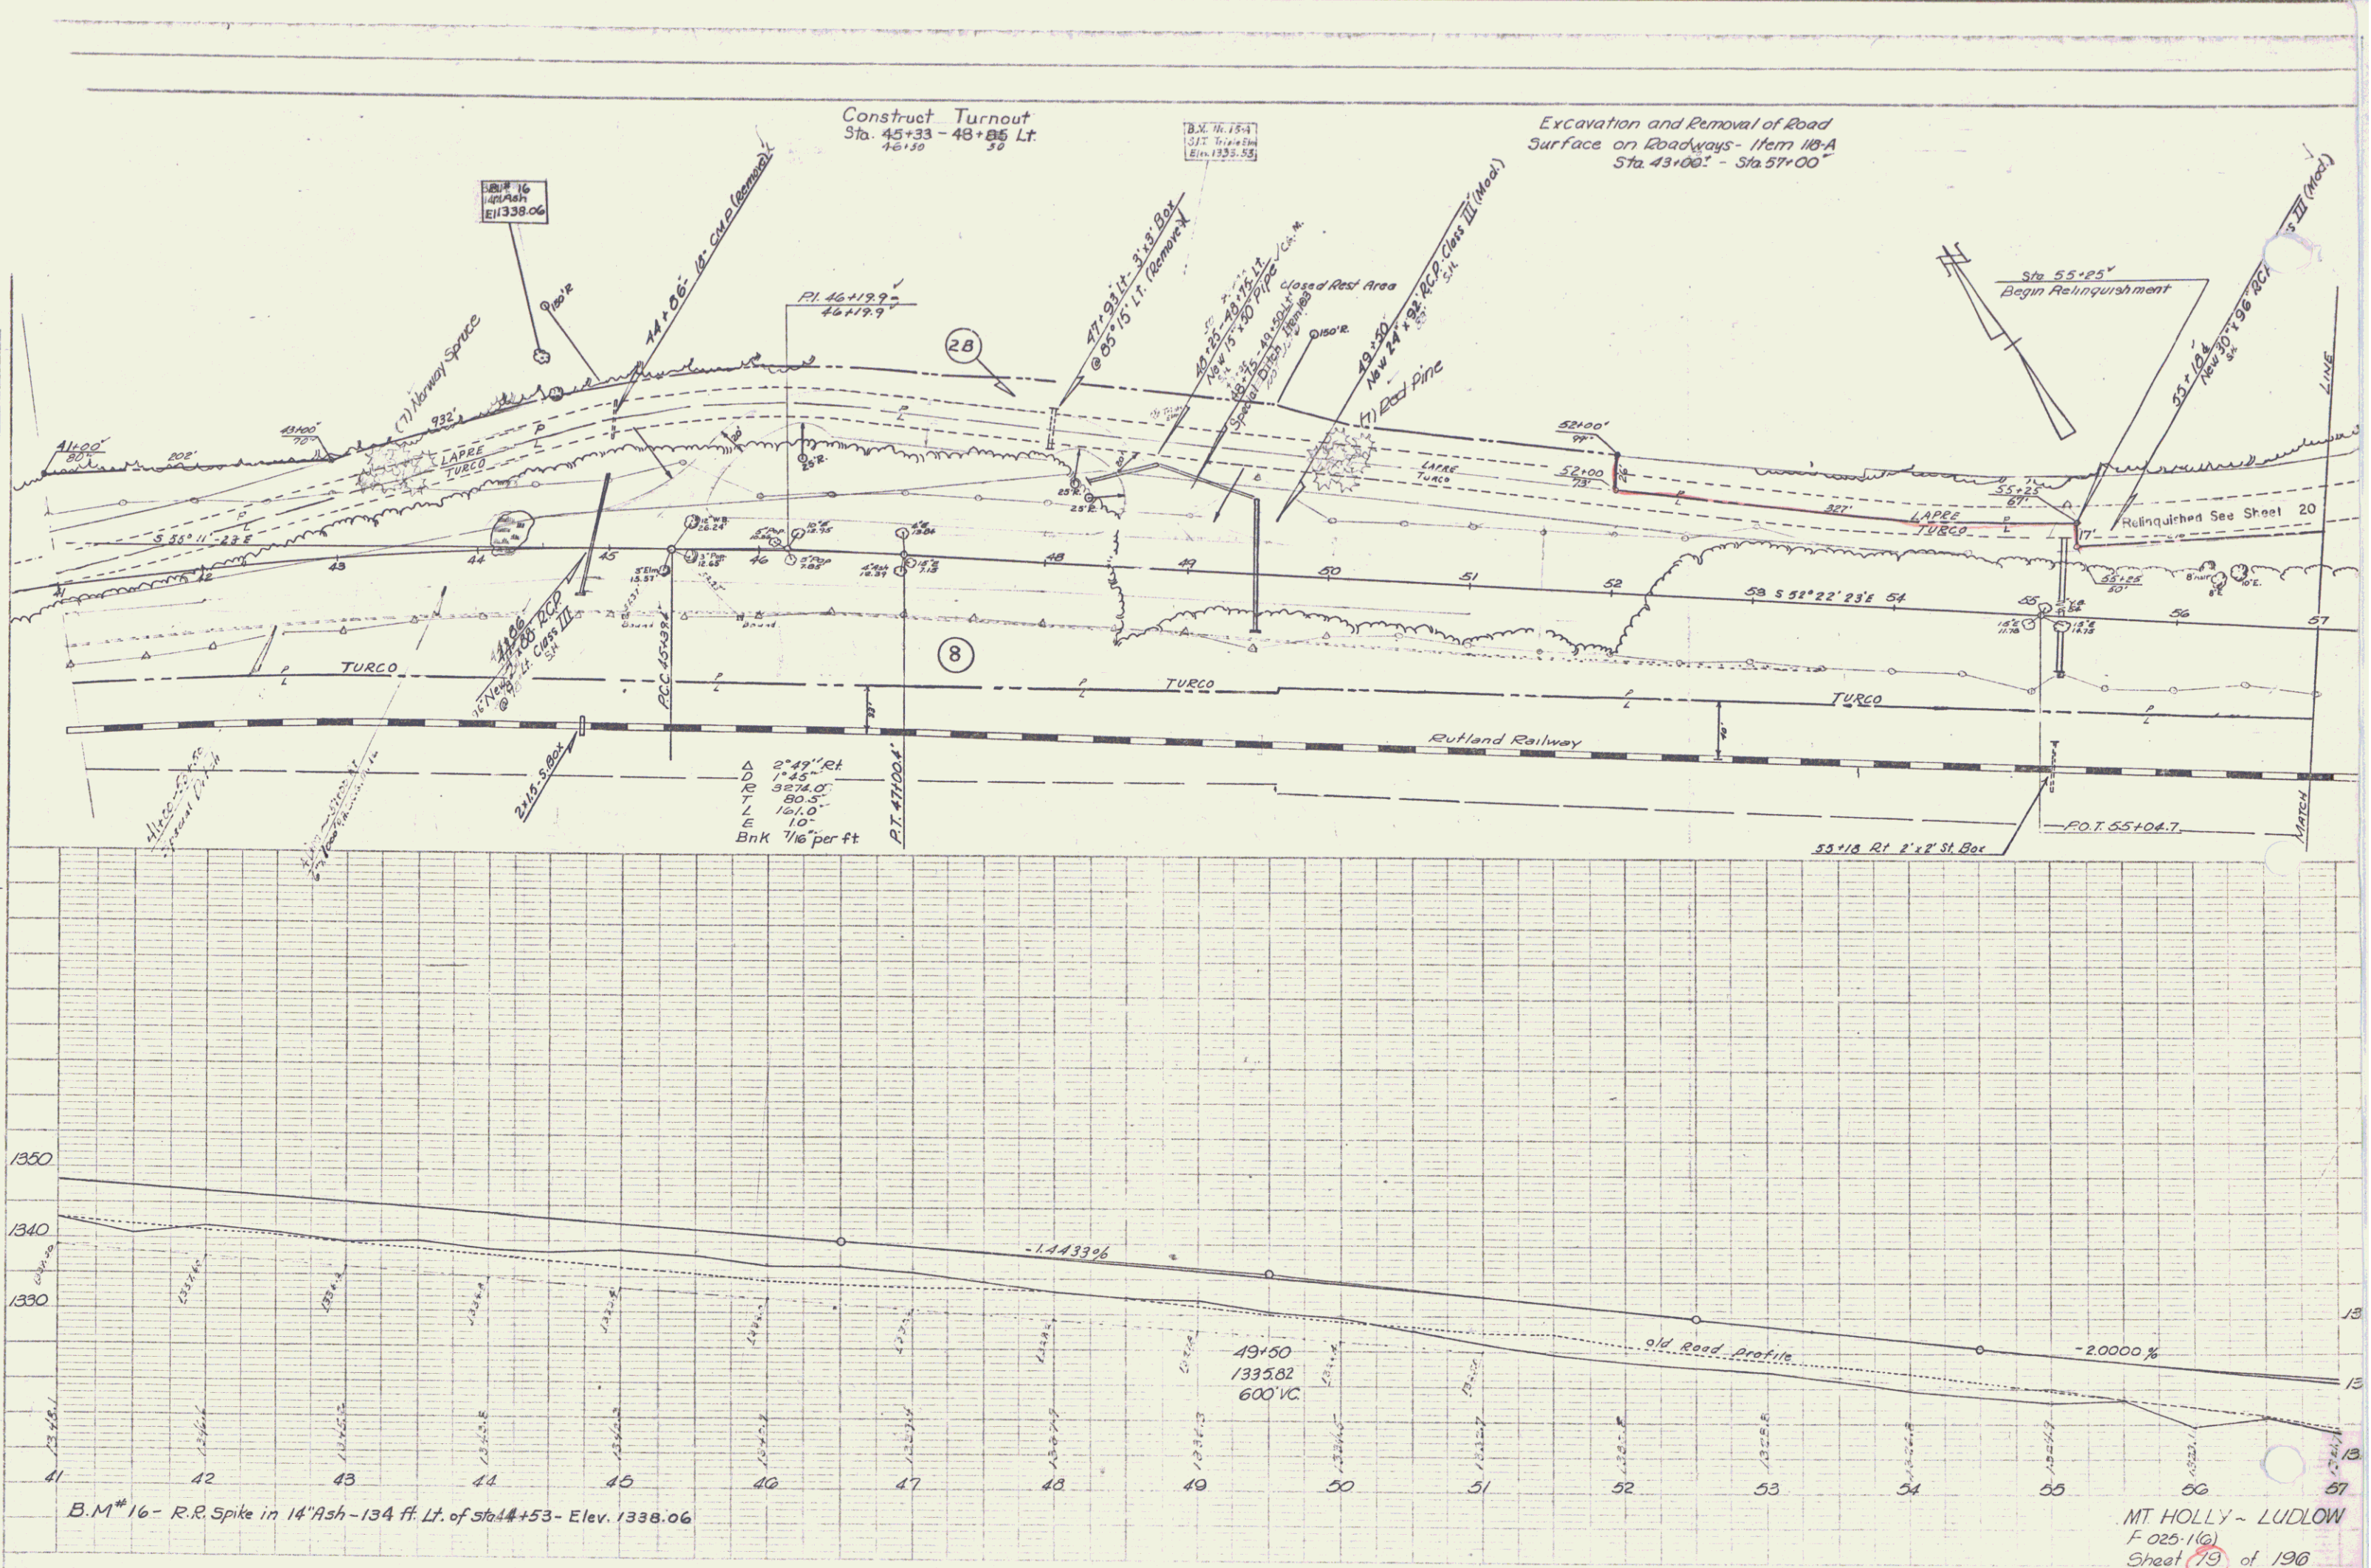

MT HOLLY - LUDLOW
 F. 025-116

5