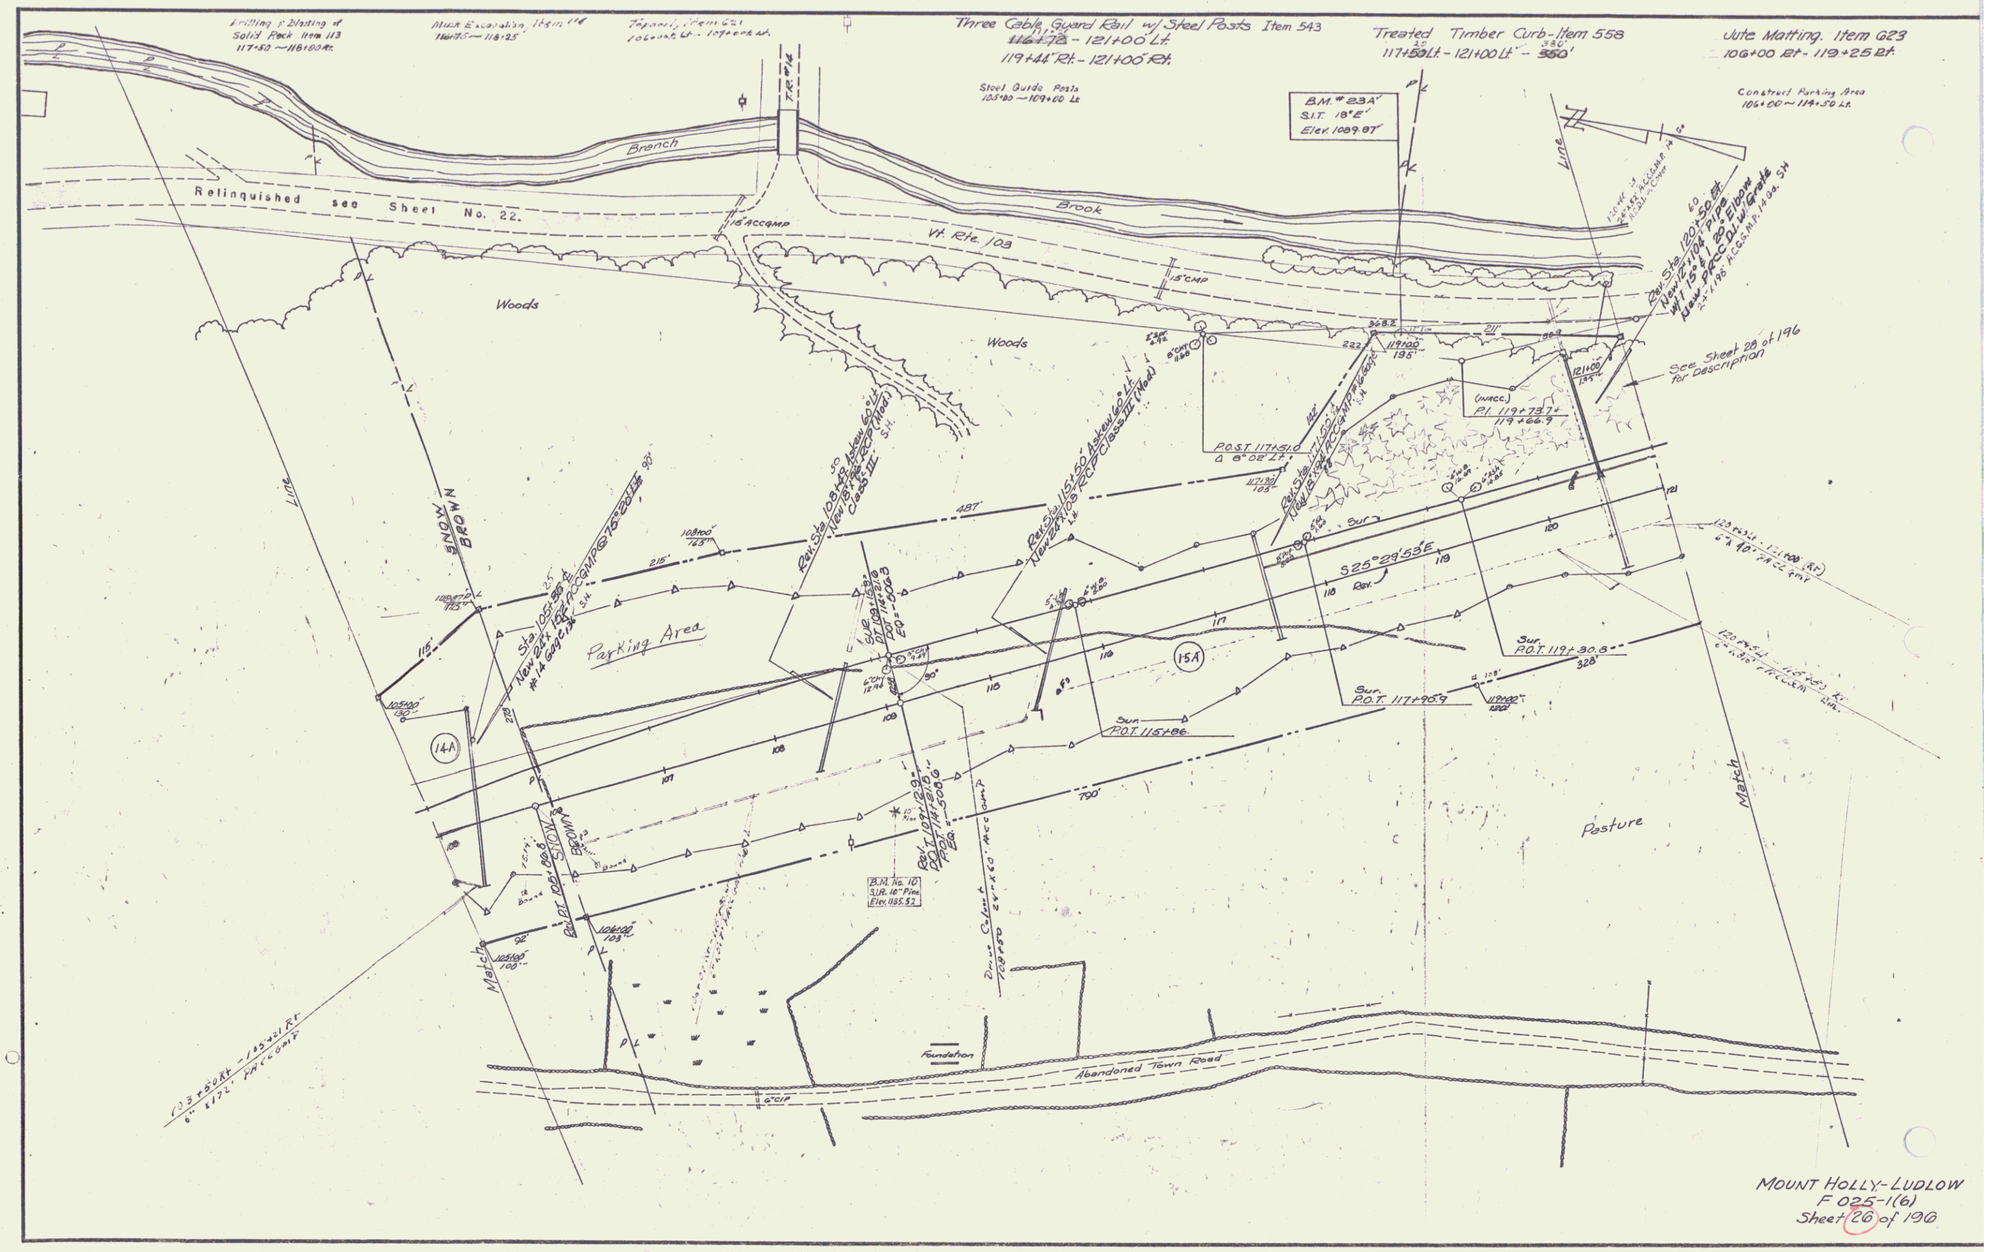

MOUNT HOLLY-LUDLOW
F 025-1(6)
Sheet 26 of 196