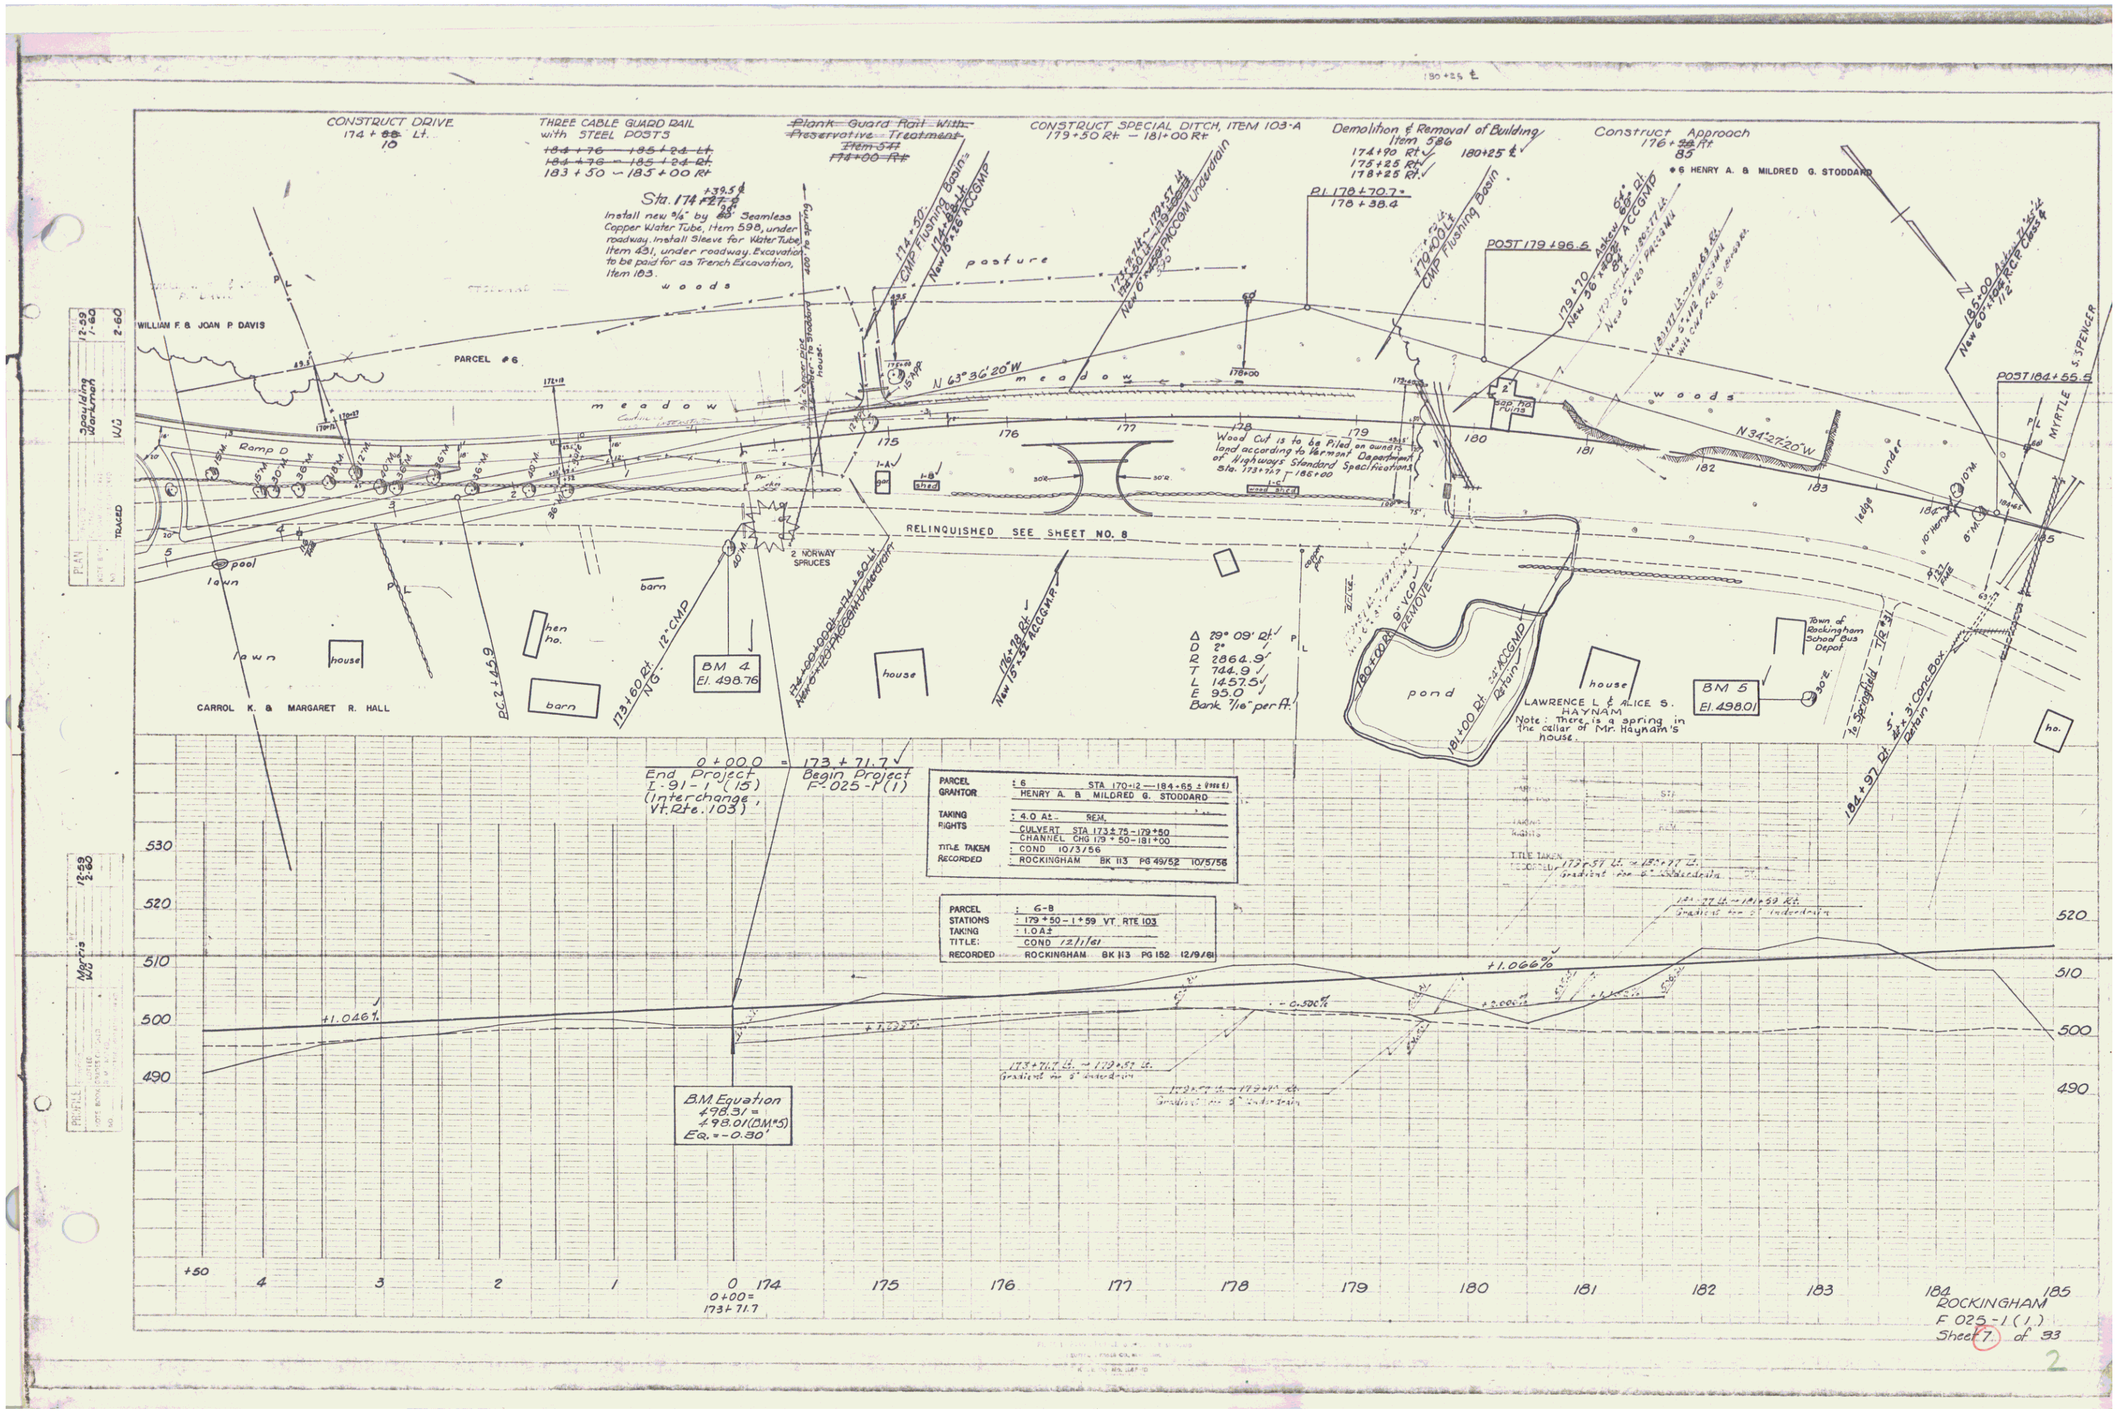
CONSTRUCT DRIVE
174 + 55 Lt.
10
THREE CABLE GUARD RAIL
with STEEL POSTS
183 + 50 – 183 + 00 Rt
Sta. 174 +39.5 Lt
Install new 3/4" by 85' Seamless Copper Water Tube, Item 598, under roadway. Install Sleeve for Water Tube, Item 431, under roadway. Excavation to be paid for as Trench Excavation, Item 103.
CONSTRUCT SPECIAL DITCH, ITEM 103-A
179 + 50 Rt – 181 + 00 Rt
Demolition & Removal of Building
Item 586
174 + 90 Rt
175 + 25 Rt
178 + 25 Rt
180 + 25 Lt
Construct Approach
176 + 22 Rt
85
HENRY A. & MILDRED G. STODDARD
WILLIAM F. & JOAN P. DAVIS
PARCEL #6
CARROL K. & MARGARET R. HALL
LAWRENCE L. & ALICE S. HAYNAM
Note: There is a spring in the cellar of Mr. Haynam's house.
Town of Rockingham School Bus Depot
RELINQUISHED SEE SHEET NO. 8
N 63° 36' 20" W
N 34° 27' 20" W
meadow
woods
pasture
pond
house
barn
lawn
pool
Ramp D
2 NORWAY SPRUCES
BM 4
El. 498.76
BM 5
El. 498.01
POST 179 + 96.5
POST 184 + 55.5
S. SPENCER
MYRTLE
Wood Cut is to be Piled on adjacent land according to Vermont Department of Highways Standard Specifications Sta. 173 + 71.7 – 185 + 00
Δ 29° 09' Rt
D 2°
R 2864.9'
T 744.9'
L 1457.5'
E 95.0'
Bank 1/16" per ft.
0 + 00.0 = 173 + 71.7
End Project I-91-1(15) (Interchange, Vt. Rte. 103)
Begin Project F-025-1(1)
PARCEL 6
GRANTOR HENRY A. & MILDRED G. STODDARD
TAKING RIGHTS 4.0 Ac. – REM.
CULVERT STA 173 + 75 – 179 + 50
CHANNEL CHG 179 + 50 – 181 + 00
TITLE TAKEN COND 10/3/56
RECORDED ROCKINGHAM BK 113 PG 49/52 10/5/56
PARCEL 6-B
STATIONS 179 + 50 – 1 + 59 VT. RTE 103
TAKING 1.0 Ac.
TITLE: COND 12/1/61
RECORDED ROCKINGHAM BK 113 PG 152 12/9/61
+1.046%
+1.066%
-0.596%
B.M. Equation
498.31 =
498.01 (BM #5)
Eq. = -0.30'
530
520
510
500
490
+50
4
3
2
1
0 174
175
176
177
178
179
180
181
182
183
184
185
0 + 00 = 173 + 71.7
ROCKINGHAM
F 025-1(1)
Sheet 7 of 93
2