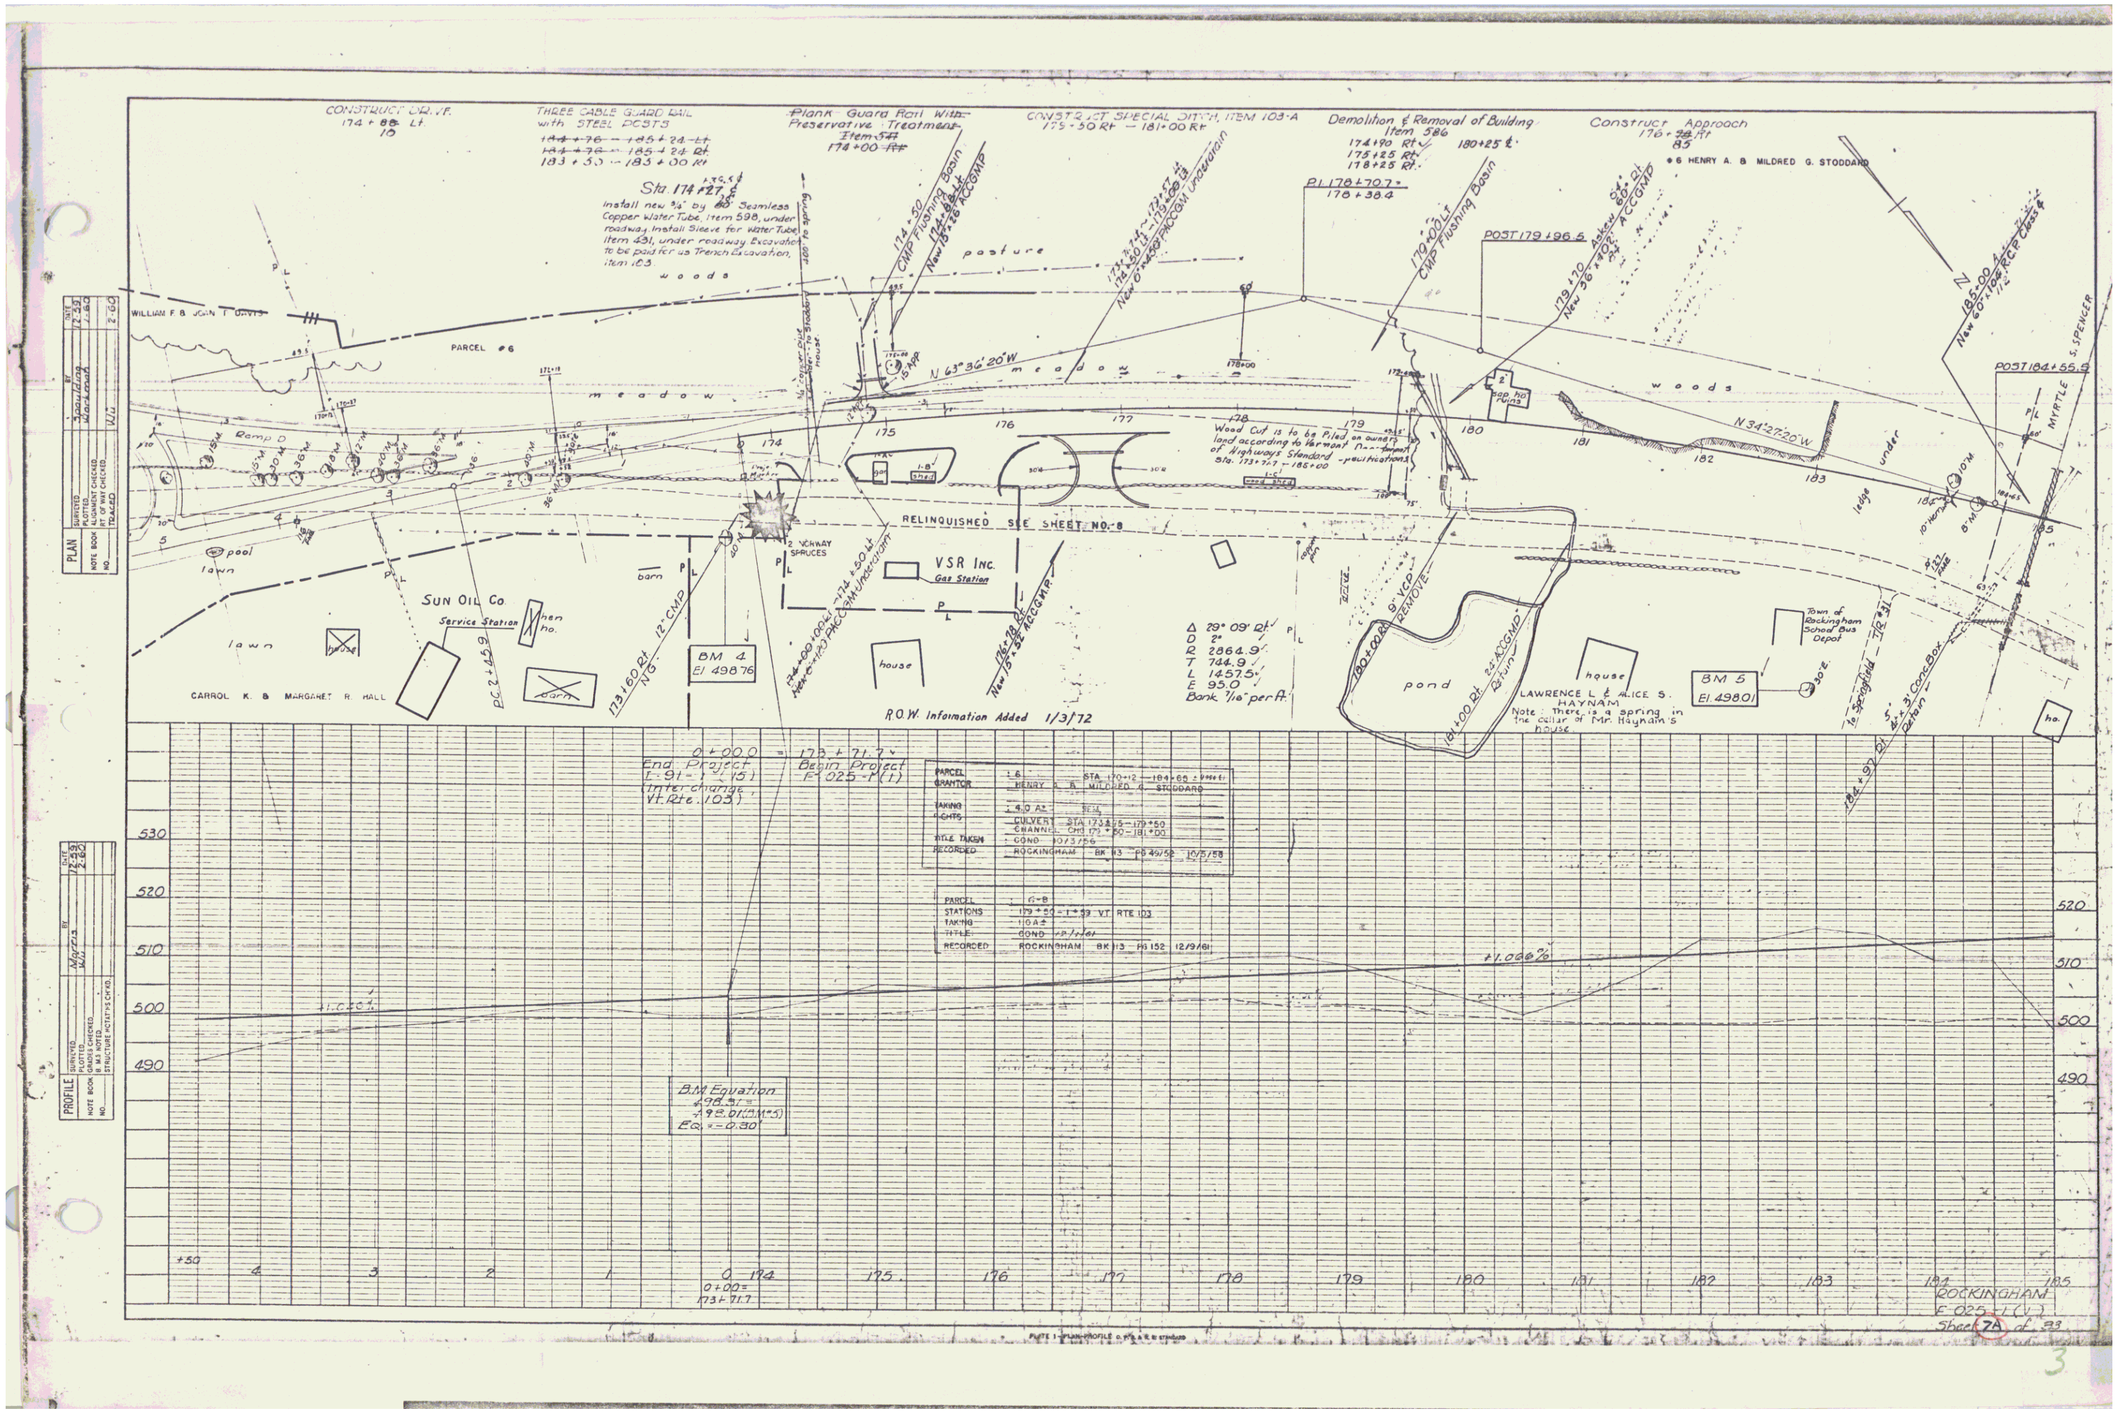
CONSTRUCT DRIVE
174 + 88 Lt.
THREE CABLE GUARD RAIL with STEEL POSTS
183 + 30 – 183 + 00 Rt
Plank Guard Rail With Preservative Treatment
Item 547
178 + 00 Rt
Sta. 174 + 27.5
Install new 3/4" by 60' Seamless Copper Water Tube, Item 598, under roadway. Install Sleeve for Water Tube Item 431, under roadway. Excavation to be paid for as Trench Excavation, item 103.
CONSTRUCT SPECIAL DITCH, ITEM 103-A
175 + 50 Rt – 181 + 00 Rt
Demolition & Removal of Building
Item 586
174 + 90 Rt
175 + 25 Rt
178 + 25 Rt
180 + 25 Lt
Construct Approach
176 + 38 Rt
85
WILLIAM F. & JOAN T. DWYER
PARCEL #6
meadow
pasture
woods
N 63°36'20"W
N 34°27'20"W
Ramp D
pool
lawn
barn
house
pond
RELINQUISHED SEE SHEET NO. 8
VSR Inc.
Gas Station
SUN OIL Co.
Service Station
hen ho.
CARROL K. & MARGARET R. HALL
BM 4
El 49876
BM 5
El 49801
LAWRENCE L. & ALICE S. HAYNAM
Note: There is a spring in the cellar of Mr. Haynam's house
Town of Rockingham School Bus Depot
POST 179 + 96.5
POST 184 + 55.5
MYRTLE
S. SPENCER
Δ 29° 09' Rt
D 2°
R 2864.9'
T 744.9'
L 1457.5'
E 95.0'
Bank 1/16" per ft.
R.O.W. Information Added 1/3/72
End Project
Inter Change
Vt. Rte. 103
0 + 00.0 = 173 + 71.7
Begin Project
F 025-1(1)
PARCEL
GRANTOR
TAKING
TITLE TAKEN
RECORDED
STA 170+12 – 184+65 ± Rt
HENRY A. & MILDRED G. STODDARD
4.0 AC
CULVERT STA 173+25 – 179+50
CHANNEL CH 173+50 – 181+00
COND 10/3/56
ROCKINGHAM BK 93 PG 49/52 10/5/58
PARCEL G-B
STATIONS 179+55 – 1+39 VT RTE 103
TAKING 1.10 A±
TITLE COND
RECORDED ROCKINGHAM BK 113 PG 152 12/9/61
+1.000%
+1.050%
B.M. Equation
498.51 =
498.61(M.S.)
Eq. x = -0.30
530
520
510
500
490
+50
4
3
2
1
0 194
0+00 = 173+71.7
ROCKINGHAM
F 025-1(1)
Sheet 7A of 33
PLAN
PROFILE
PLATE 1 - PLAN-PROFILE O.R.W. & R.R. STANDARD