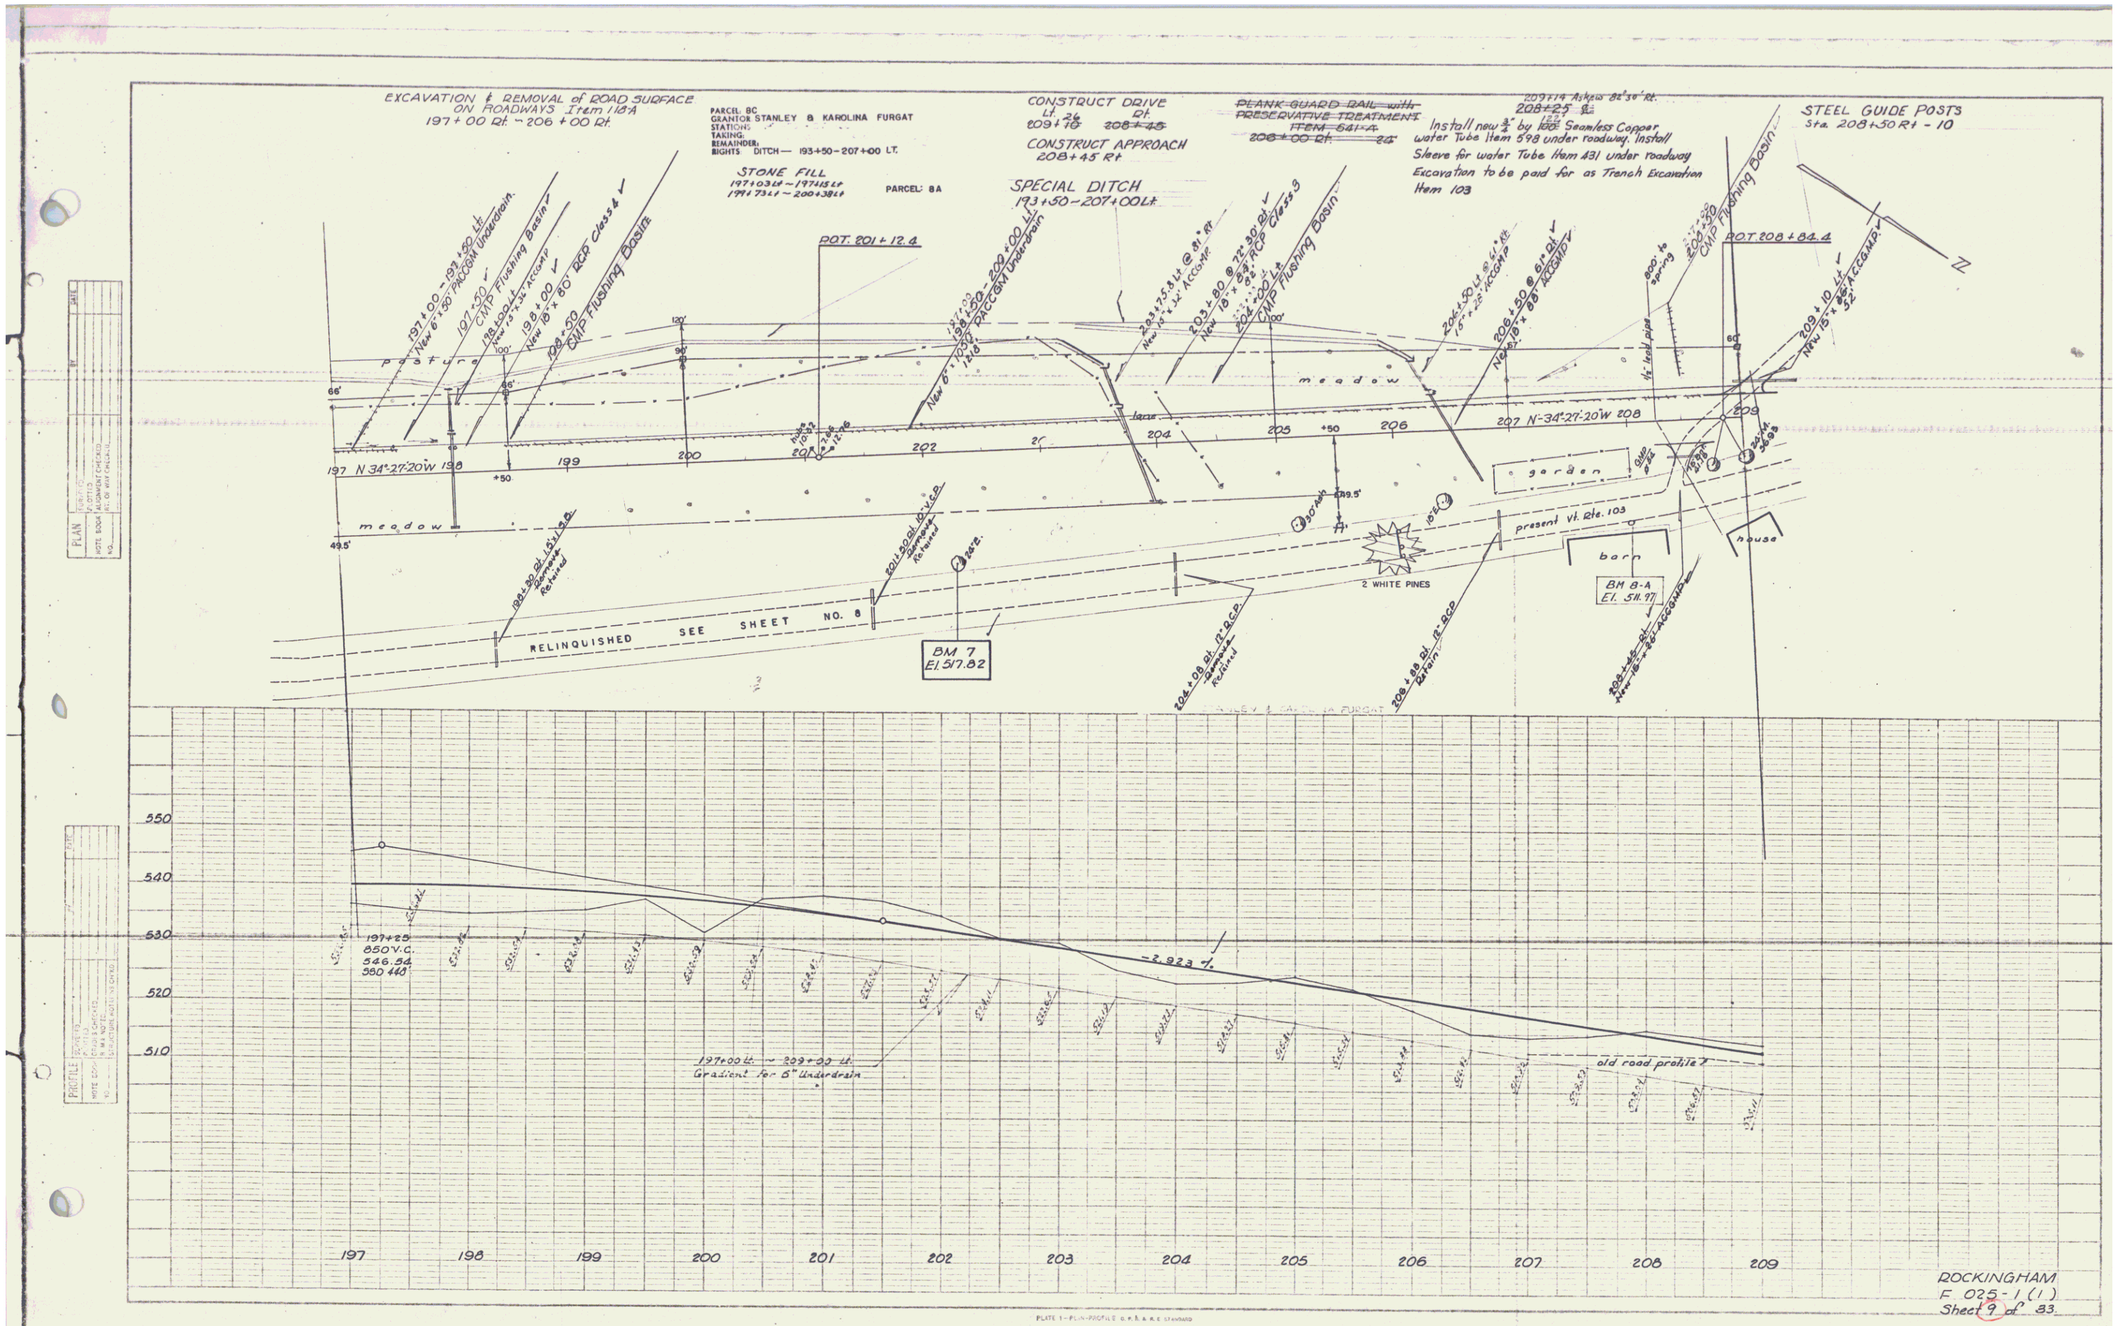

ROCKINGHAM
F 025-1 (1)
Sheet 9 of 33.

5