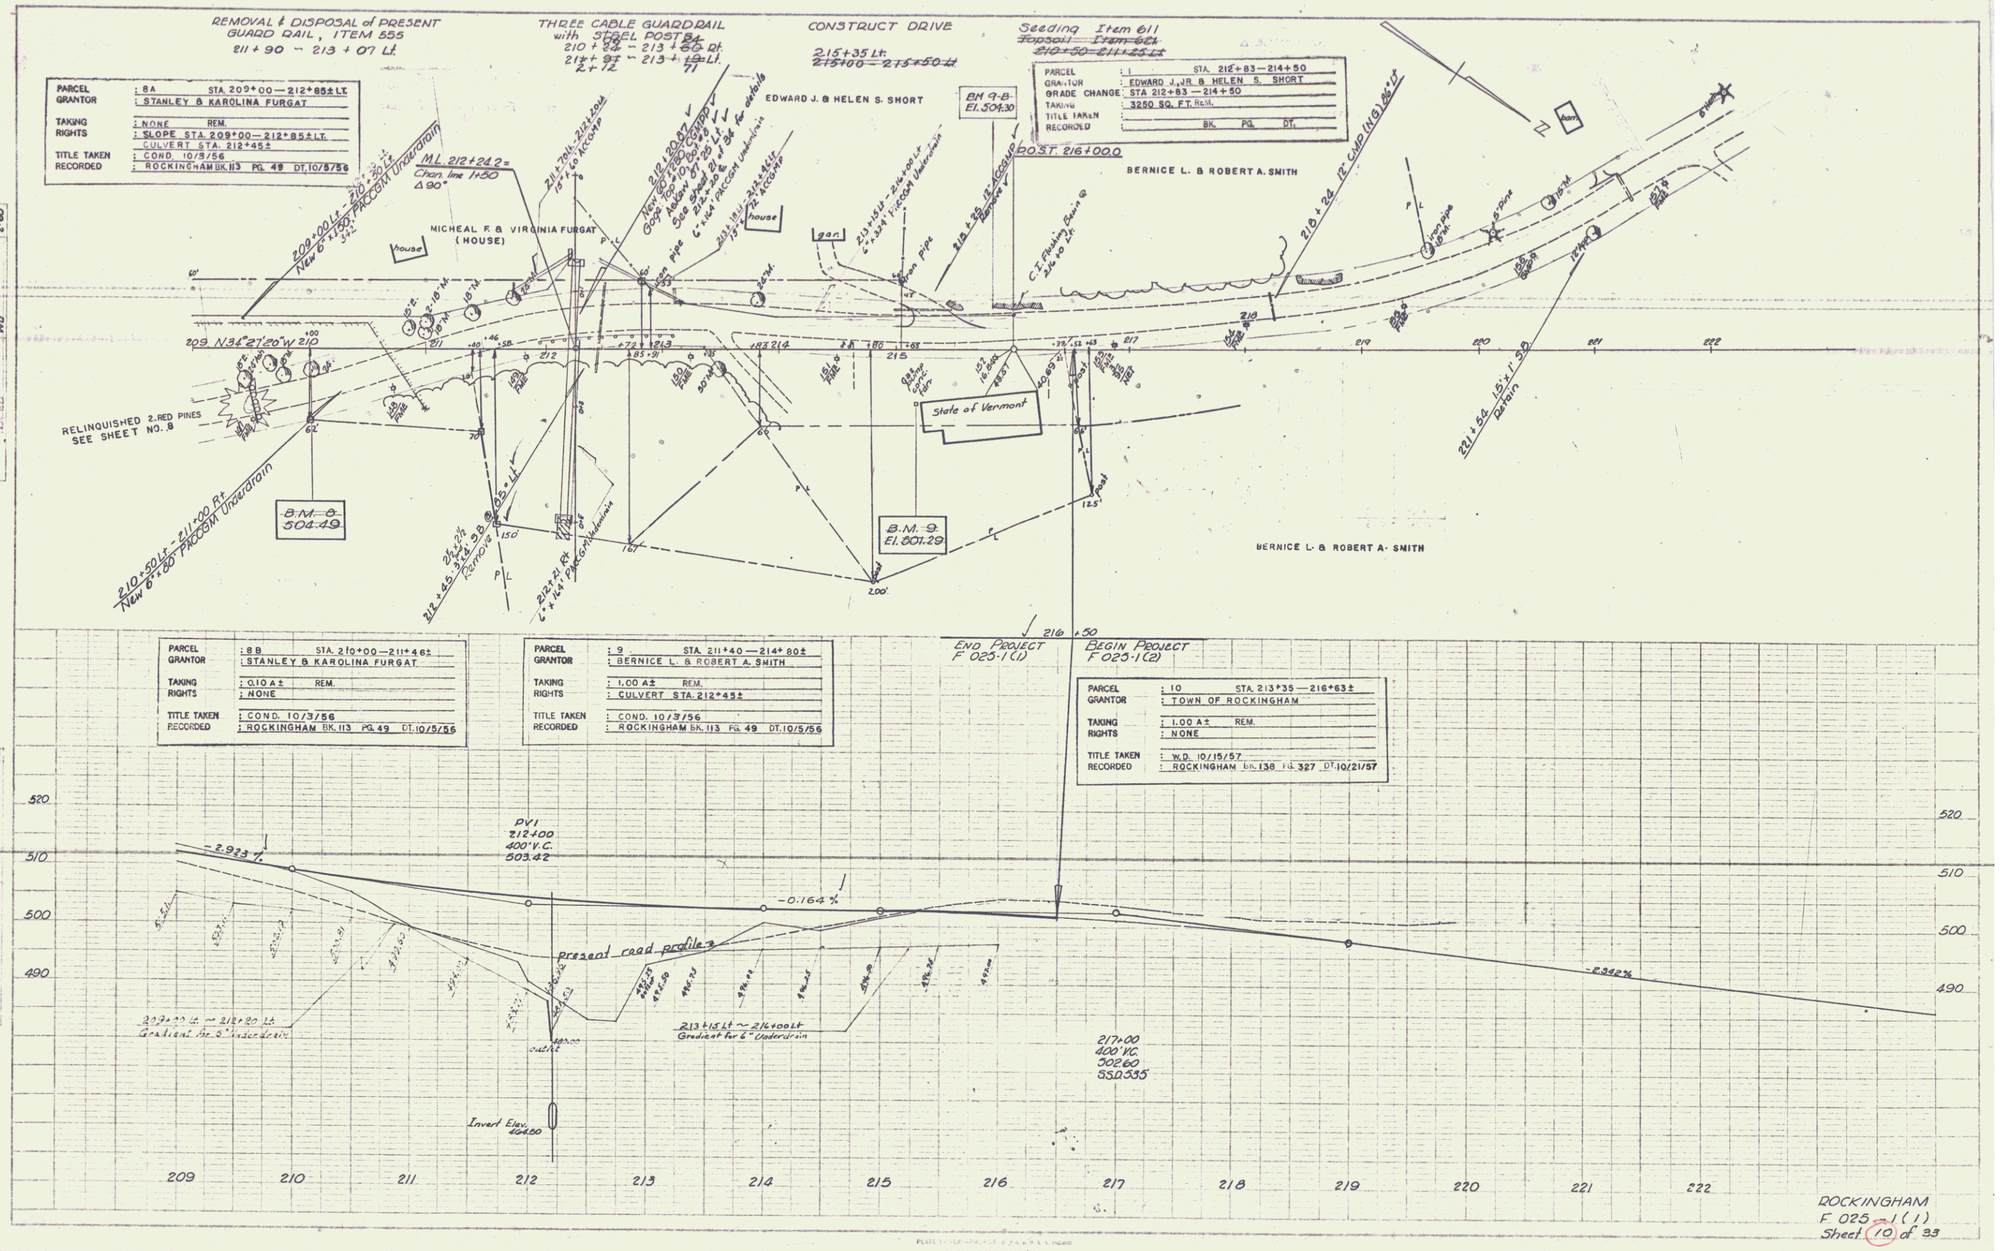

ROCKINGHAM
F 025-1(1)
Sheet 10 of 33

6