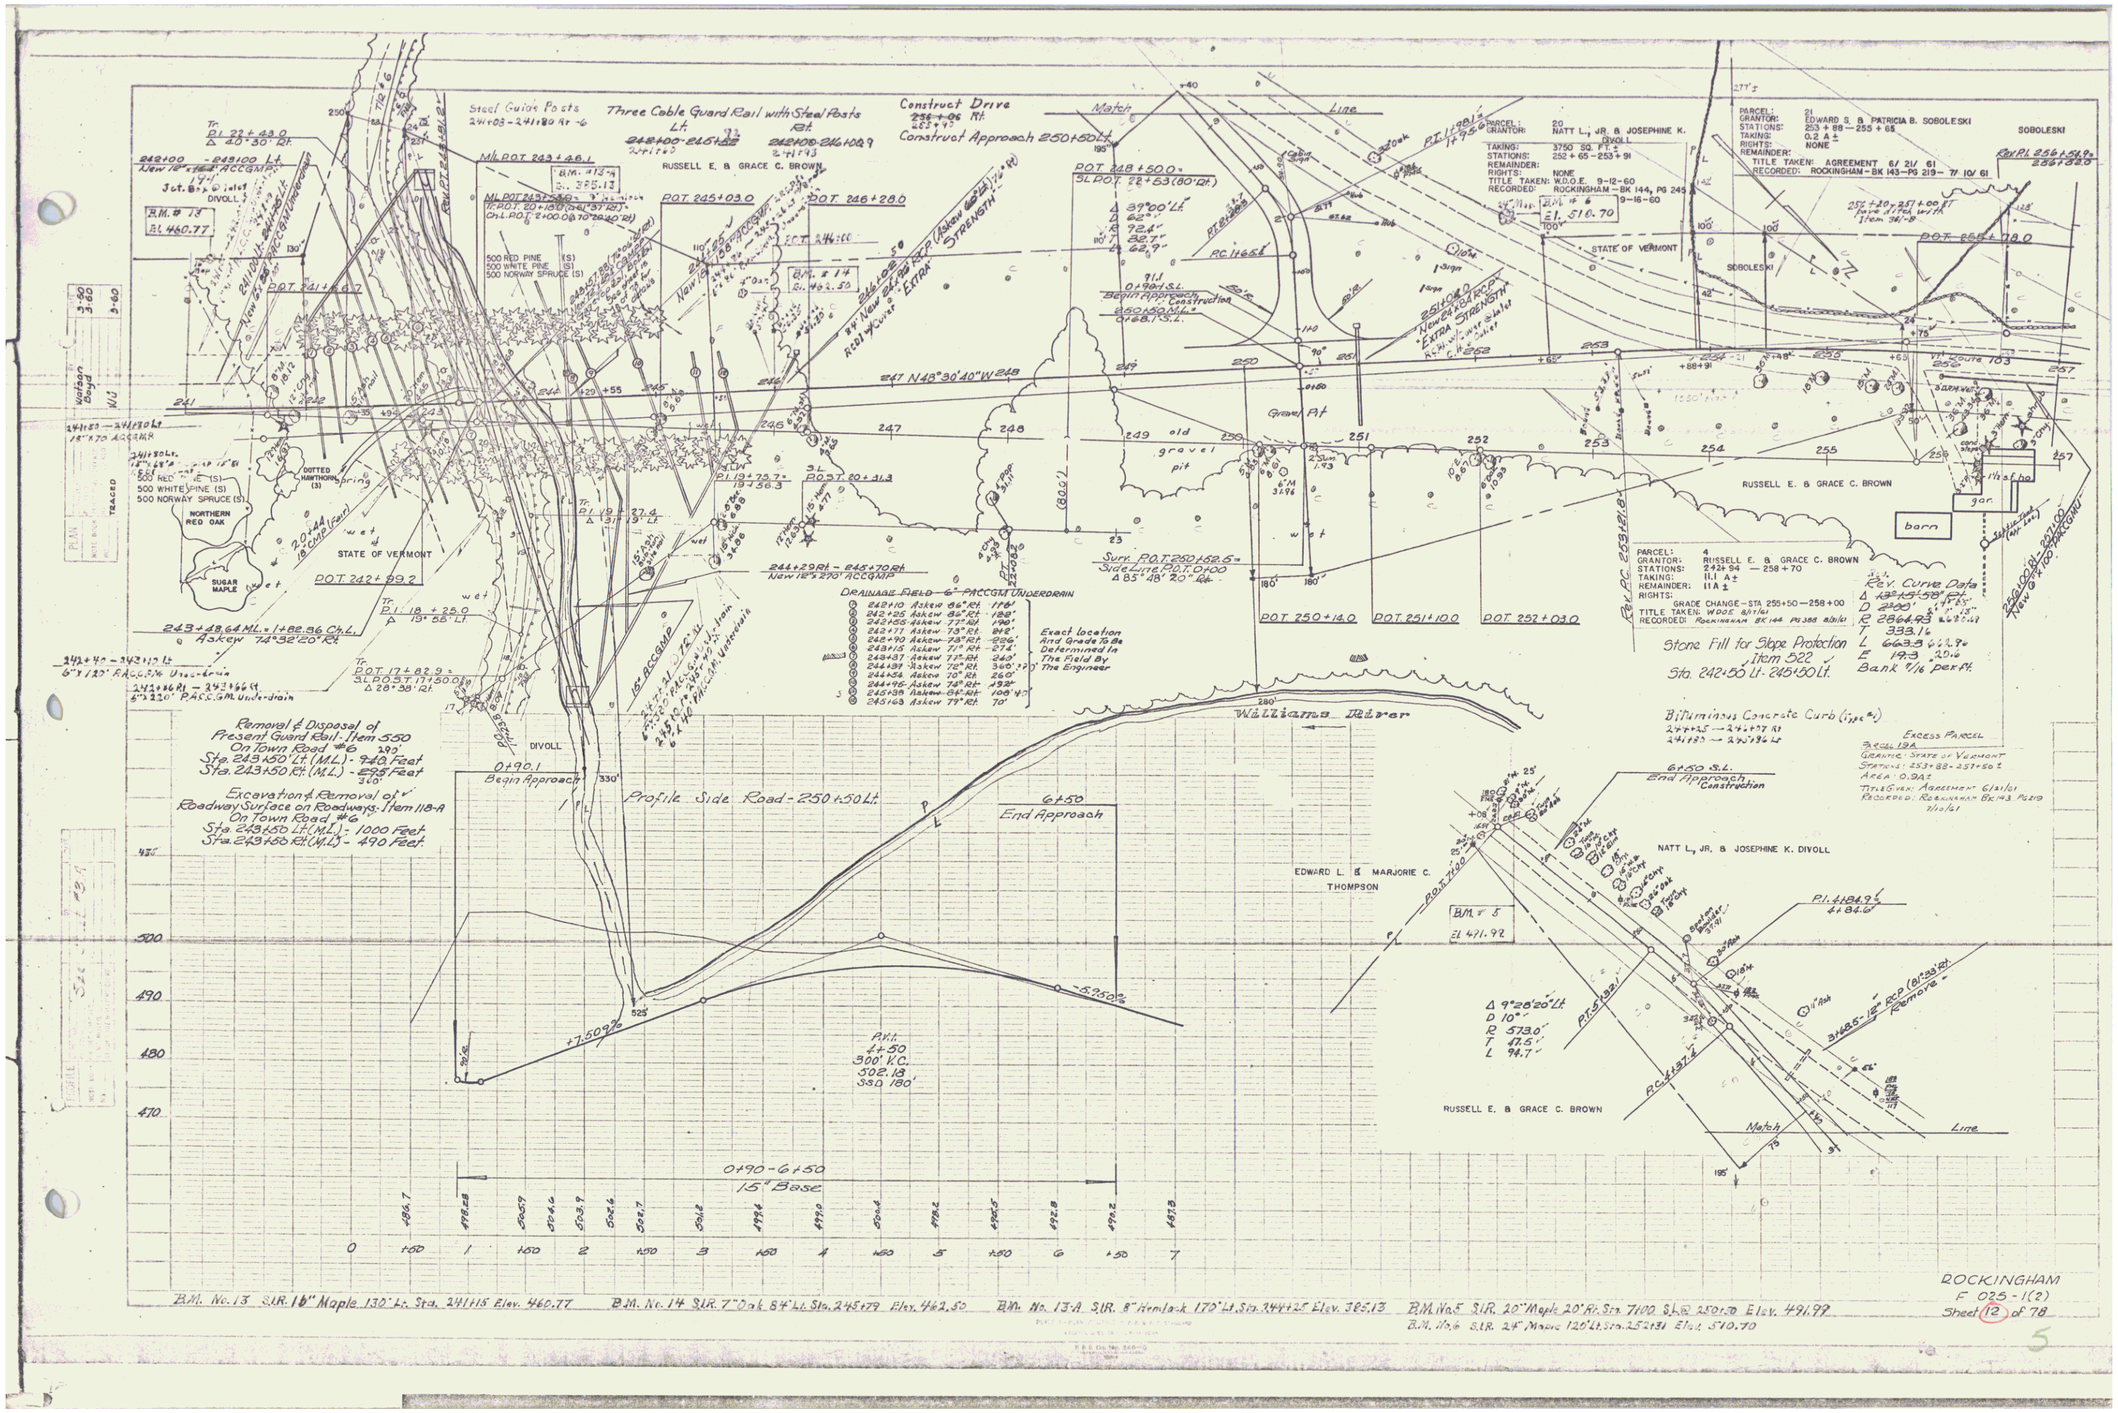
Steel Guide Posts
Three Cable Guard Rail with Steel Posts
Construct Drive
Construct Approach 250+50 Lt.
RUSSELL E. & GRACE C. BROWN
PARCEL: 20
GRANTOR: NATT L., JR. & JOSEPHINE K. DIVOLL
TAKING: 3750 SQ. FT. ±
STATIONS: 252 + 65 – 253 + 91
REMAINDER:
RIGHTS: NONE
TITLE TAKEN: W.O.O.E. 9-12-60
RECORDED: ROCKINGHAM – BK 144, PG 245
PARCEL: 21
GRANTOR: EDWARD S. & PATRICIA B. SOBOLESKI
STATIONS: 253 + 88 – 255 + 65
TAKING: 0.2 A ±
RIGHTS: NONE
REMAINDER:
TITLE TAKEN: AGREEMENT 6/21/61
RECORDED: ROCKINGHAM – BK 143 – PG 219 – 7/10/61
STATE OF VERMONT
SOBOLESKI
PARCEL: 4
GRANTOR: RUSSELL E. & GRACE C. BROWN
STATIONS: 242+94 – 258+70
TAKING: 11.1 A ±
REMAINDER: 11 A ±
RIGHTS: GRADE CHANGE – STA 255+50 – 258+00
TITLE TAKEN: W.O.O.E. 8/17/61
RECORDED: Rockingham BK 144 PG 388 8/21/61
Stone Fill for Slope Protection
Item 522
Sta. 242+50 Lt. - 245+50 Lt.
Rev. Curve Data
Bituminous Concrete Curb (type 2)
EXCESS PARCEL
PARCEL 19A
GRANTEE: STATE OF VERMONT
STATIONS: 253+88 - 257+50 ±
AREA: 0.9A±
TITLE GIVEN: AGREEMENT 6/21/61
RECORDED: ROCKINGHAM BK 143 PG 219 7/10/61
Drainage Field 6" PACCGM Underdrain
Exact location And Grade To Be Determined In The Field By The Engineer
Williams River
Profile Side Road - 250+50 Lt.
0+90.1 Begin Approach
6+50 End Approach
P.V.I. 4+50 300' V.C. 502.18 330' 180'
0+90 - 6+50 15" Base
Removal & Disposal of Present Guard Rail: Item 550 On Town Road #6
Sta. 243+50 Lt. (M.L.) - 948 Feet
Sta. 243+50 Rt. (M.L.) - 598 Feet
Excavation & Removal of Roadway Surface on Roadways: Item 118-A On Town Road #6
Sta. 243+50 Lt. (M.L.) - 1000 Feet
Sta. 243+50 Rt. (M.L.) - 490 Feet
NATT L., JR. & JOSEPHINE K. DIVOLL
EDWARD L. & MARJORIE C. THOMPSON
RUSSELL E. & GRACE C. BROWN
B.M. No. 13 S.I.R. 16" Maple 130' Lt. Sta. 241+15 Elev. 460.77
B.M. No. 14 S.I.R. 7" Oak 84' Lt. Sta. 245+79 Elev. 462.50
B.M. No. 13-A S.I.R. 8" Hemlock 170' Lt. Sta. 244+25 Elev. 385.13
B.M. No. 5 S.I.R. 20" Maple 20' Rt. Sta. 7+00 Sl. @ 250+50 Elev. 491.99
B.M. No. 6 S.I.R. 24" Maple 120' Lt. Sta. 252+31 Elev. 510.70
ROCKINGHAM
F 025-1(2)
Sheet 12 of 78