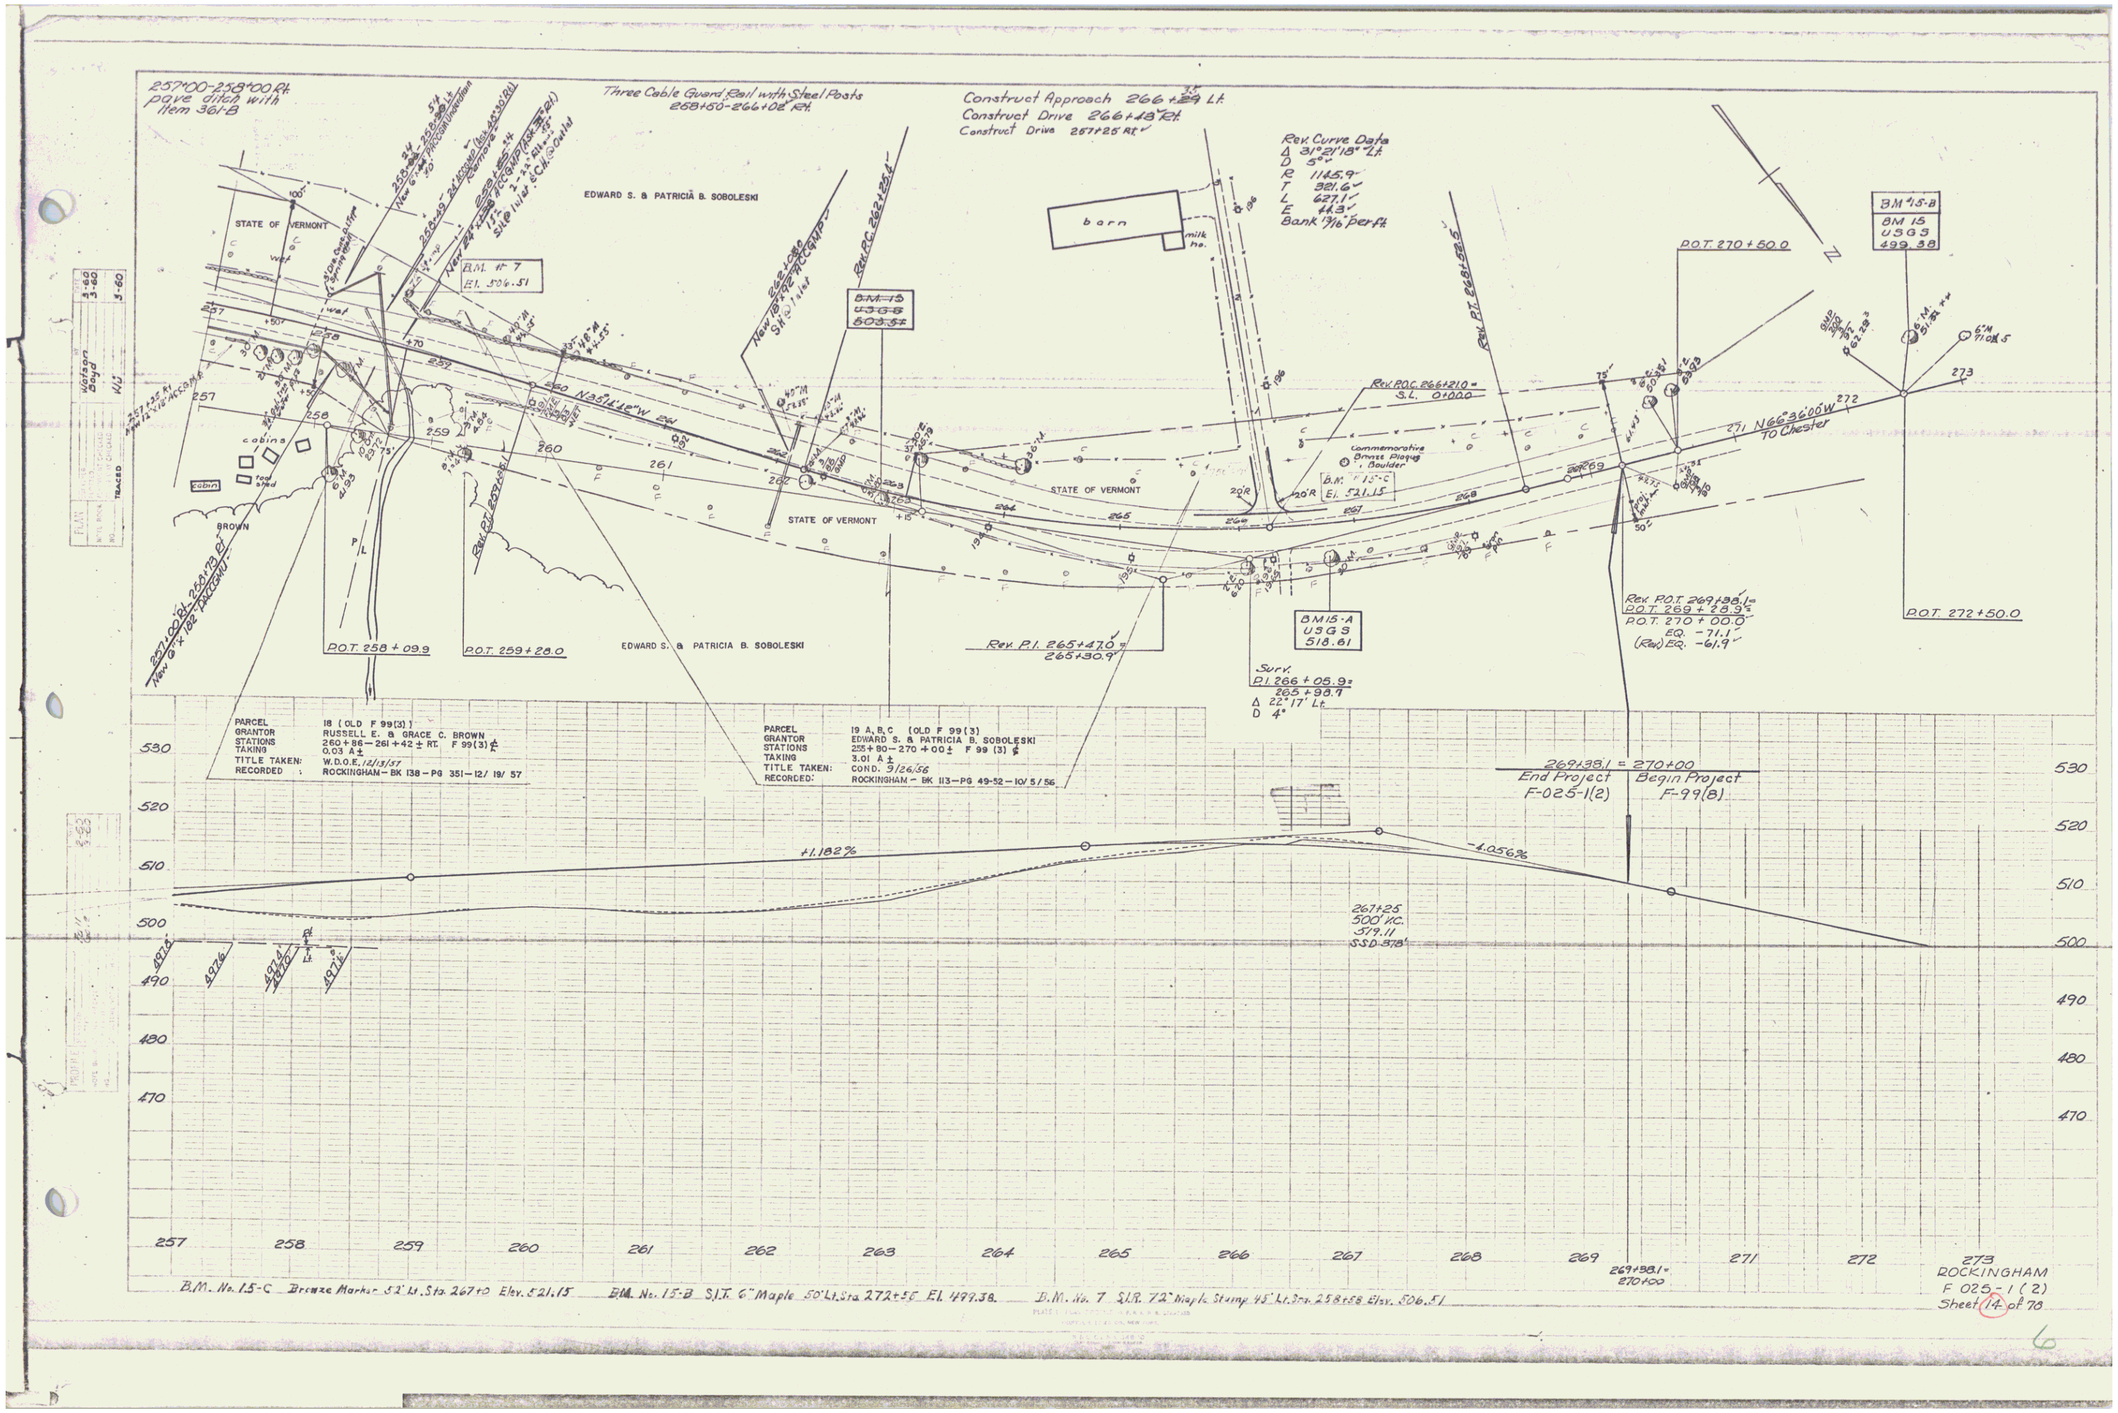
257+00-258+00 Rt.
pave ditch with
Item 361-B
Three Cable Guard Rail with Steel Posts
258+50-266+02 Rt.
Construct Approach 266+29 Lt.
Construct Drive 266+18 Rt.
Construct Drive 257+25 Rt.
Rev. Curve Data
Δ 31°21'18" Lt.
D 5°
R 1145.9'
T 321.6'
L 627.1'
E 44.3'
Bank 3/16" per ft.
EDWARD S. & PATRICIA B. SOBOLESKI
STATE OF VERMONT
B.M. # 7
El. 506.51
B.M. 15
USGS
503.51
born
milk ho.
cabins
cabin
BROWN
N 66°14'48" W
Rev. P.O.C. 266+21.0 =
S.L. 0+00.0
Commemorative
Brass Plaque
Boulder
B.M. 15-C
El. 521.15
N 66°36'00" W
To Chester
B.M. 15-B
BM 15
USGS
499.38
P.O.T. 270+50.0
P.O.T. 272+50.0
P.O.T. 258+09.9
P.O.T. 259+28.0
Rev. P.I. 265+47.0 =
265+30.9'
BM 15-A
USGS
518.61
Surv.
P.I. 266+05.9 =
265+98.9
Δ 22° 17' Lt.
D 4°
Rev. P.O.T. 269+38.1 =
P.O.T. 269+28.3 =
P.O.T. 270+00.0
EQ. -71.1
(Rev) EQ. -61.9
PARCEL 18 (OLD F 99(3))
GRANTOR RUSSELL E. & GRACE C. BROWN
STATIONS 260+86—261+42 ± RT. F 99(3) ℄
TAKING 0.03 A ±
TITLE TAKEN: W.D.O.E. 12/3/57
RECORDED : ROCKINGHAM—BK 138—PG 351—12/19/57
PARCEL 19 A, B, C (OLD F 99(3))
GRANTOR EDWARD S. & PATRICIA B. SOBOLESKI
STATIONS 255+80—270+00 ± F 99 (3) ℄
TAKING 3.01 A ±
TITLE TAKEN: COND. 9/26/56
RECORDED: ROCKINGHAM—BK 113—PG 49-52—10/5/56
269+38.1 = 270+00
End Project F-025-1(2)
Begin Project F-99(8)
+1.182%
-1.056%
267+25
500' V.C.
519.11
SSD-878'
B.M. No. 15-C Bronze Marker 52' Lt. Sta. 267+0 Elev. 521.15
B.M. No. 15-B S.I.T. 6" Maple 50' Lt. Sta. 272+55 El. 499.38
B.M. No. 7 S.I.P. 72" Maple Stump 45' Lt. Sta. 258+58 Elev. 506.51
ROCKINGHAM
F 025-1(2)
Sheet 14 of 78