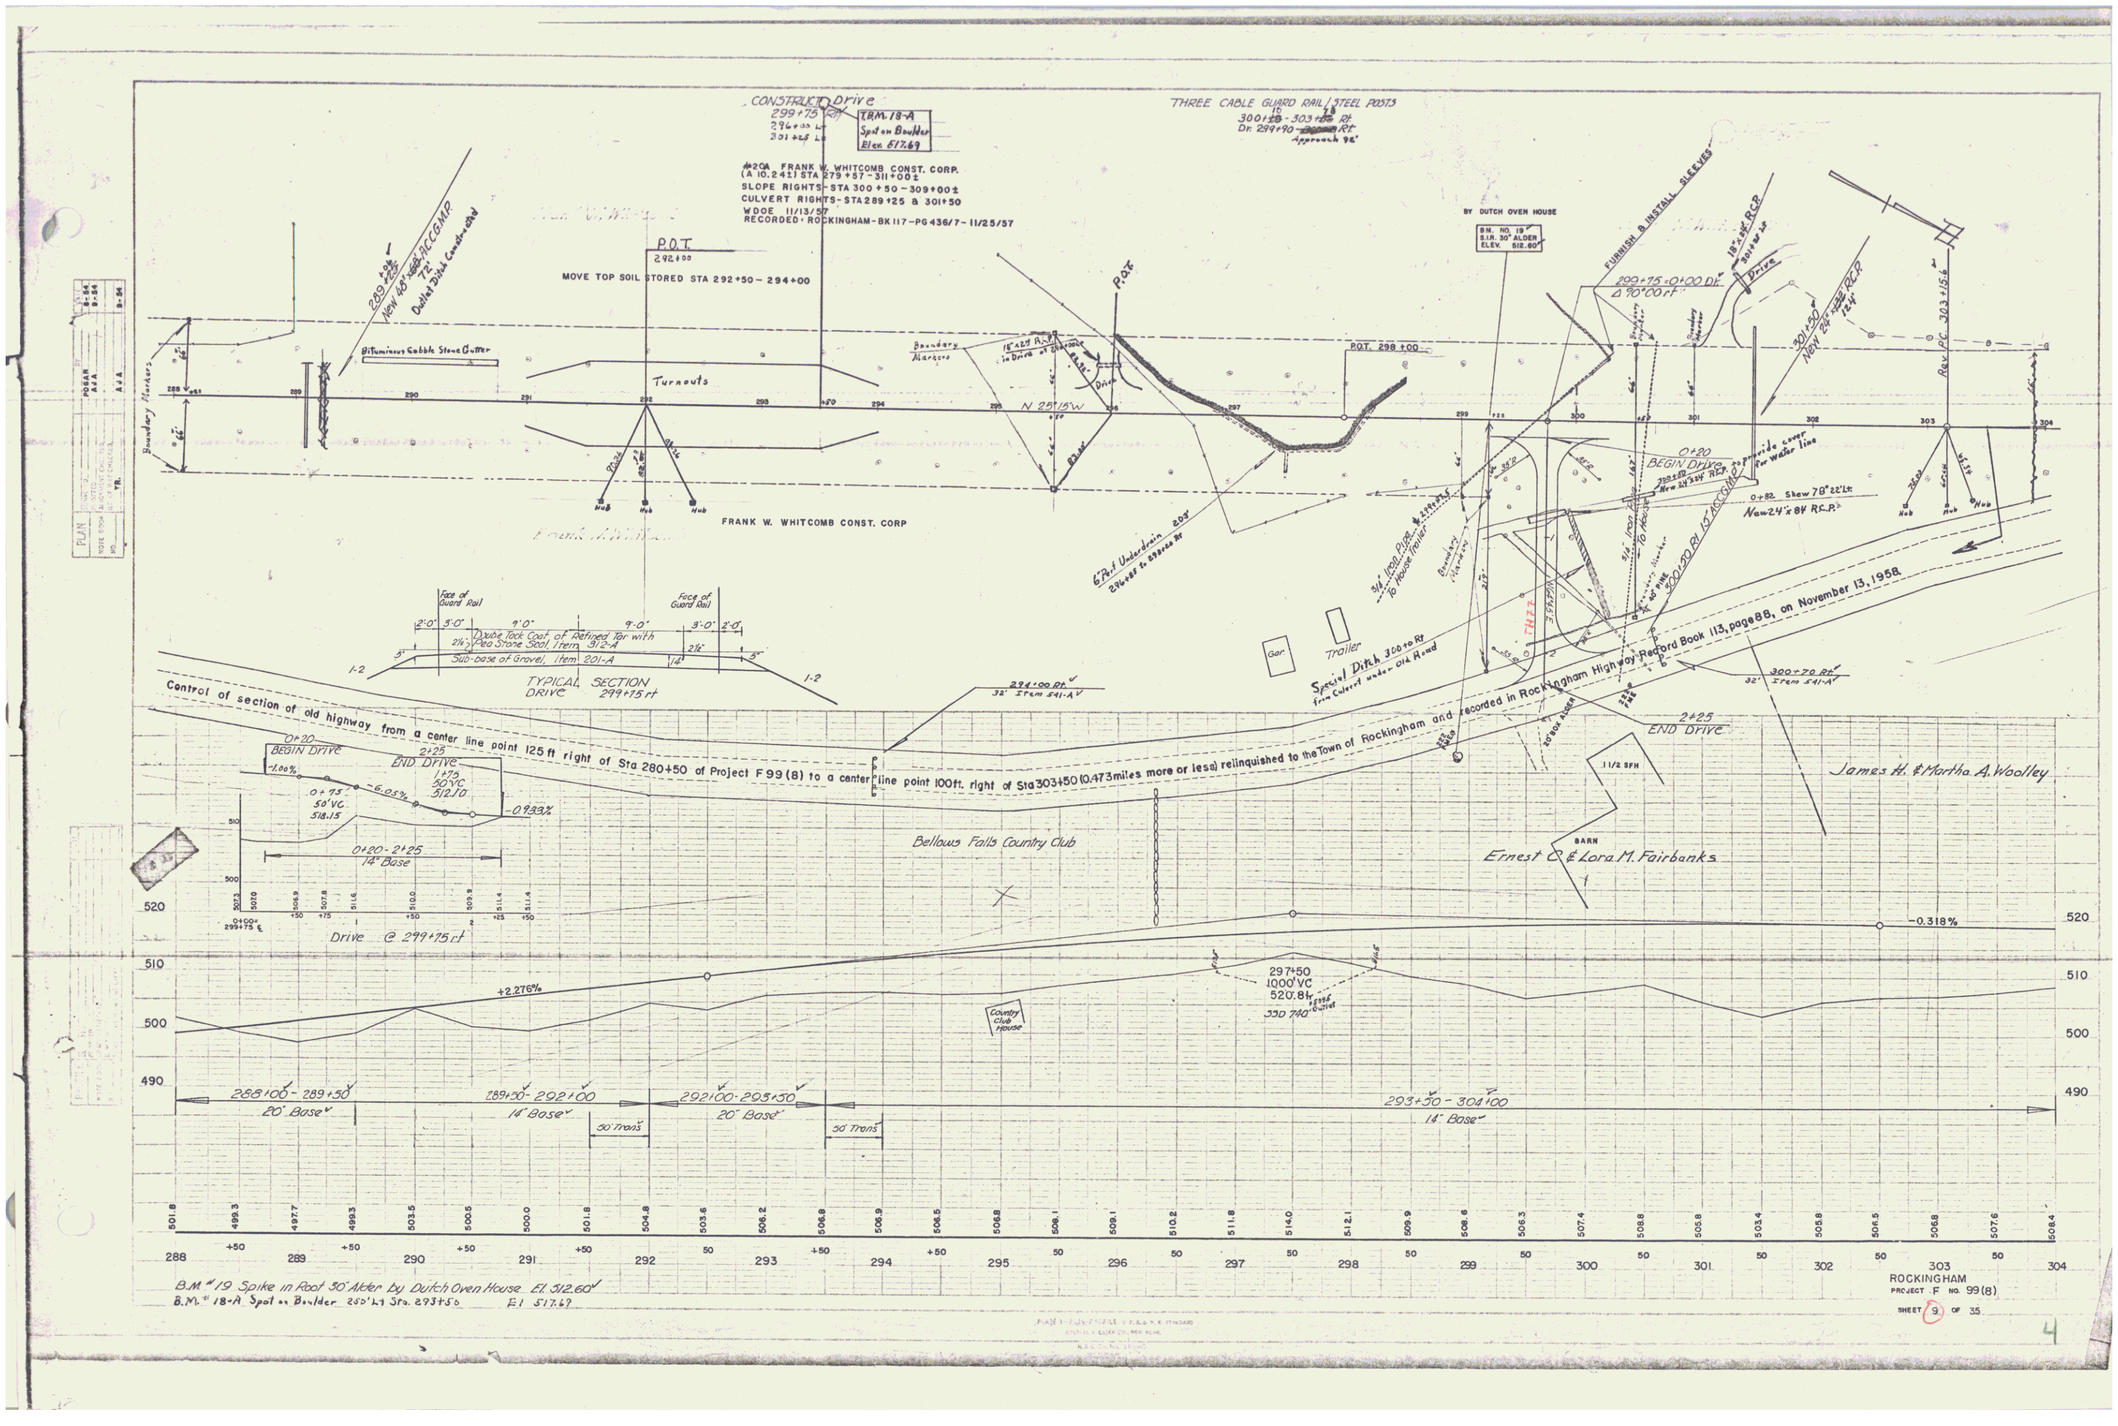
CONSTRUCT Drive
299+75 Rt
296+25 Lt
301+25 Lt
TRM. 18-A
Spot on Boulder
Elev. 517.69
THREE CABLE GUARD RAIL / STEEL POSTS
300+15 - 303+15 Rt
Dr. 299+90 Rt
Approach 98'
#20A FRANK W. WHITCOMB CONST. CORP.
(A.10.2421) STA 279+57 - 311+00±
SLOPE RIGHTS - STA 300+50 - 309+00±
CULVERT RIGHTS - STA 289+25 & 301+50
WDOE 11/13/57
RECORDED - ROCKINGHAM - BK 117 - PG 436/7 - 11/25/57
BY DUTCH OVEN HOUSE
B.M. NO. 19
B.I.R. 30" ALDER
ELEV. 512.60'
FURNISH & INSTALL SLEEVES
289+25 - 0+00 Dr.
Δ 90°00' rt
289+25
New 48" RCP
72'
Outlet Ditch Condition Good
Bituminous Cobble Stone Gutter
P.O.T.
292+00
MOVE TOP SOIL STORED STA 292+50 - 294+00
Turnouts
Boundary Markers
18" RCP
to Drive at Station
Drive
N 25°15'W
P.O.T.
P.O.T. 298+00
18" RCP
301+50
New 24" RCP
72'
Drive
Rev. P.C. 303+15.6
0+20
BEGIN Drive
Provide cover for water line
0+82 Skew 78°22' Lt.
New 24" x 84' RCP
FRANK W. WHITCOMB CONST. CORP
6" Pvc Underdrain 209'
294+85 to Station 86
3/4" Iron Pipe to House Trailer
Gar
Trailer
Special Ditch 300+0 Rt
from Culvert under Old Road
300+70 Rt
32' Item 541-A
294+00 Rt
32' Item 541-A
2+25
END Drive
1 1/2 SFH
James H. & Martha A. Woolley
Face of Guard Rail
2'-0' 5'-0' 9'-0' 9'-0' 3'-0' 2'-0'
Double Tack Coat of Refined Tar with
2½" Pea Stone Seal, Item 312-A
Sub-base of Gravel, Item 201-A
TYPICAL SECTION
DRIVE 299+75 rt
Control of section of old highway from a center line point 125 ft right of Sta 280+50 of Project F 99 (8) to a center line point 100 ft. right of Sta 303+50 (0.473 miles more or less) relinquished to the Town of Rockingham and recorded in Rockingham Highway Record Book 113, page 88, on November 13, 1958.
0+20
BEGIN Drive
+1.00%
0+75
50' VC
518.15
-6.05%
2+25
END Drive
1+75
50' VC
512.10
-0.933%
0+20 - 2+25
14' Base
Drive @ 299+75 rt
Bellows Falls Country Club
Ernest O. & Lora M. Fairbanks
BARN
-0.318%
+2.276%
297+50
1000' VC
520.81
330' 740' to Outlet
Country Club house
288+00 - 289+50
20' Base
289+50 - 292+00
14' Base
50' Trans
292+00 - 295+50
20' Base
50' Trans
293+50 - 304+00
14' Base
B.M. #19 Spike in Root 30" Alder by Dutch Oven House El. 512.60'
B.M. #18-A Spot on Boulder 250' Lt. Sta. 293+50 El. 517.69
ROCKINGHAM
PROJECT F NO. 99(8)
SHEET 9 OF 35