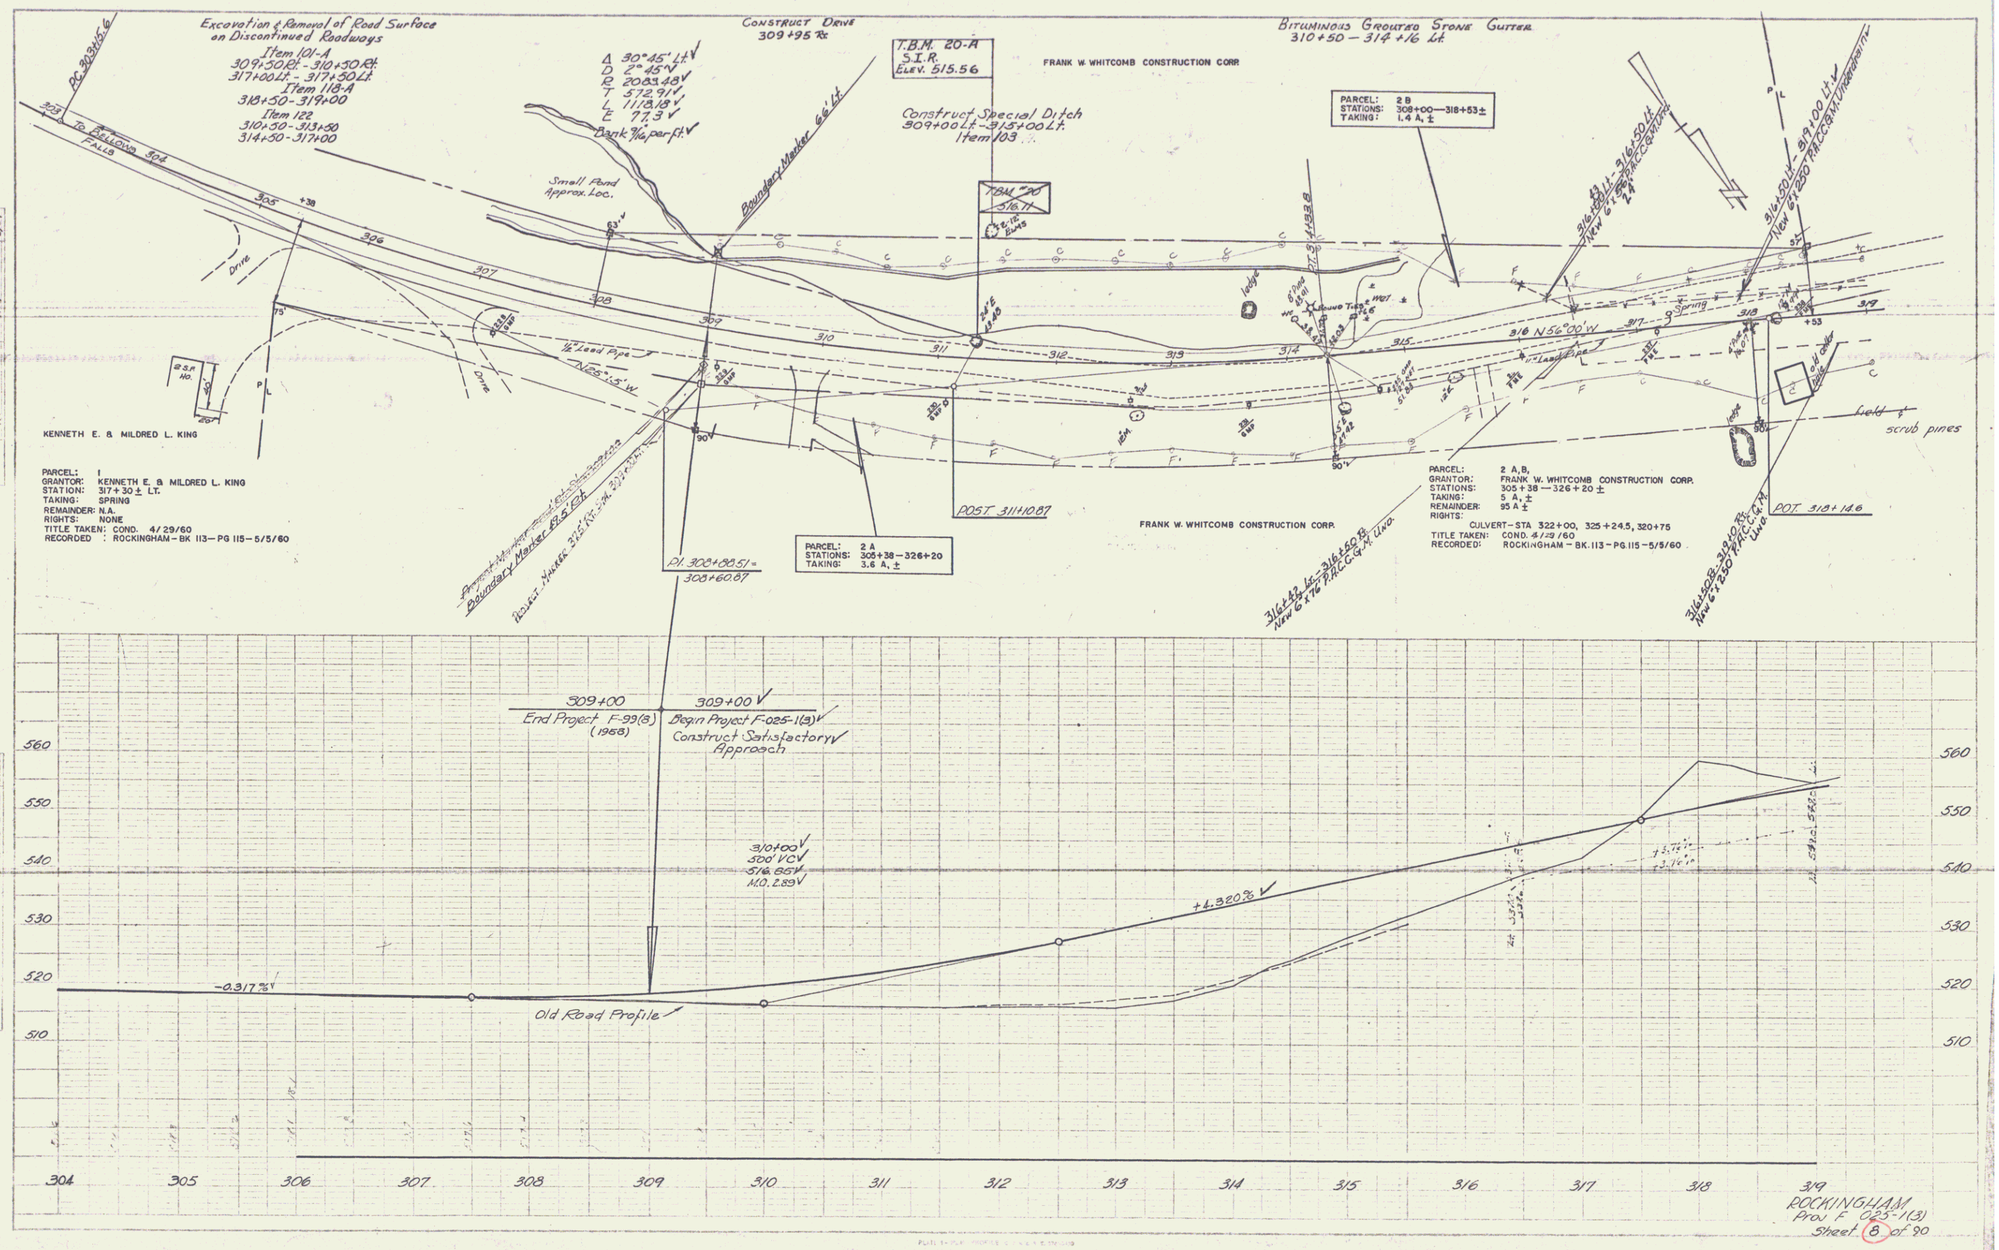
Excavation & Removal of Road Surface on Discontinued Roadways
Item 101-A
309+50 Rt. - 310+50 Rt.
317+00 Lt. - 317+50 Lt.
Item 118-A
318+50 - 319+00
Item 122
310+50 - 313+50
314+50 - 317+00
Construct Drive
309+95 Rt.
Δ 30°45' Lt.
D 2°45'
R 208.48
T 572.91
L 1118.18
E 77.3
Bank Wall per ft.
T.B.M. 20-A
S.I.R.
ELEV. 515.56
Construct Special Ditch
309+00 Lt. - 315+00 Lt.
Item 103
Bituminous Grouted Stone Gutter
310+50 - 314+16 Lt.
FRANK W. WHITCOMB CONSTRUCTION CORP.
PARCEL: 2 B
STATIONS: 308+00 — 318+53 ±
TAKING: 1.4 A. ±
To Bellows Falls
Small Pond Approx. Loc.
Boundary Marker 66' Lt.
Drive
1½" Lead Pipe
N65°15' W
KENNETH E. & MILDRED L. KING
PARCEL: 1
GRANTOR: KENNETH E. & MILDRED L. KING
STATION: 317+30 ± LT.
TAKING: SPRING
REMAINDER: N.A.
RIGHTS: NONE
TITLE TAKEN: COND. 4/29/60
RECORDED: ROCKINGHAM - BK 113 - PG 115 - 5/5/60
Boundary Marker 83.5' Rt.
Point Marker 315' Rt. 20' Rt.
PI 308+80.51 = 308+60.87
PARCEL: 2 A
STATIONS: 305+38 — 326+20
TAKING: 3.6 A. ±
POST 311+10.87
FRANK W. WHITCOMB CONSTRUCTION CORP.
316 N56°00'W
Spring
Field + scrub pines
PARCEL: 2 A, B,
GRANTOR: FRANK W. WHITCOMB CONSTRUCTION CORP.
STATIONS: 305+38 — 326+20 ±
TAKING: 5 A. ±
REMAINDER: 95 A ±
RIGHTS:
CULVERT - STA 322+00, 325+24.5, 320+75
TITLE TAKEN: COND. 6/12/60
RECORDED: ROCKINGHAM - BK. 113 - PG. 115 - 5/5/60
POT. 318+14.6
309+00
End Project F-99(8) (1958)
309+00
Begin Project F-025-1(3)
Construct Satisfactory Approach
310+00
500' VC
516.85
M.O. 2.89
+1.320%
-0.317%
Old Road Profile
560
550
540
530
520
510
304
305
306
307
308
309
310
311
312
313
314
315
316
317
318
319
ROCKINGHAM
Proj F 025-1(3)
Sheet 8 of 90
2