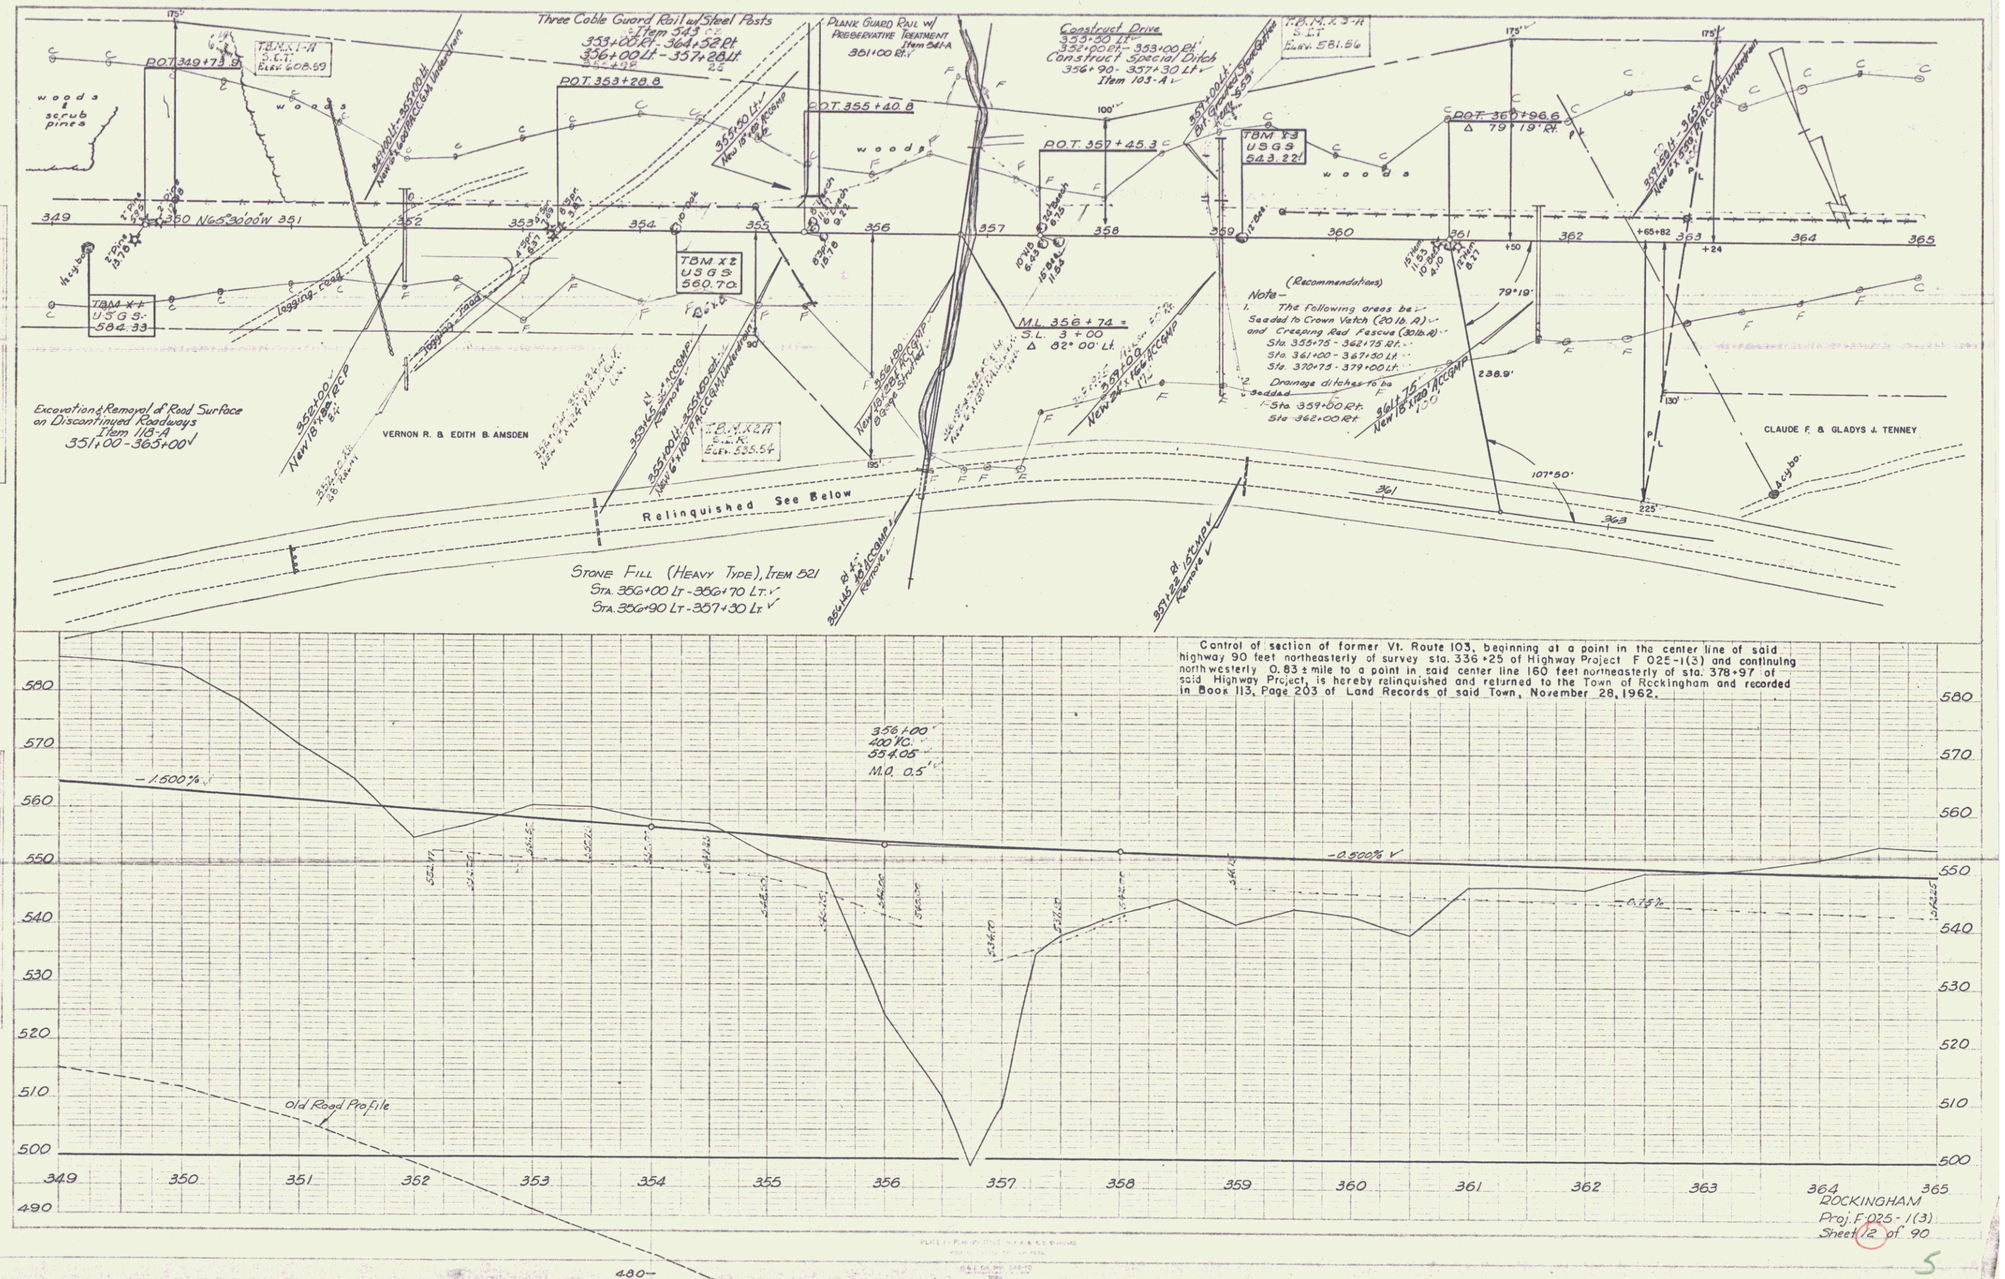

Control of section of former Vt. Route 103, beginning at a point in the center line of said highway 90 feet northeasterly of survey sta. 336+25 of Highway Project F 025-1(3) and continuing northwesterly 0.83 ± mile to a point in said center line 160 feet northeasterly of sta. 378+97 of said Highway Project, is hereby relinquished and returned to the Town of Rockingham and recorded in Book 113, Page 203 of Land Records of said Town, November 28, 1962.

ROCKINGHAM
Proj. F 025-1(3)
Sheet 12 of 90

5