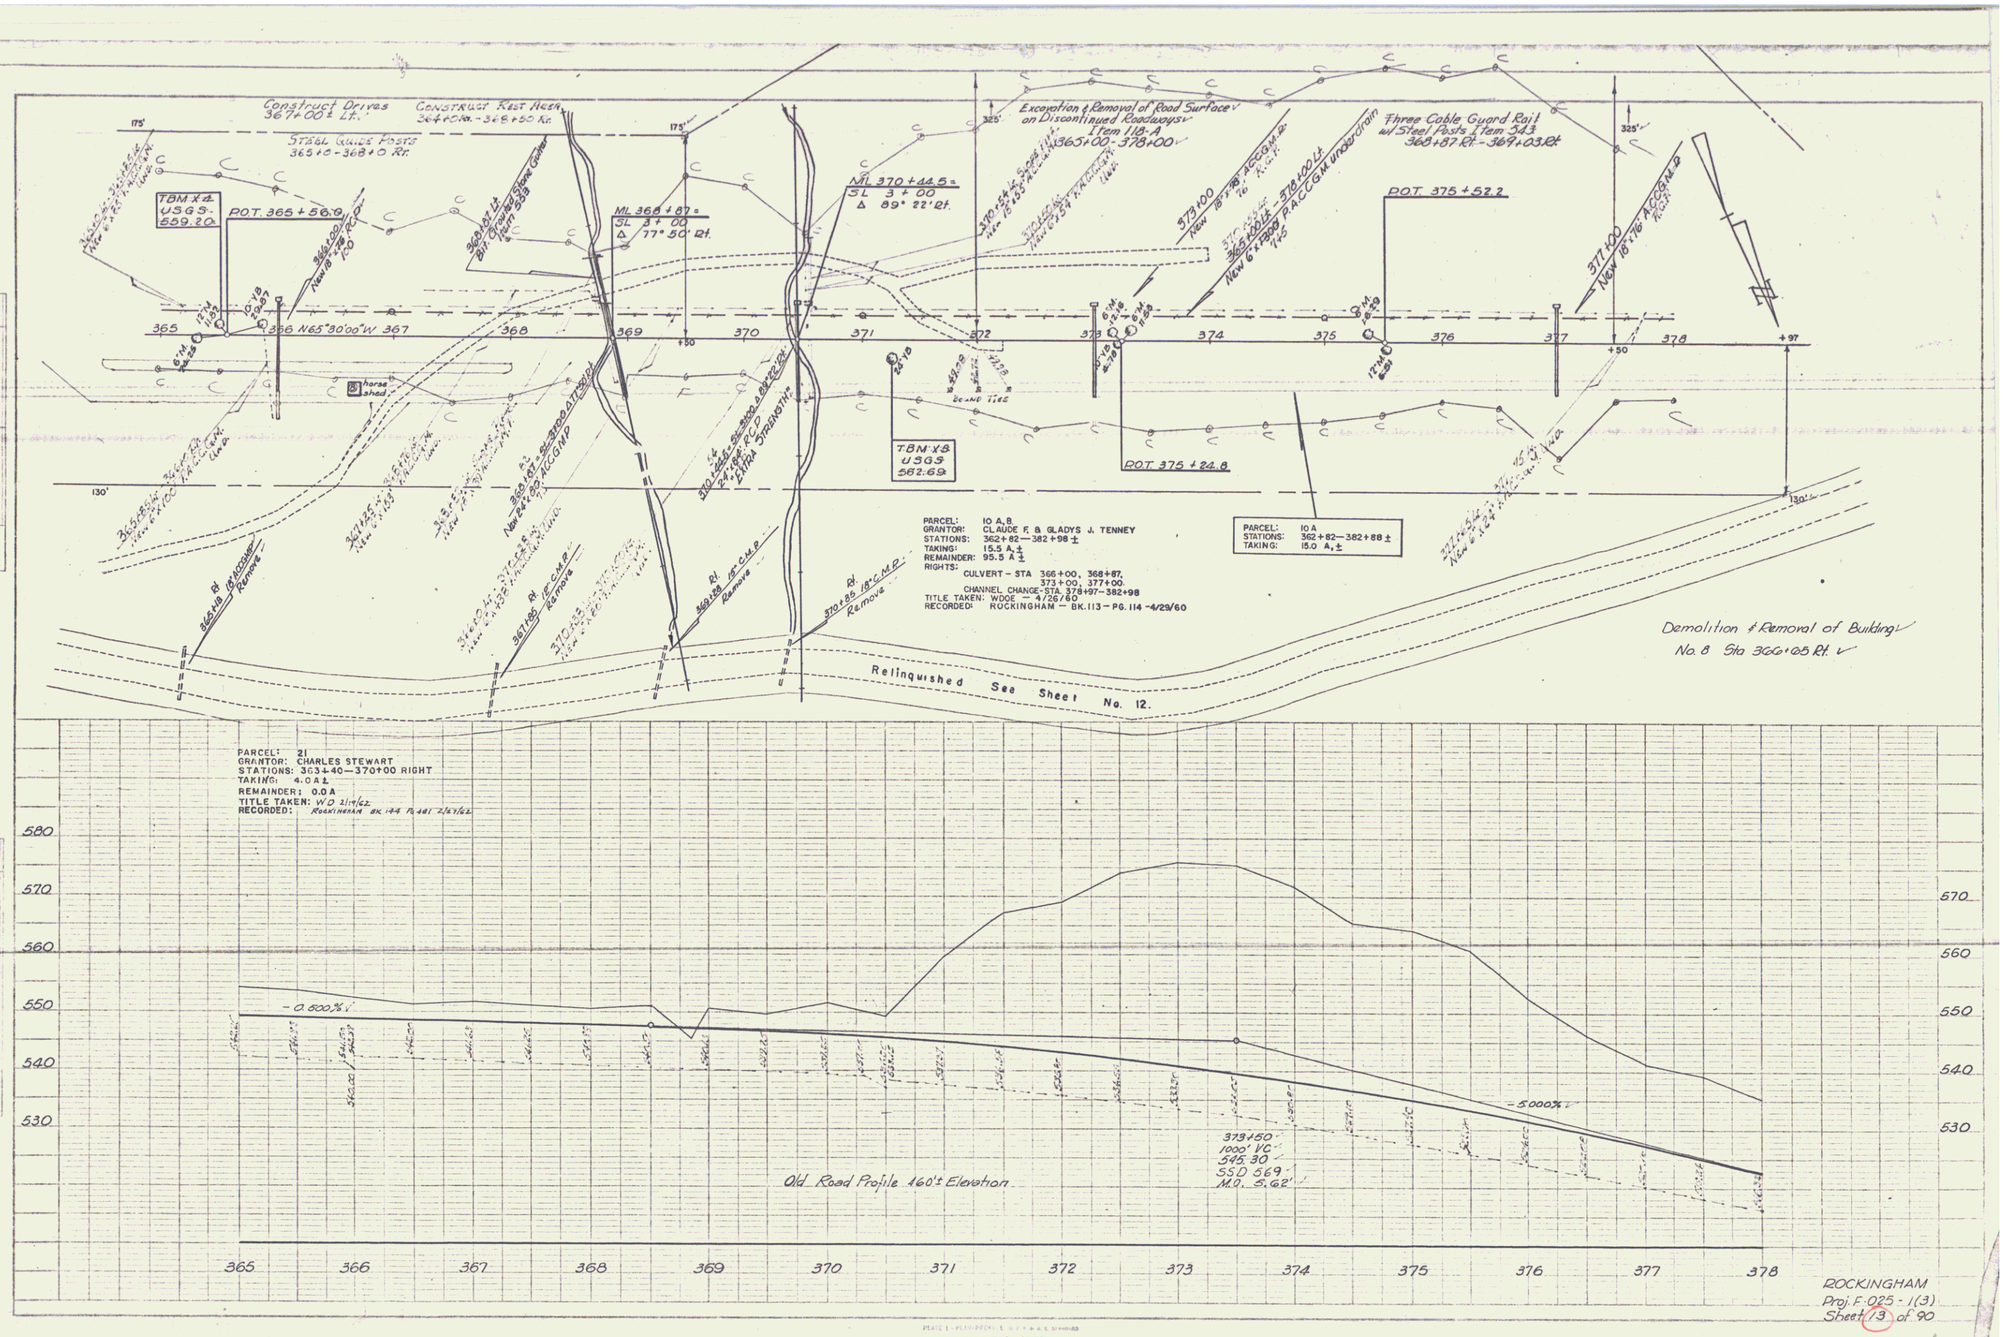
Construct Drives 367+00± Lt.
Construct Rest Area 364+00 Rt. - 368+50 Rt.
Steel Guide Posts 365+0 - 368+0 Rt.
Excavation & Removal of Road Surface on Discontinued Roadways Item 118-4 365+00 - 378+00
Three Cable Guard Rail w/ Steel Posts Item 34.3 368+87 Rt. - 369+03 Rt.
TBM X4 USGS 559.20
POT. 365 + 56.0
ML 368 + 87 = SL 3 + 00 Δ 77° 50' Rt.
ML 370 + 44.5 = SL 3 + 00 Δ 89° 22' Rt.
POT. 375 + 52.2
POT. 375 + 24.6
TBM X8 USGS 562.69
365 N65°30'00"W 367 368 369 370 371 372 373 374 375 376 377 378
+50 +97
horse shed
Relinquished See Sheet No. 12.
Demolition & Removal of Building No. 8 Sta 366+05 Rt.
PARCEL: 10 A, B
GRANTOR: CLAUDE F. & GLADYS J. TENNEY
STATIONS: 362+82—382+98 ±
TAKING: 15.5 A. ±
REMAINDER: 95.5 A ±
RIGHTS: CULVERT - STA 366+00, 368+87, 373+00, 377+00.
CHANNEL CHANGE - STA. 378+97 - 382+98
TITLE TAKEN: WDOE — 4/26/60
RECORDED: ROCKINGHAM — BK. 113 - PG. 114 - 4/29/60
PARCEL: 10 A
STATIONS: 362+82—382+88 ±
TAKING: 15.0 A. ±
PARCEL: 21
GRANTOR: CHARLES STEWART
STATIONS: 363+40—370+00 RIGHT
TAKING: 4.0 A ±
REMAINDER: 0.0 A
TITLE TAKEN: W.D. 2/19/62
RECORDED: ROCKINGHAM BK 134 PG 481 2/26/62
580 570 560 550 540 530
-0.500%
-5.000%
373+50
1000' VC
545.30
SSD 569
M.O. 5.62'
Old Road Profile 160's Elevation
365 366 367 368 369 370 371 372 373 374 375 376 377 378
ROCKINGHAM
Proj. F-025-1(3)
Sheet 13 of 90

6